



GRUNNMYND • 1 : 50

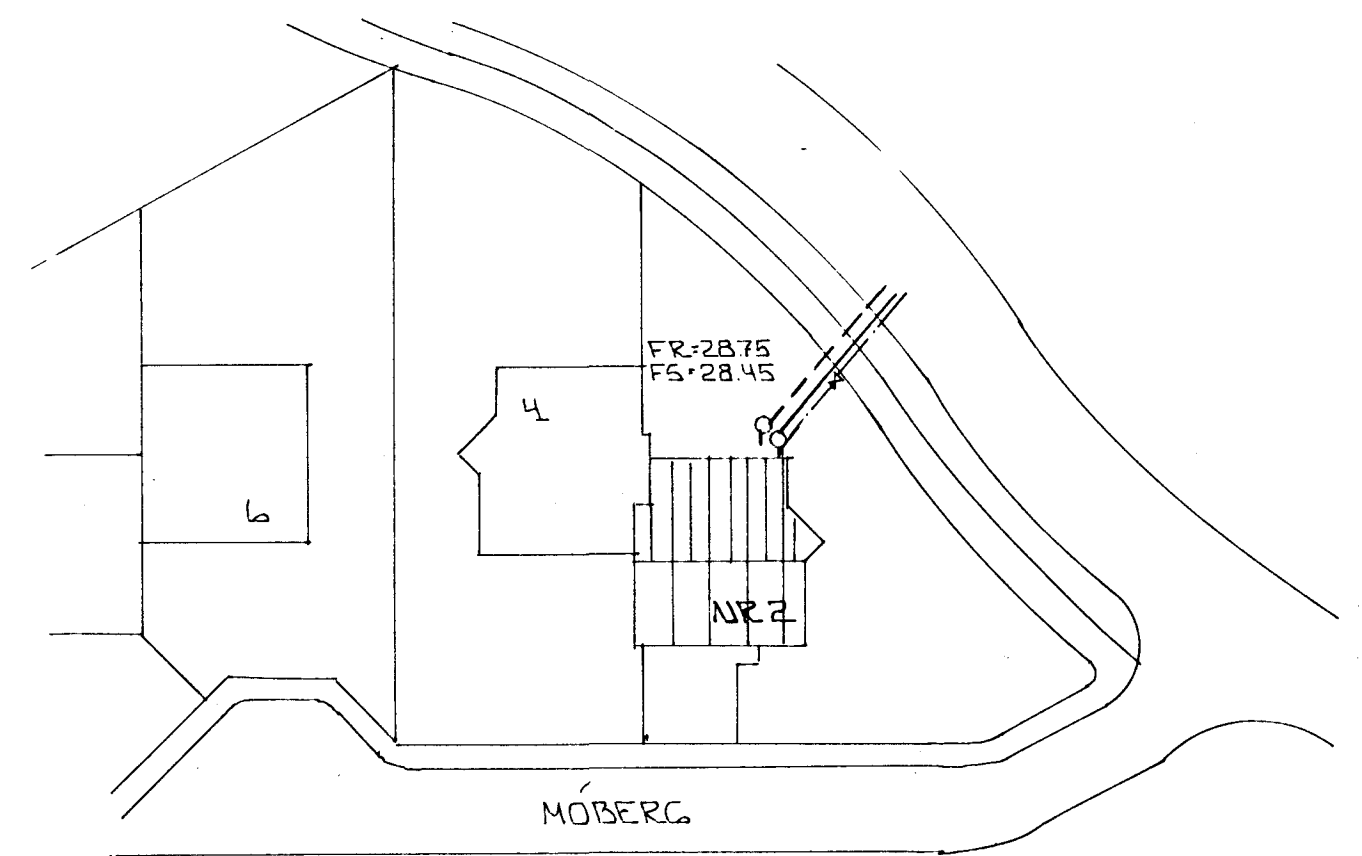

AFSTÖÐLIMYND • 1 : 500

13 AUG 1991

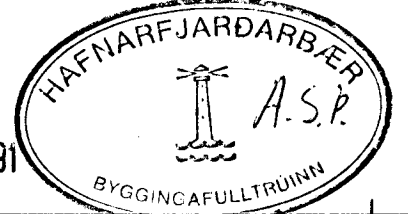

 HAFNARFJARDARBER
 A.S.P.
 BYGGINGAFULLTRÚINN

01	6 AUGUST 91	JARÐVATNSLÖGNG LENGD	
BR.NR.	DAGS	EDLI BREVTINGAR	SIGN.
MÓBERG 2 HAFNARFIRÐI			DAGS JÚNÍ 91
GRUNNMYND - GRUNNLACNA			HANNAÐ <i>AK</i>
MELIKV. • 1 : 50 • 1 : 500			TEIKNAR <i>AK</i>
SIGURÐUR ÞORLEIFSSON TEKNIFRÆÐINGUR F.T.F.I.			VERK NR. 9129
STRANDGÖTU 11 HAFNARFIRÐI SÍMI 54751/54255			BLAD NR. 2-02