

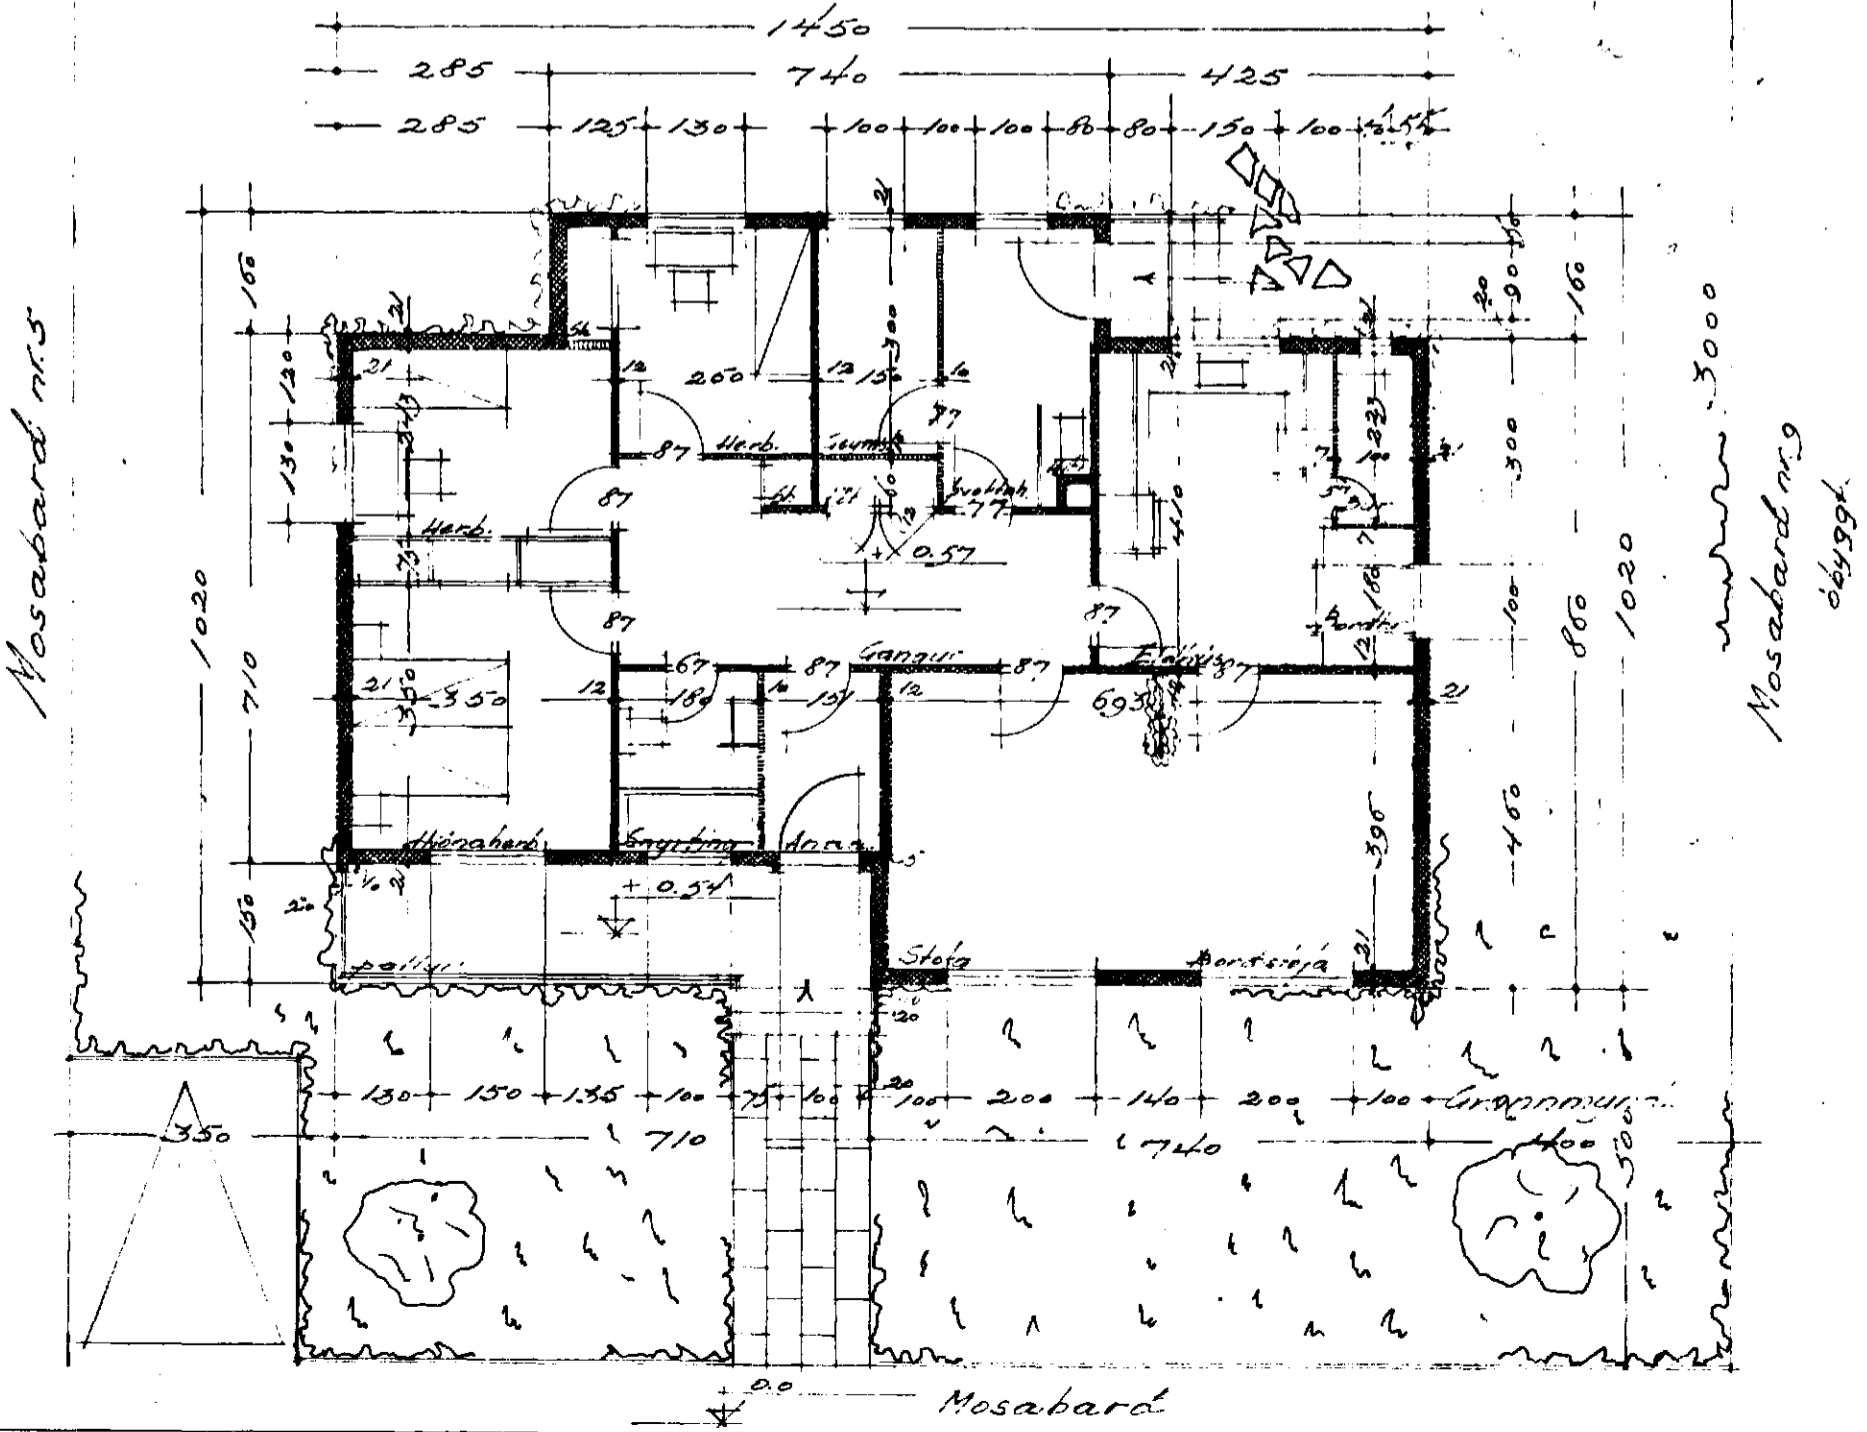
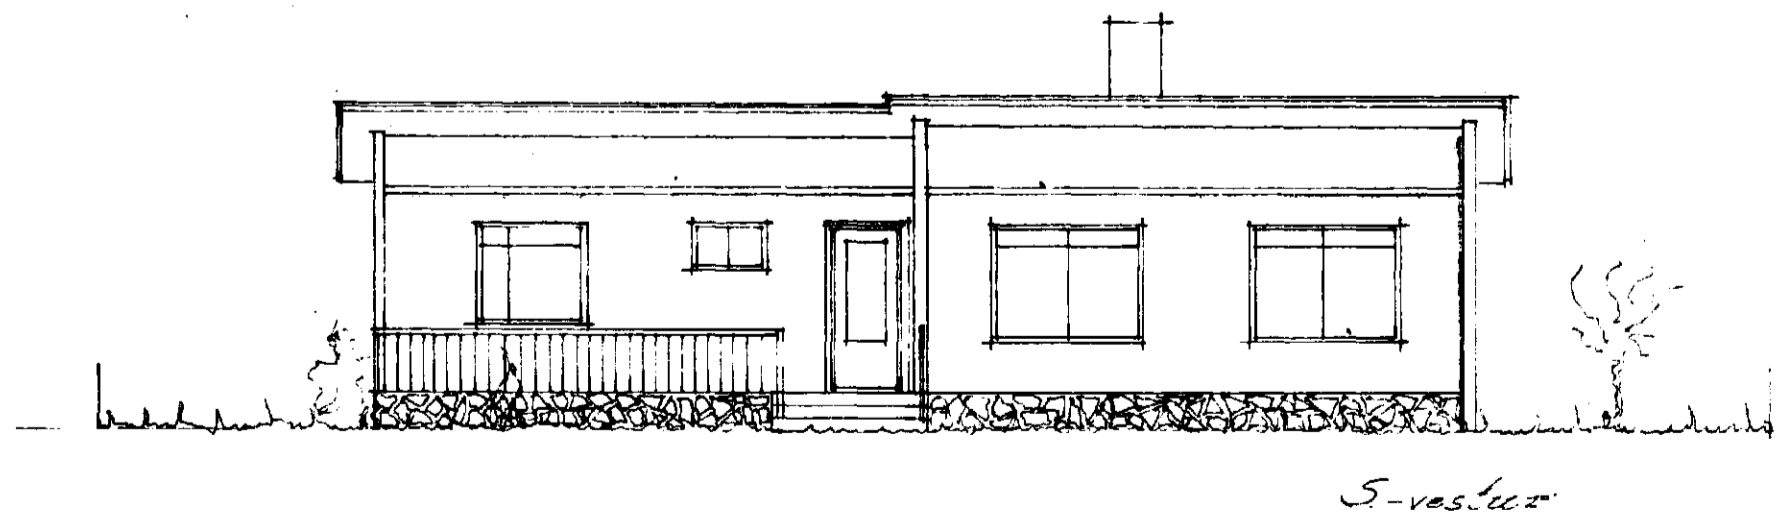
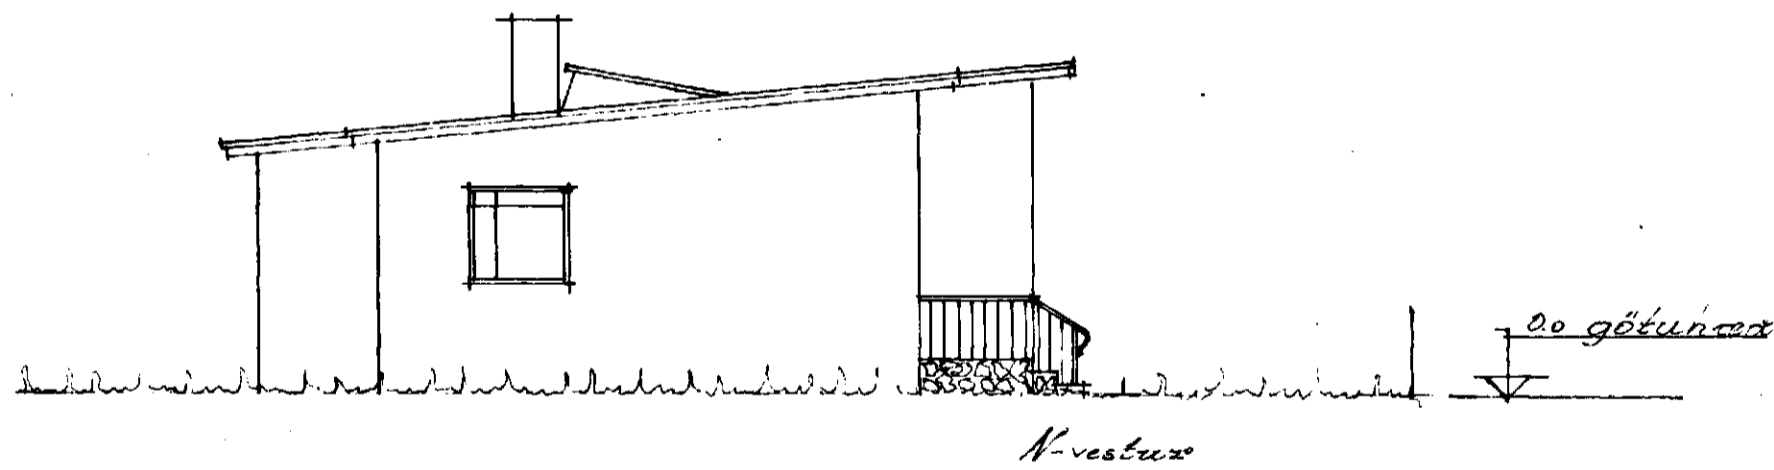
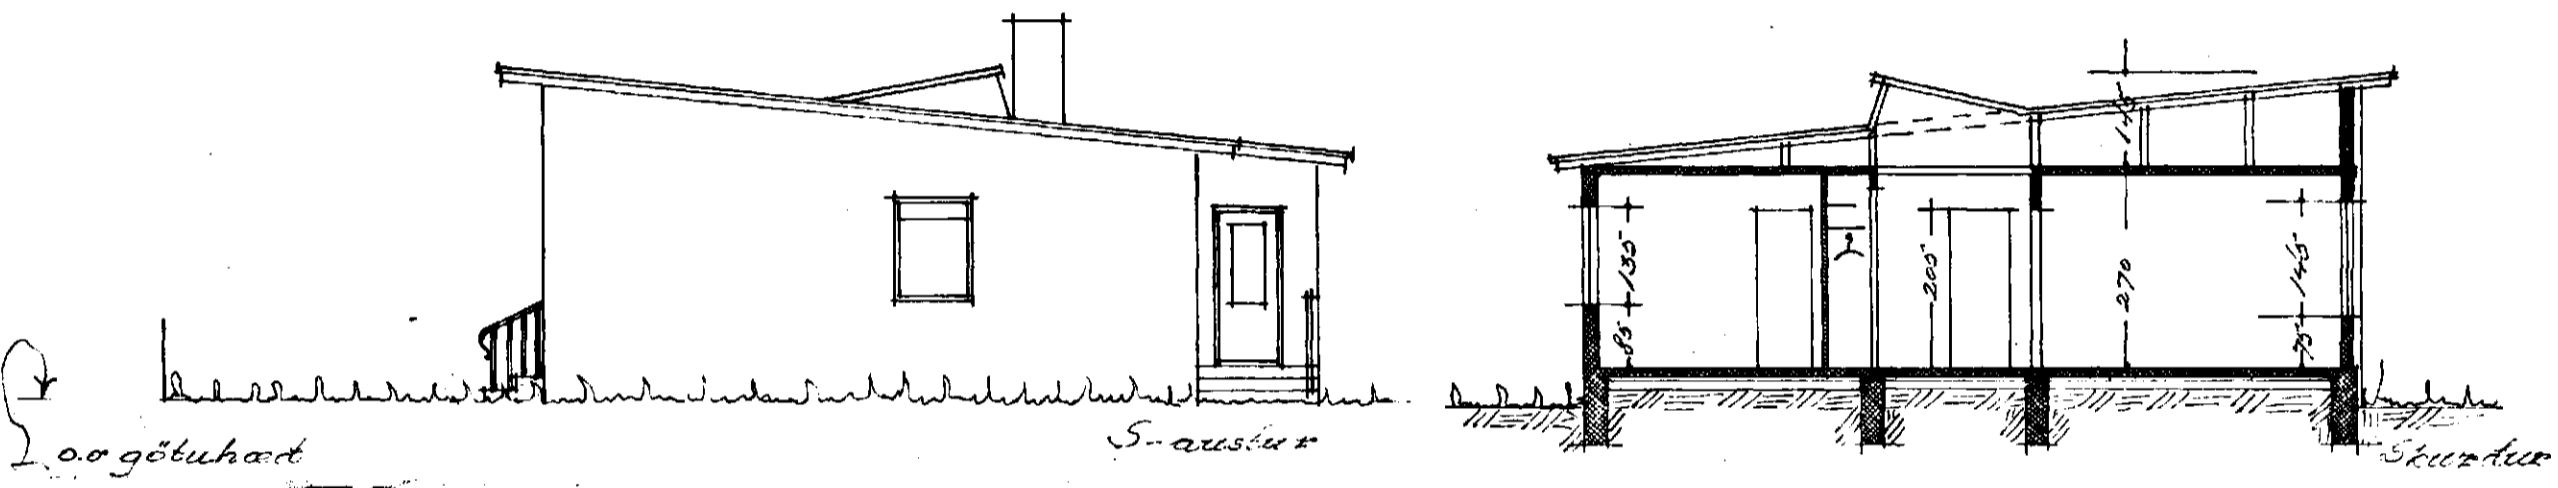
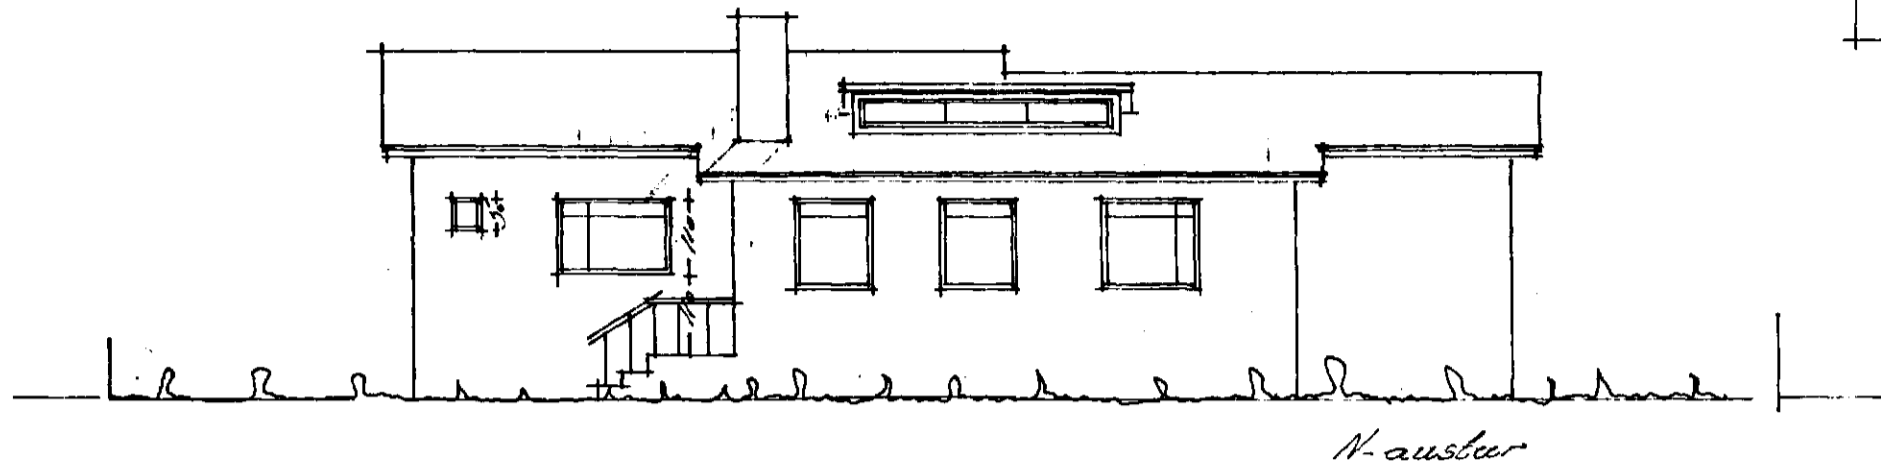


Mosabard nr 7, Hátrastírdi m.k.s. 1.100

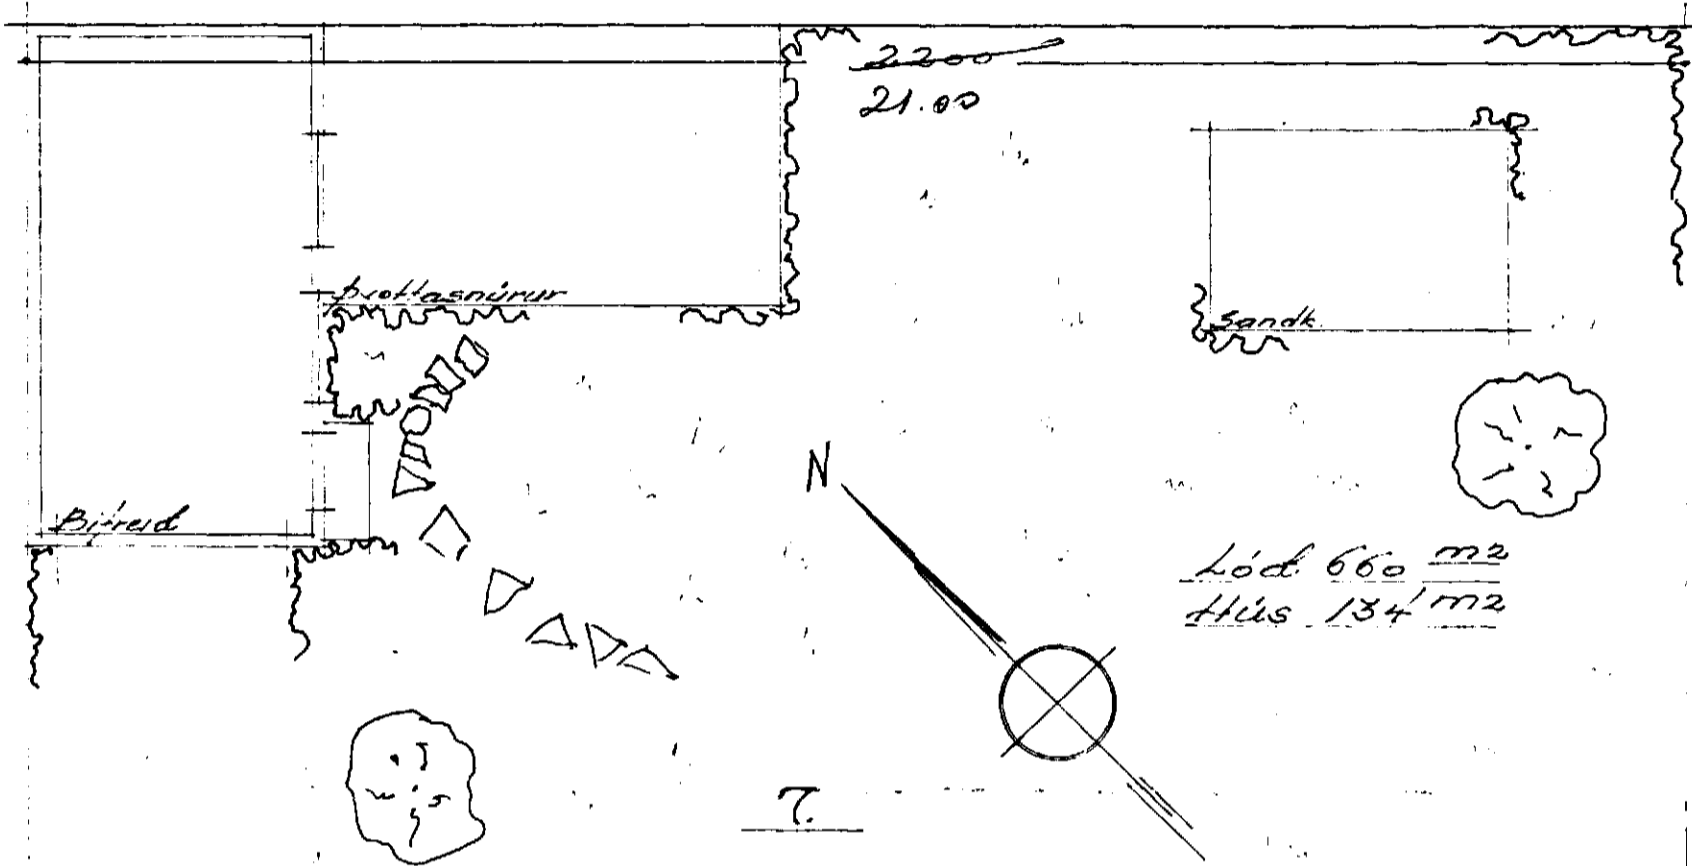

Stofudomin Jónsson
 Flúðakonin
 Sveinur Jónsson
 Mivaraameistari
 Sp 22/6'59

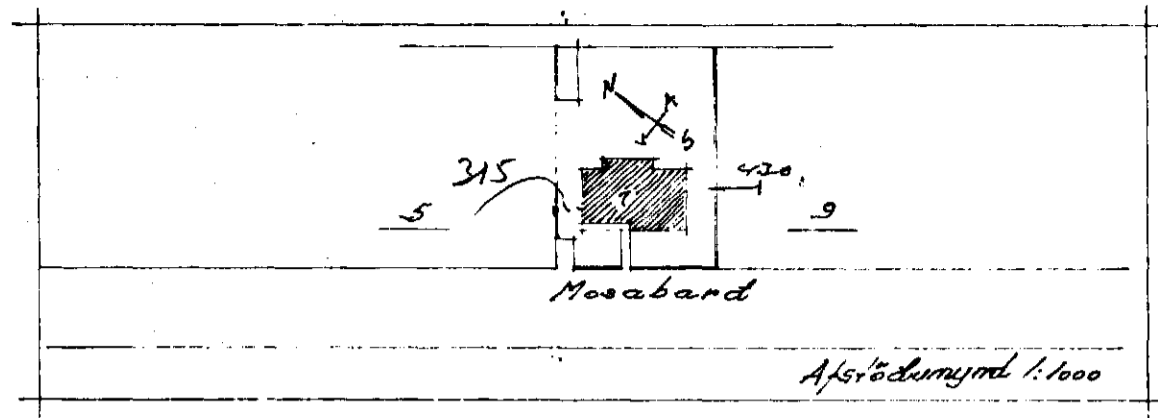

Hátrastírdi 196 1959
 Stofudomin