
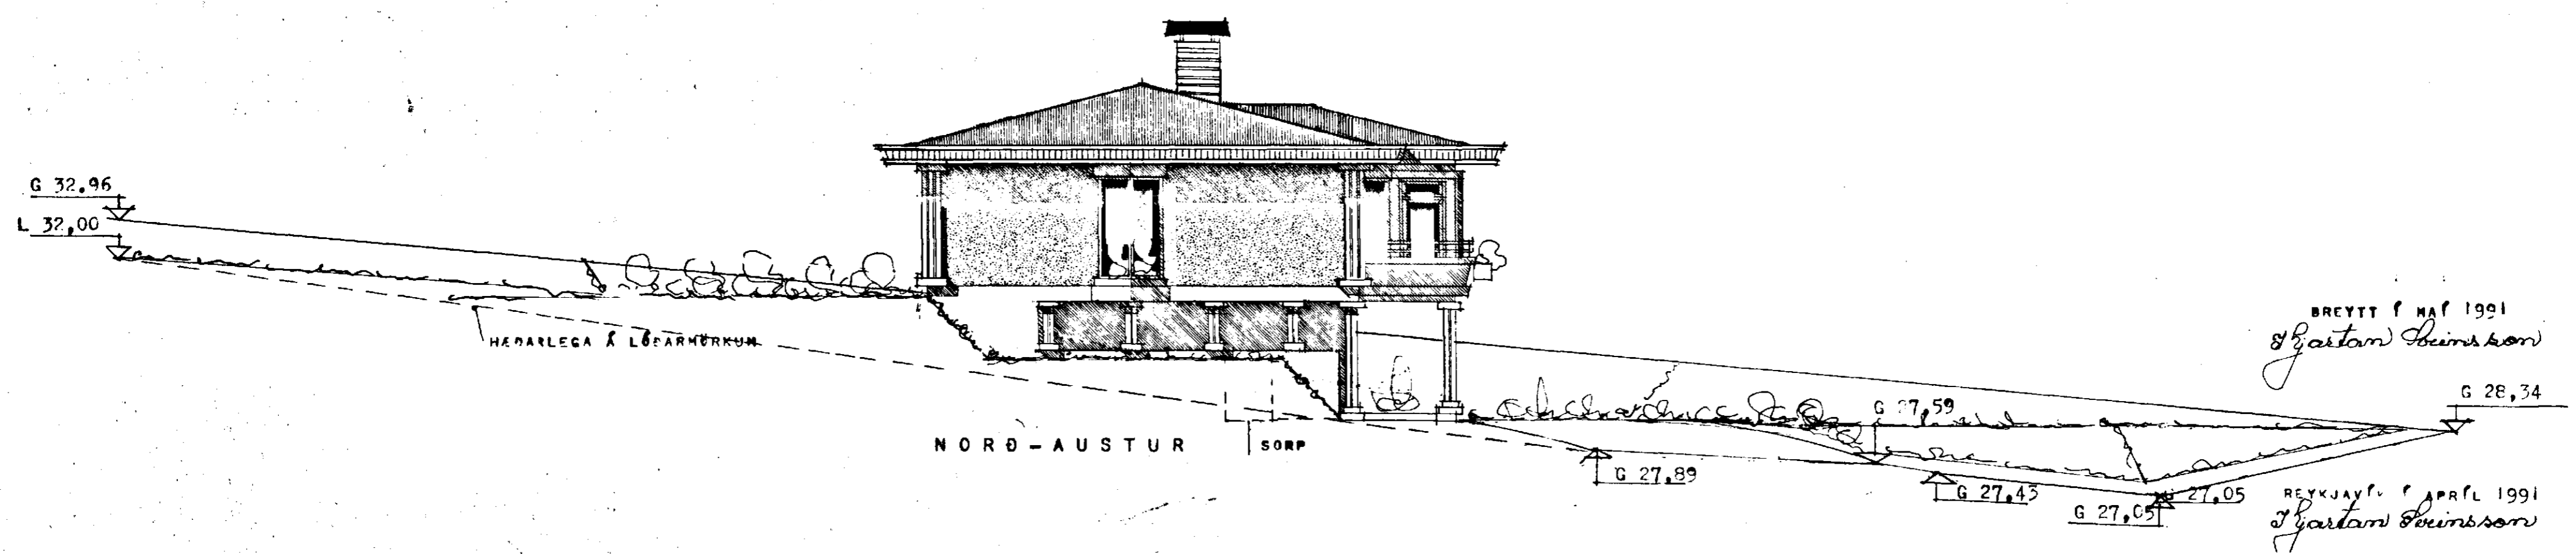
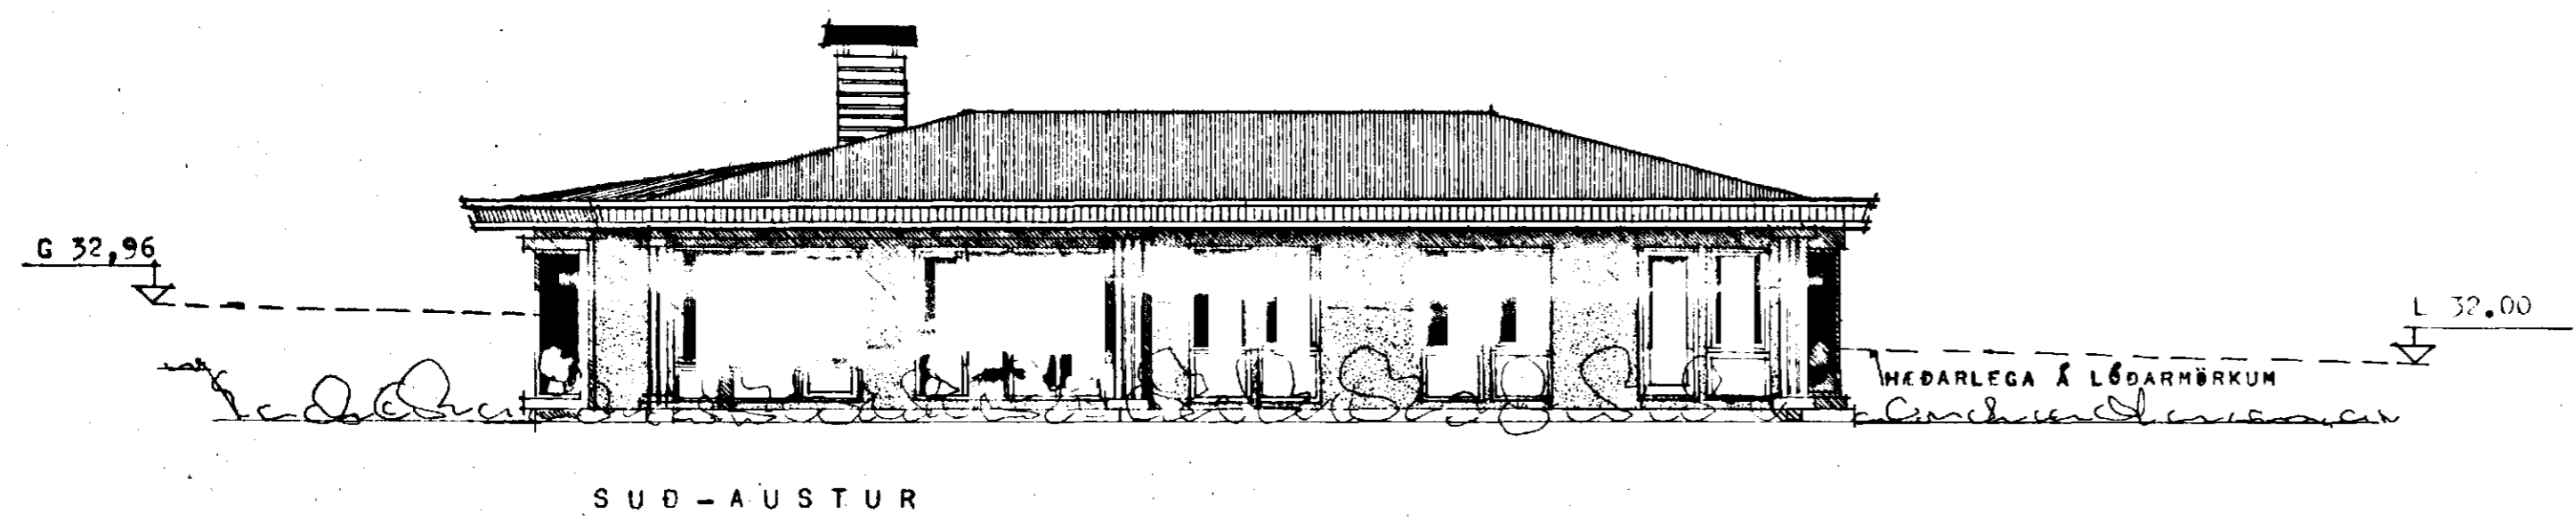
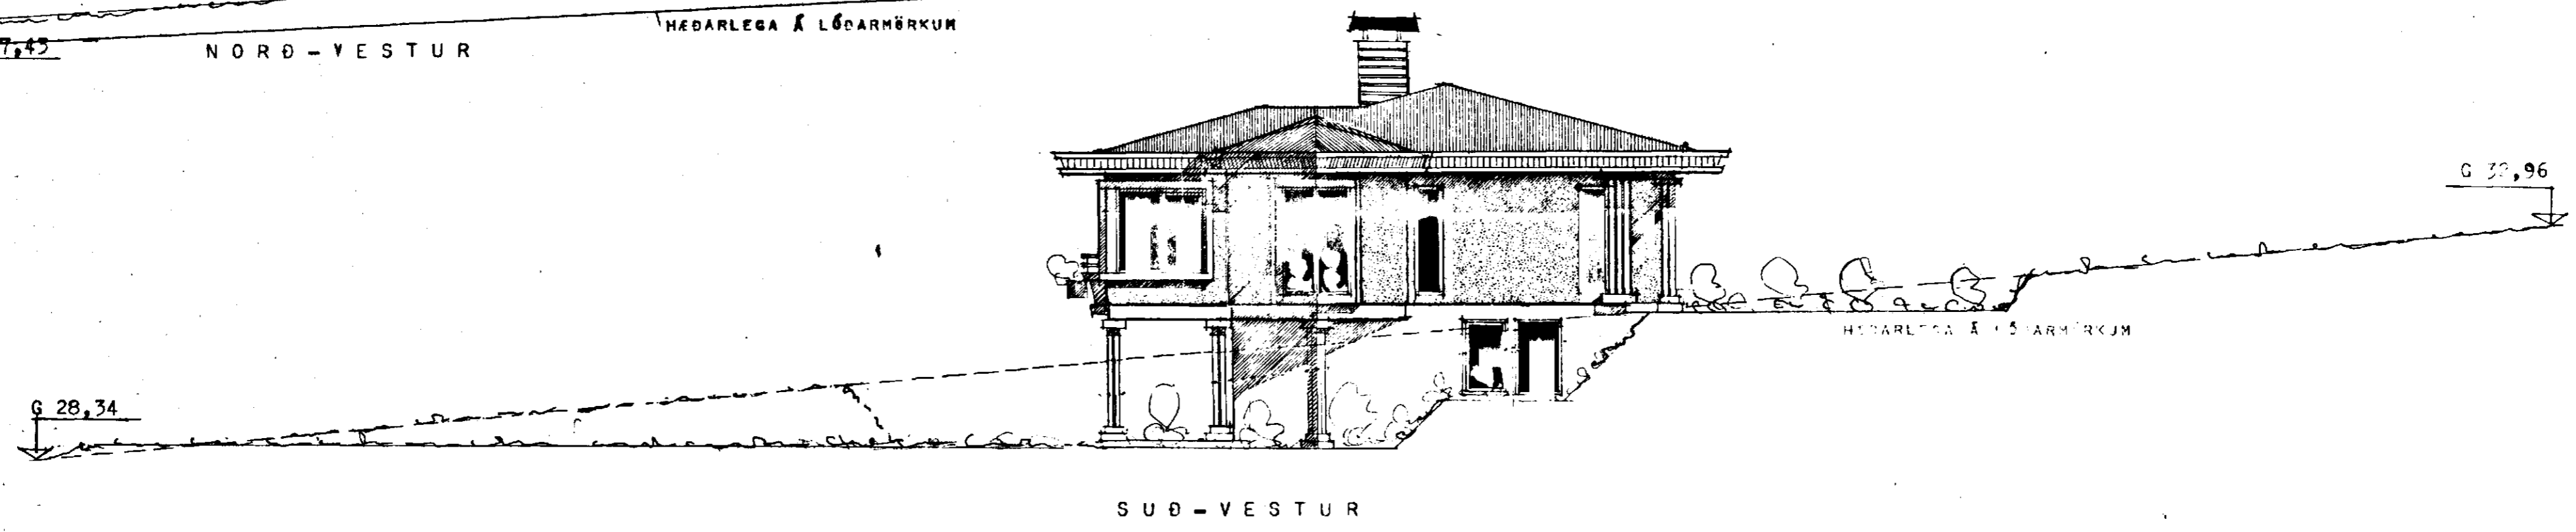


Sambýlt á fundi bygginga-  
nefndar þ. 3. 6. 1991

BYGGINGAFAULLTÖÐIRN  
HAFNARFIRÐI

*[Handwritten signature]*

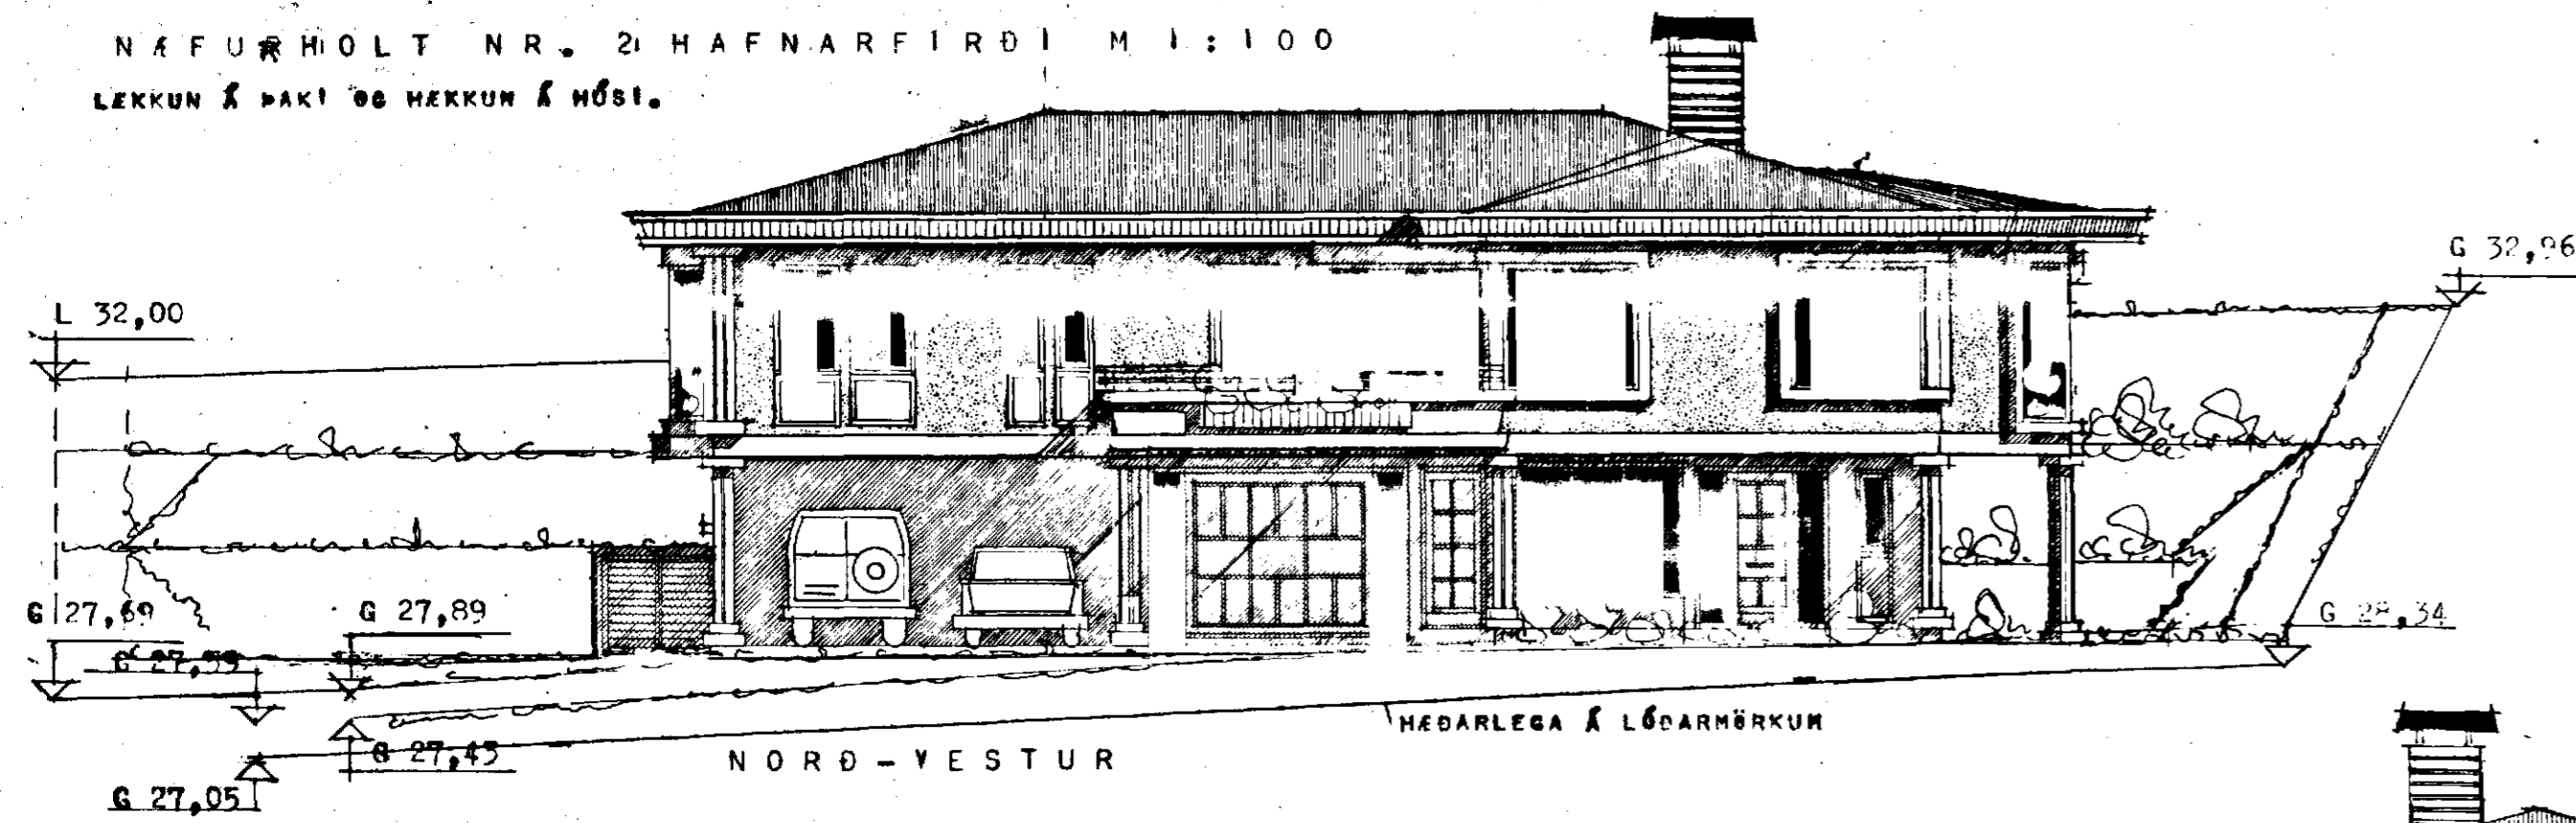

BREYTT 1 MAÍ 1991  
*[Handwritten signature]*

REYKJAVÍK 1 APRÍL 1991  
*[Handwritten signature]*