


AFSTAÐA 1:500

23 JUL 1991

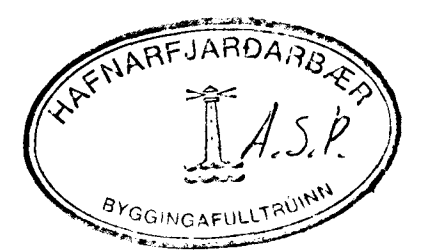

12/7/91	GÖLFKÖTI HEKKADUR 0.40 m.		J3
DAGS	BREYTING		GUORT
HANNAÐ	JÓN BERGSSON	VERKFR. VERKFRÆÐIHÖNNUN	BLAD
TEIKNAD	DIPL. ING.	M.V.F.I. SMÁRAHVAMMI 4, HAFNARF. S. 51974	2
YFIRFARID	SAMBYKKT	NÆFURHOLT 2	
J3	J3	M=1:50	
J3	VERK	HOLRÆSI Í GRUNNI	
			DAGS MAI'91