




Samantekt 6. liðu
 neindar p. 18/10.72
BYGGINGAFLYTTING
Í HAFNARFIRDI
[Signature]

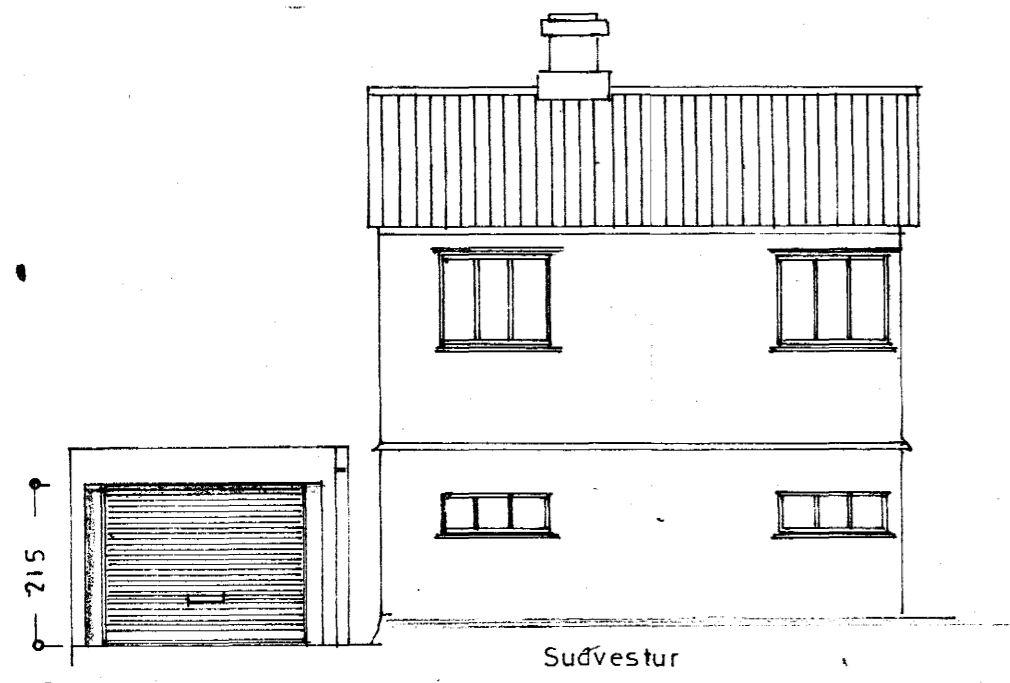


Sudvestur

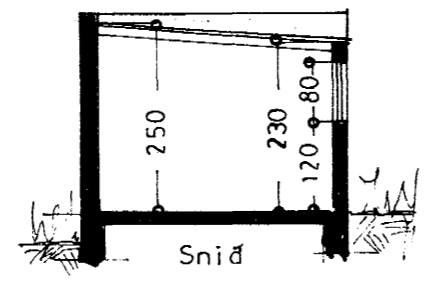

Snid

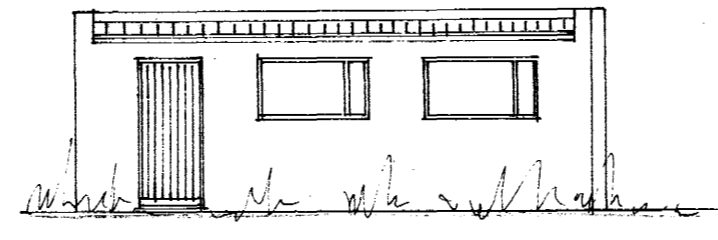


Sudaustur

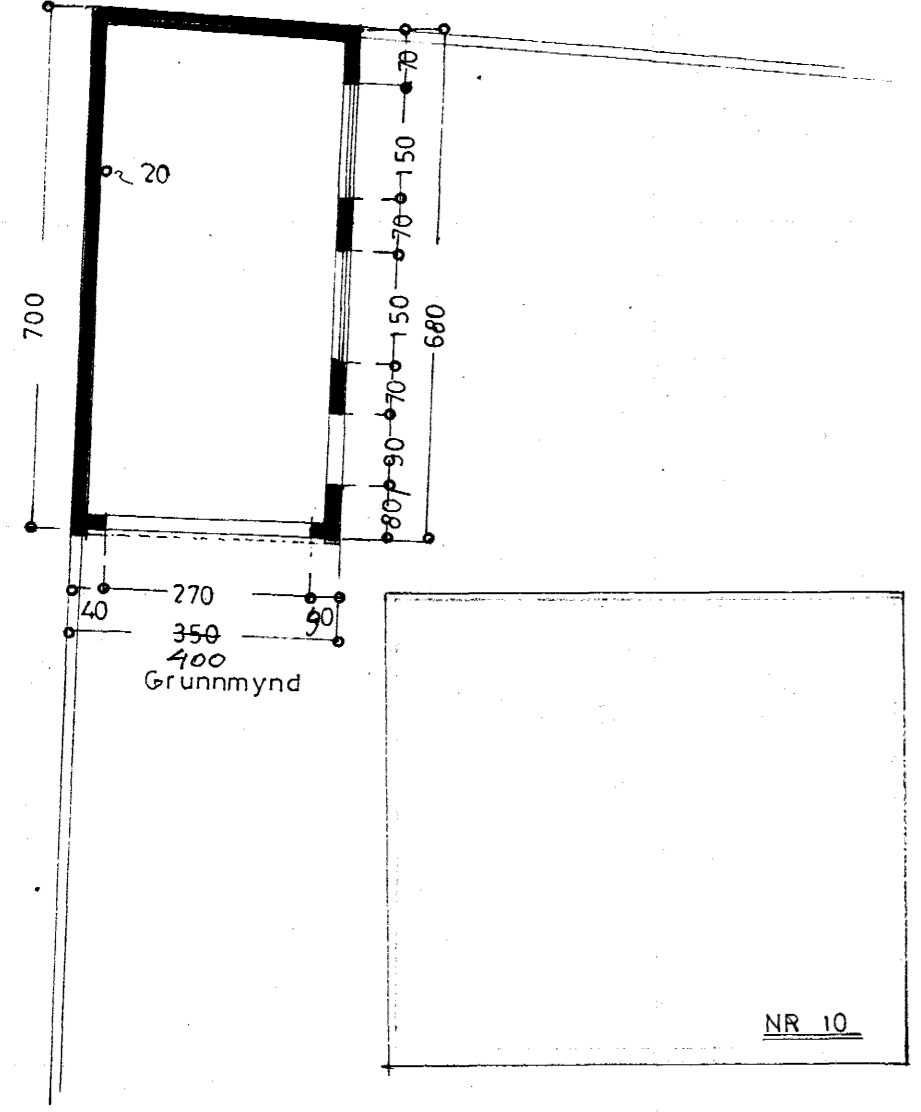


Grunnmynd


NR 10

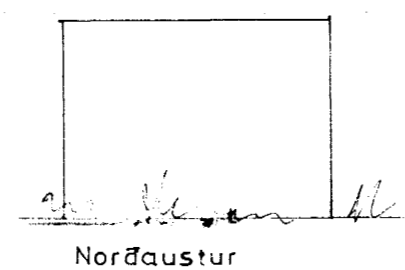

Norðaustur

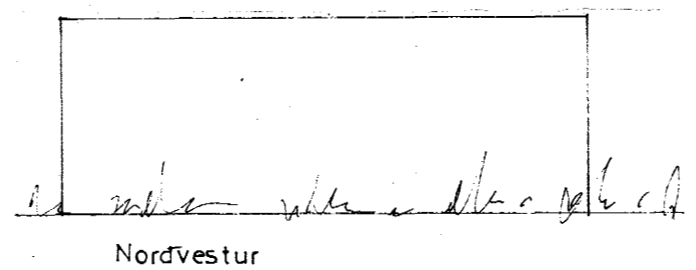

Nordvestur

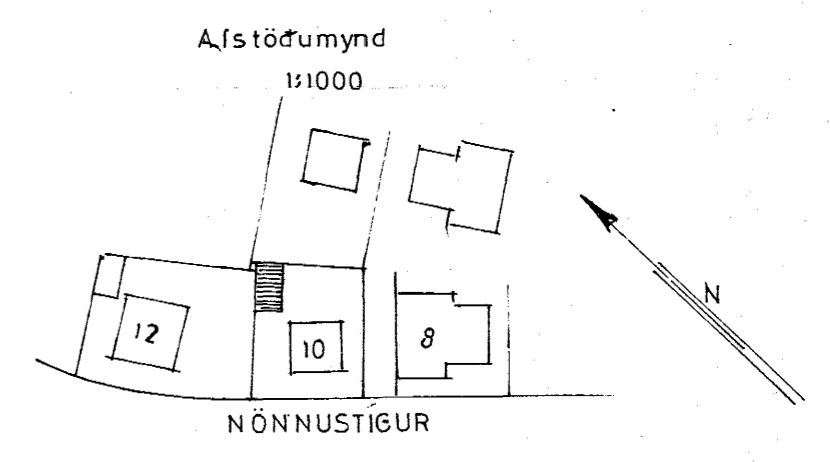

AFSTÖBUMYND
1:1000

NÖNNUSTÍGUR

276 660
 STÆRD : 24,1 m² 58,0 m³

NÖNNUSTÍGUR NR.10

BILGEYMSLA

ÚTLIT }
 GRUNNMYND } 1:100
 SNID }
 AFSTÖBUMYND : 1:1000

Hafnarbroti 5. október 1972

[Signature]