


AFSTÖÐUMYND 1:500

STÁLLAGNIR I JÖRD MED URETHANEINANGRUN OG PLASTKÁPU UTANUM. KALT OG HEITT NEYSLUVATN 25 MM FRAM- OG BAKRENNSLI HITAVEITU 20 MM

KALDAVATNSHEIMÆÐ Ø32 PEH

NIDURFALL I PLANI MED SANDFANGI

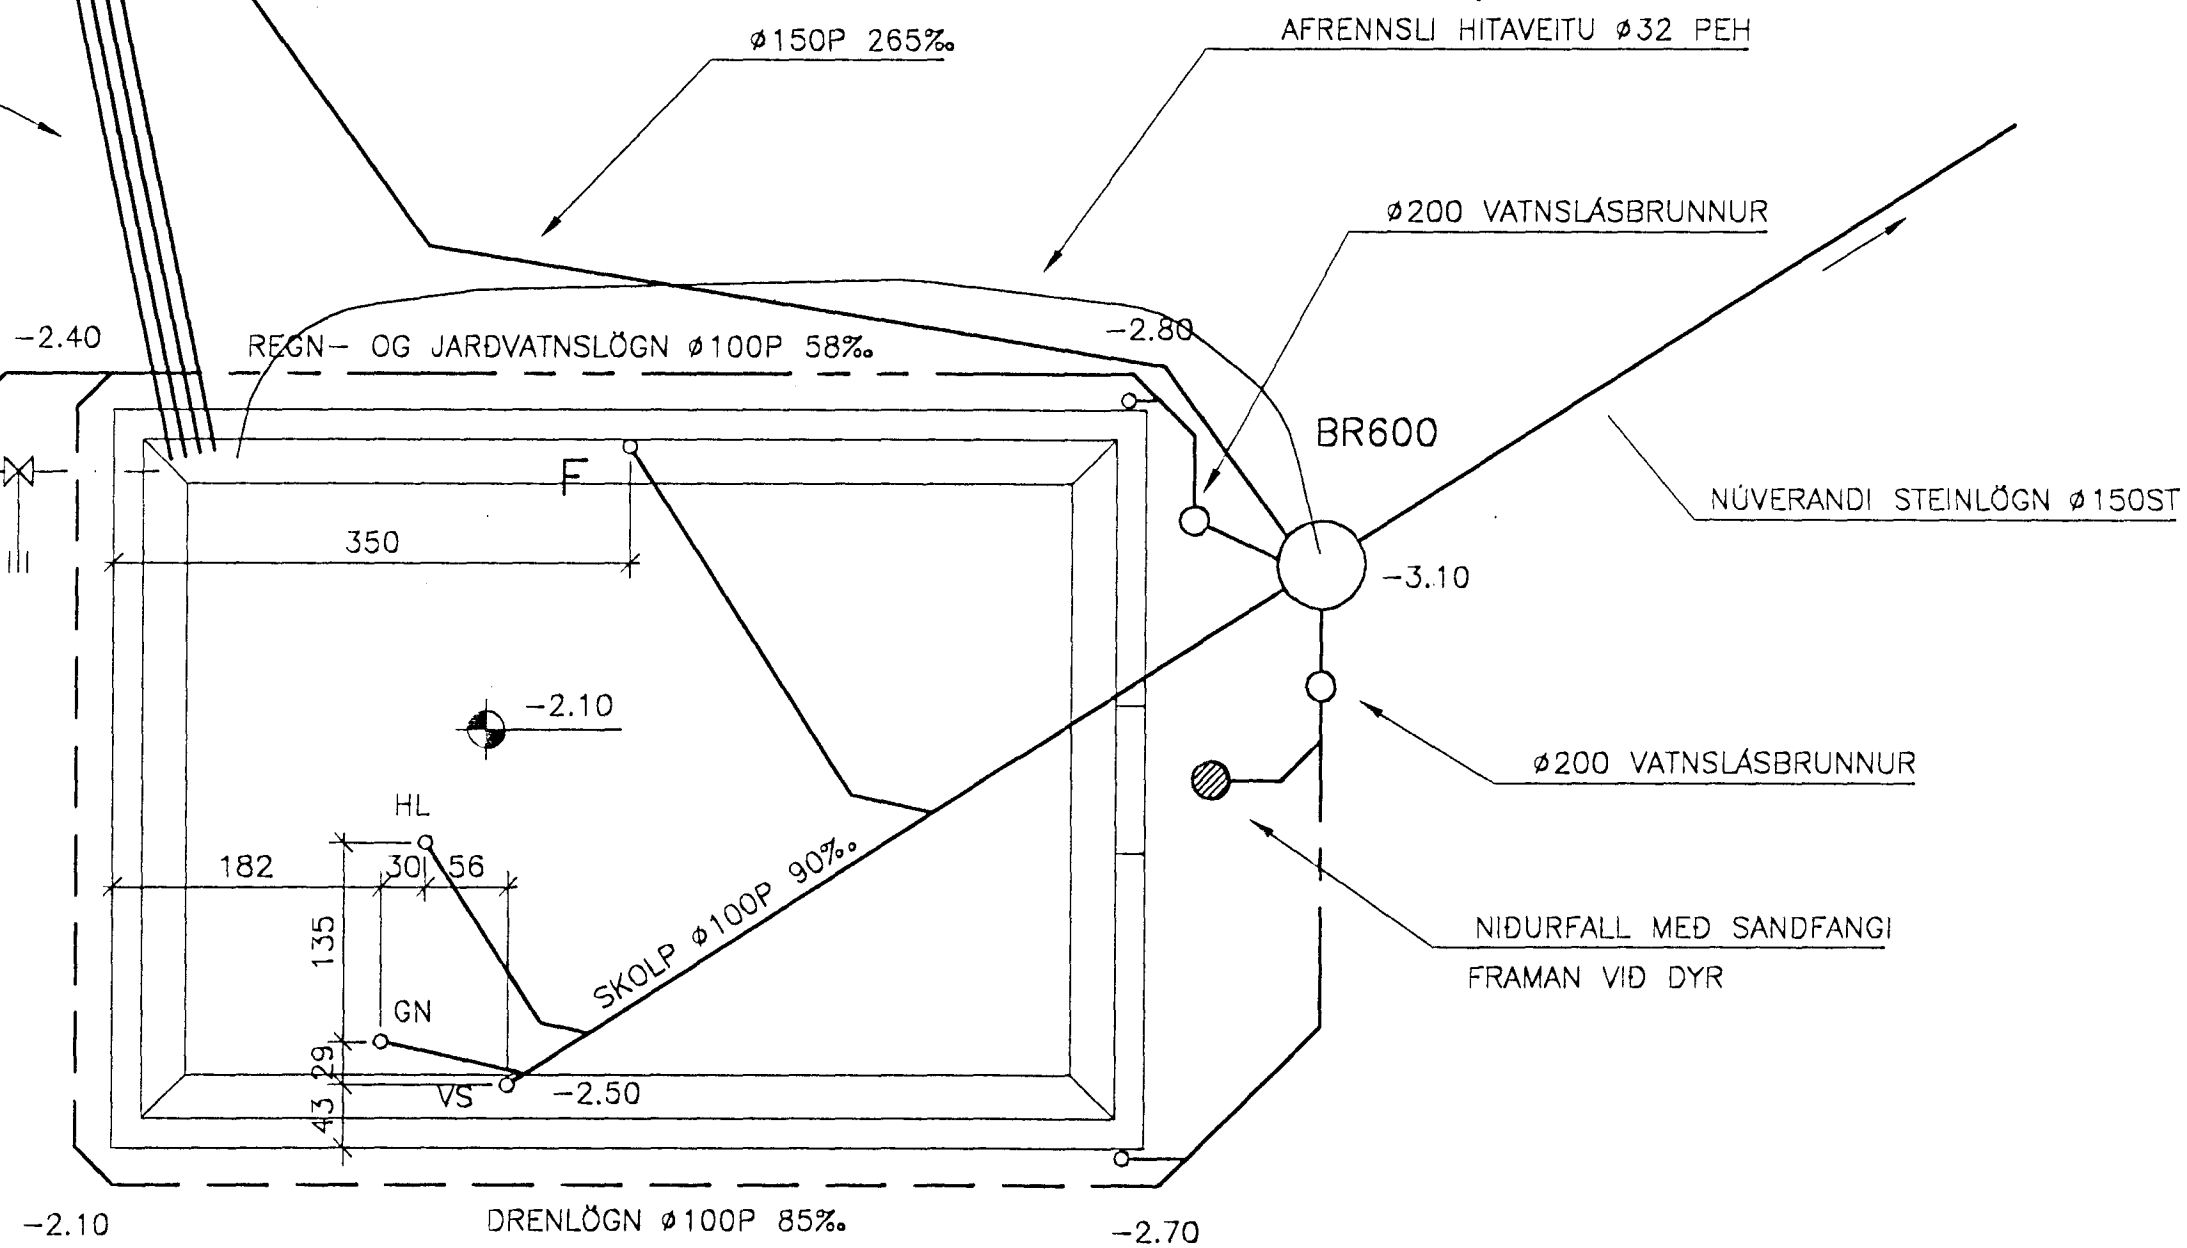

GRUNNLAGNIR 1:50

24/7 1996.
 AKA með KV.
 ER NÚ ÞEGAR MEÐ.
 KV - HEIMÆÐ.
 Sigbjörn

NORDURBRAUT 27B		HAFNARFIRÐI		KVARDI 1:50	TEIKNINR.
BILSKÜR				1:500	BLAD NR. L-01
GRUNNLAGNIR					
HANNAD: KMD	TEIKNAD: KMD	YFIRFARID:	DAGS.: JULI 1996		
SAMPYKKT: <i>Þórunn Veiðis</i>			KT.: 130257-2409		

