
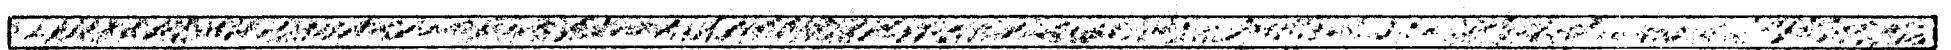


HAFNARFJARDARBER
 BYGGINGARULLFRUINN
 Simi: 54751
 20. ág. 1982

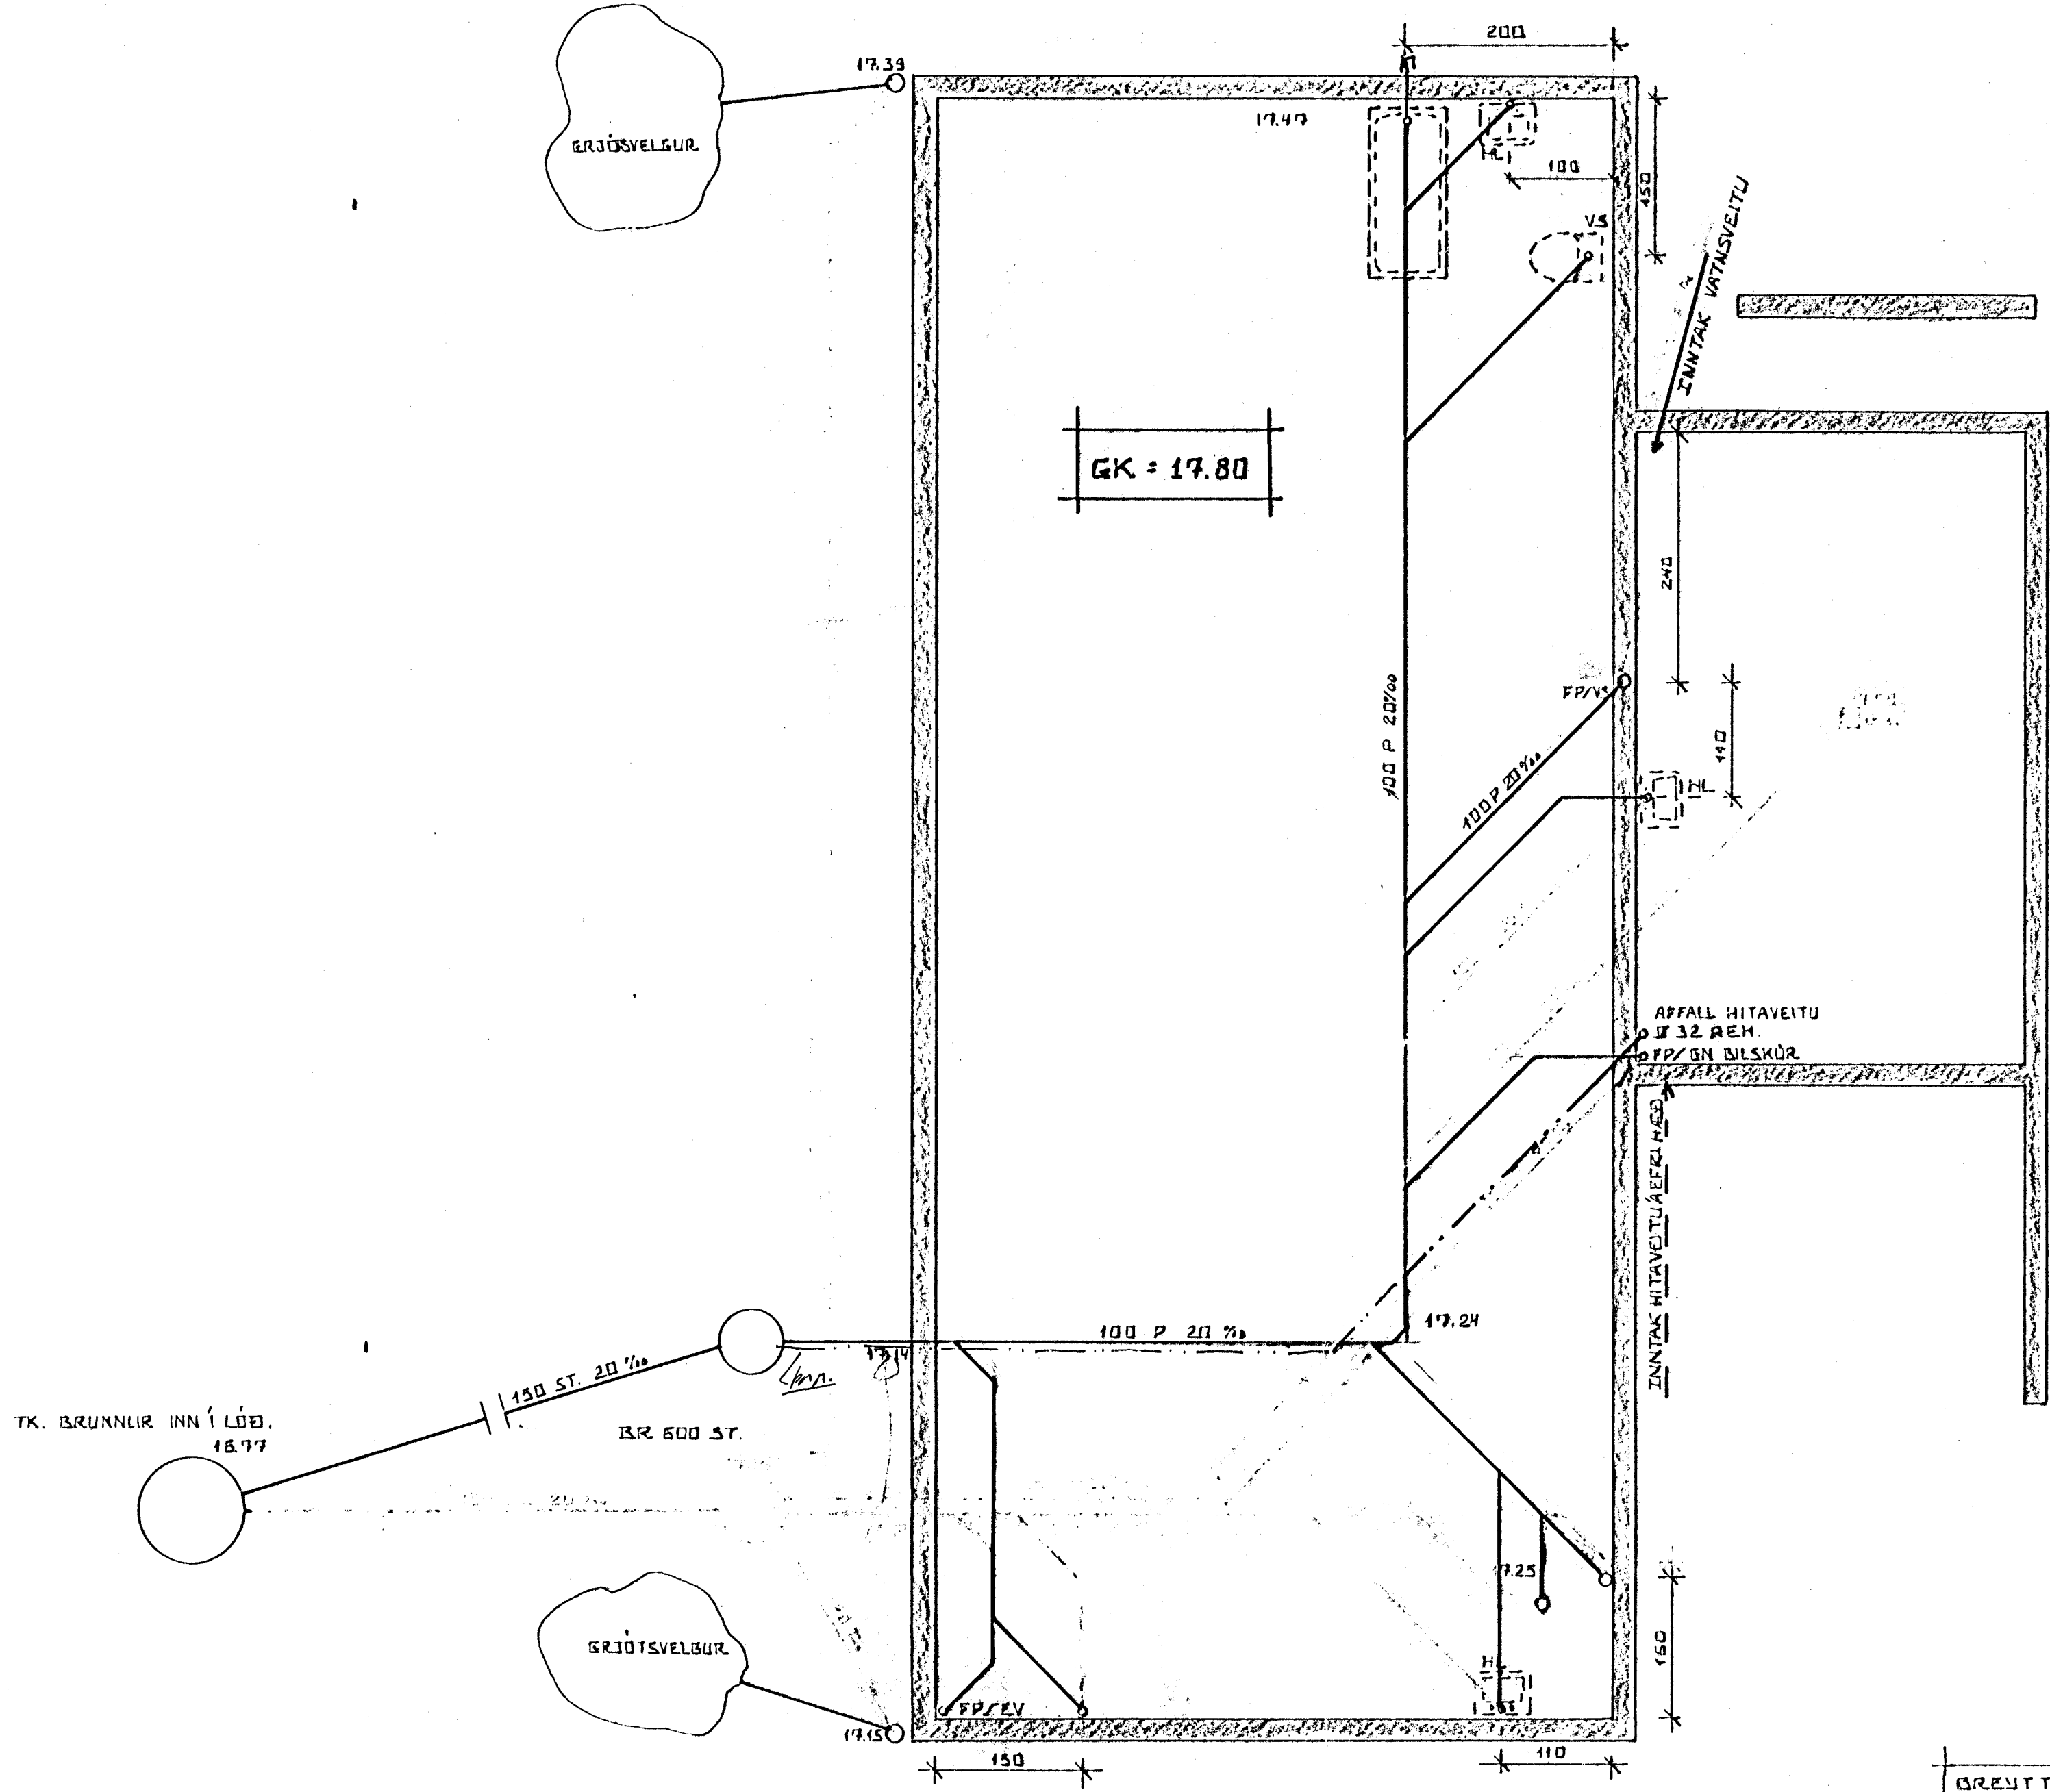

GRUNNMYND 1:50

DRÖTT 20.08.82. FE.

NORÐURBRAUT 37 HAFNARFIRÐI	DAGS. 318782.
	REIKN. 80
GRUNNLAGNIR.	TEIKN. 82
	VERK NR.
MÆLIKV. 1:50	BLAÐ NR.
SIGURÐUR ÞORLEIFSSON TÆKNIFRÆÐINGUR F.T.E.I.	02
STRANDGÖTU 11 HAFNARFIRÐI SIMI 54751	