




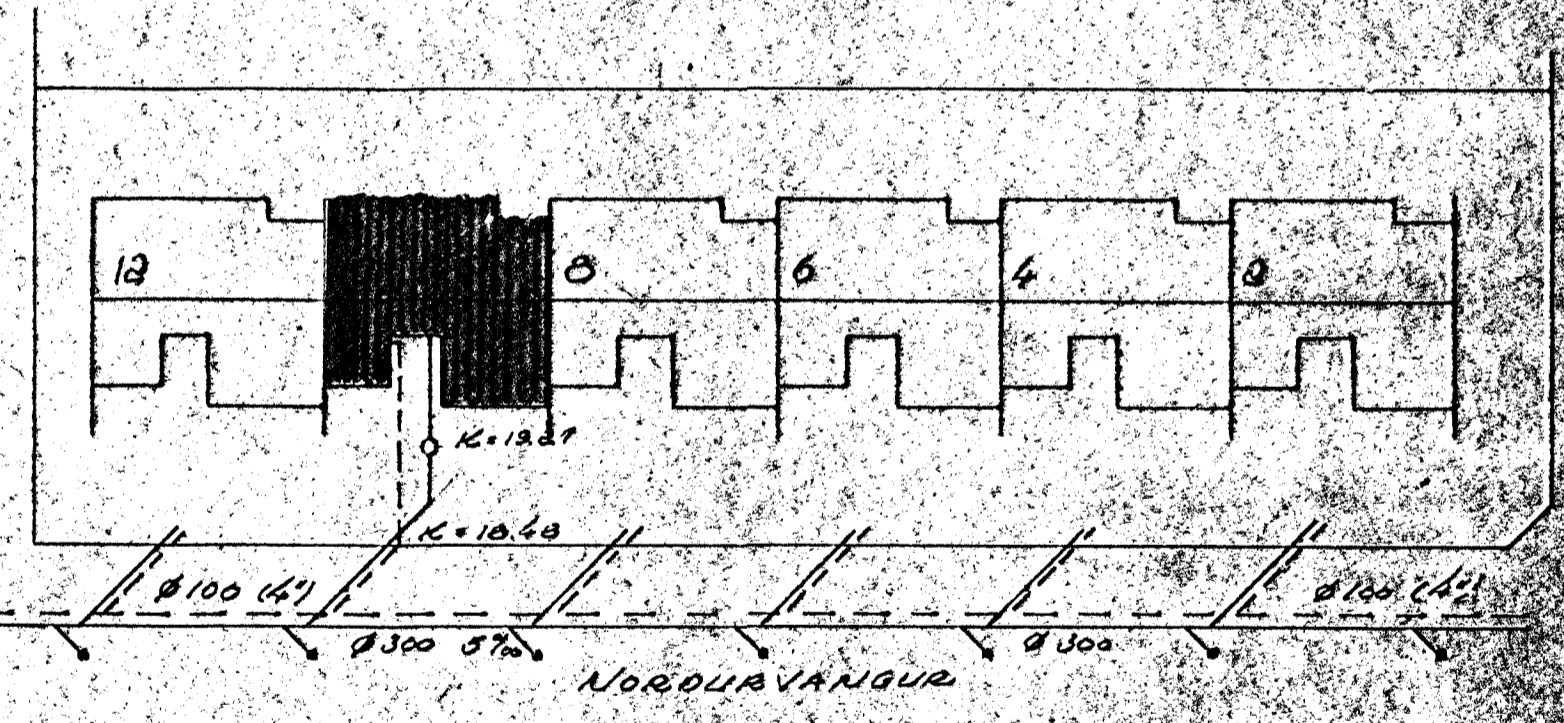

27/4-73. Innviðlegi tekið út skv. sigelma brestingum

KVARDI TEIKNISTOFA HRINGBRAUT 121 REYKJAVIK SIMI 26340

VERKFRU	NORÐURVANGUR 10 H.	MAÐ	11.50	VERK NÚR	3.10.87
		DAGS	2.10.72	BR	
HOFRÆSI		TEIKN	B.K.	TEIKN NÚR	V.87
		REIKN			

Handwritten signature