



OFNALISTI				
OFN NR.	MESTA		VARHAFER KAL/ST	STADSETN- ING STJOTA
	H	L		
1	60	70	1050	AD
2	60	130	1050	AD
3	60	100	950	CB
4	60	50	350	AD
5	60	100	1050	CB
6	60	130	2150	AD
7	60	130	2800	AD
8	60	130	2350	AD
9	60	130	1620	CB
10	60	130	1250	CB
11	60	130	1700	AB
12	40	130	1700	CB
13	40	340	3500	CB
t = 40°C			21,520	
t herb. = 20°C (25°C i badh)				

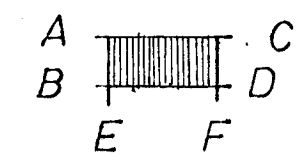

Ath. í samráði við byggingafulltr.

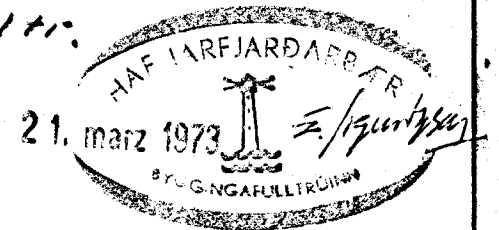

KVARDI TEIKNISTOFA HRINGBRAUT 121 REYKJAVÍK SÍMI 26340

VERKEFNI	MÁL	VERK NR.
NORÐURVANGUR II	1:50	3-73-27
HAFNARFJARDI	DAG.	BR.
	9-10'73	
HITALÖGN GRUNNMANNÓ	TEIKN.	TEIKN. NR.
	68.	V-9a
	REIKN.	
	AD.	

*Arni Stefánsson 7871*