
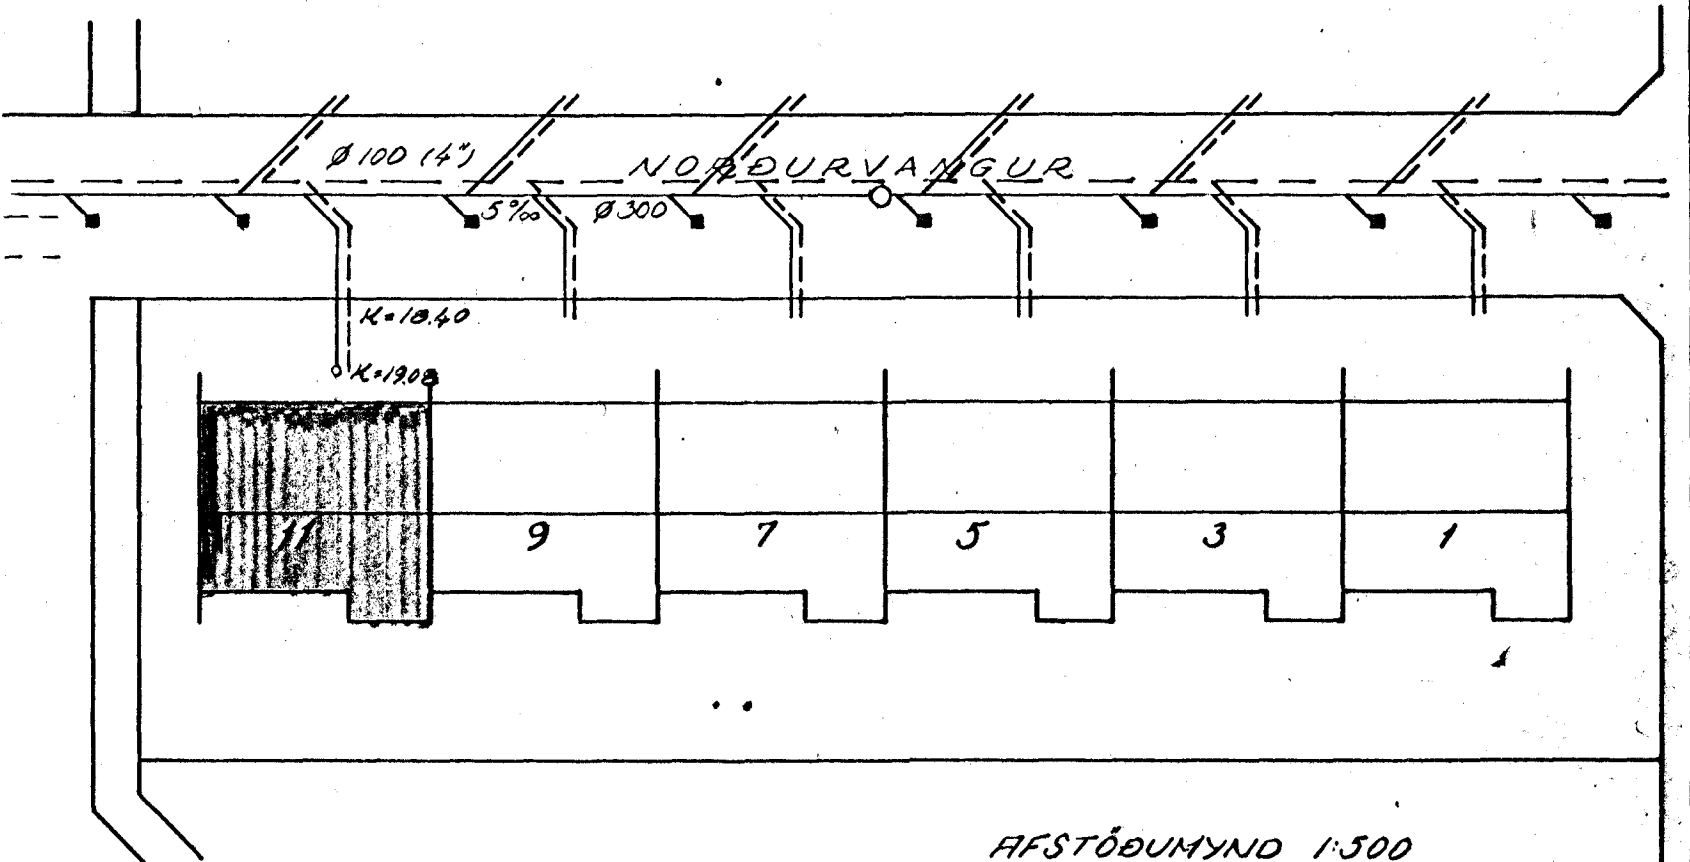
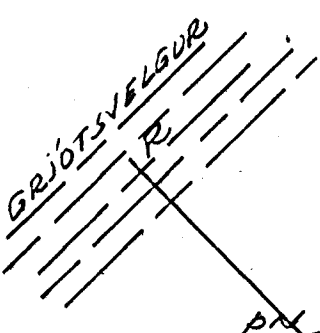
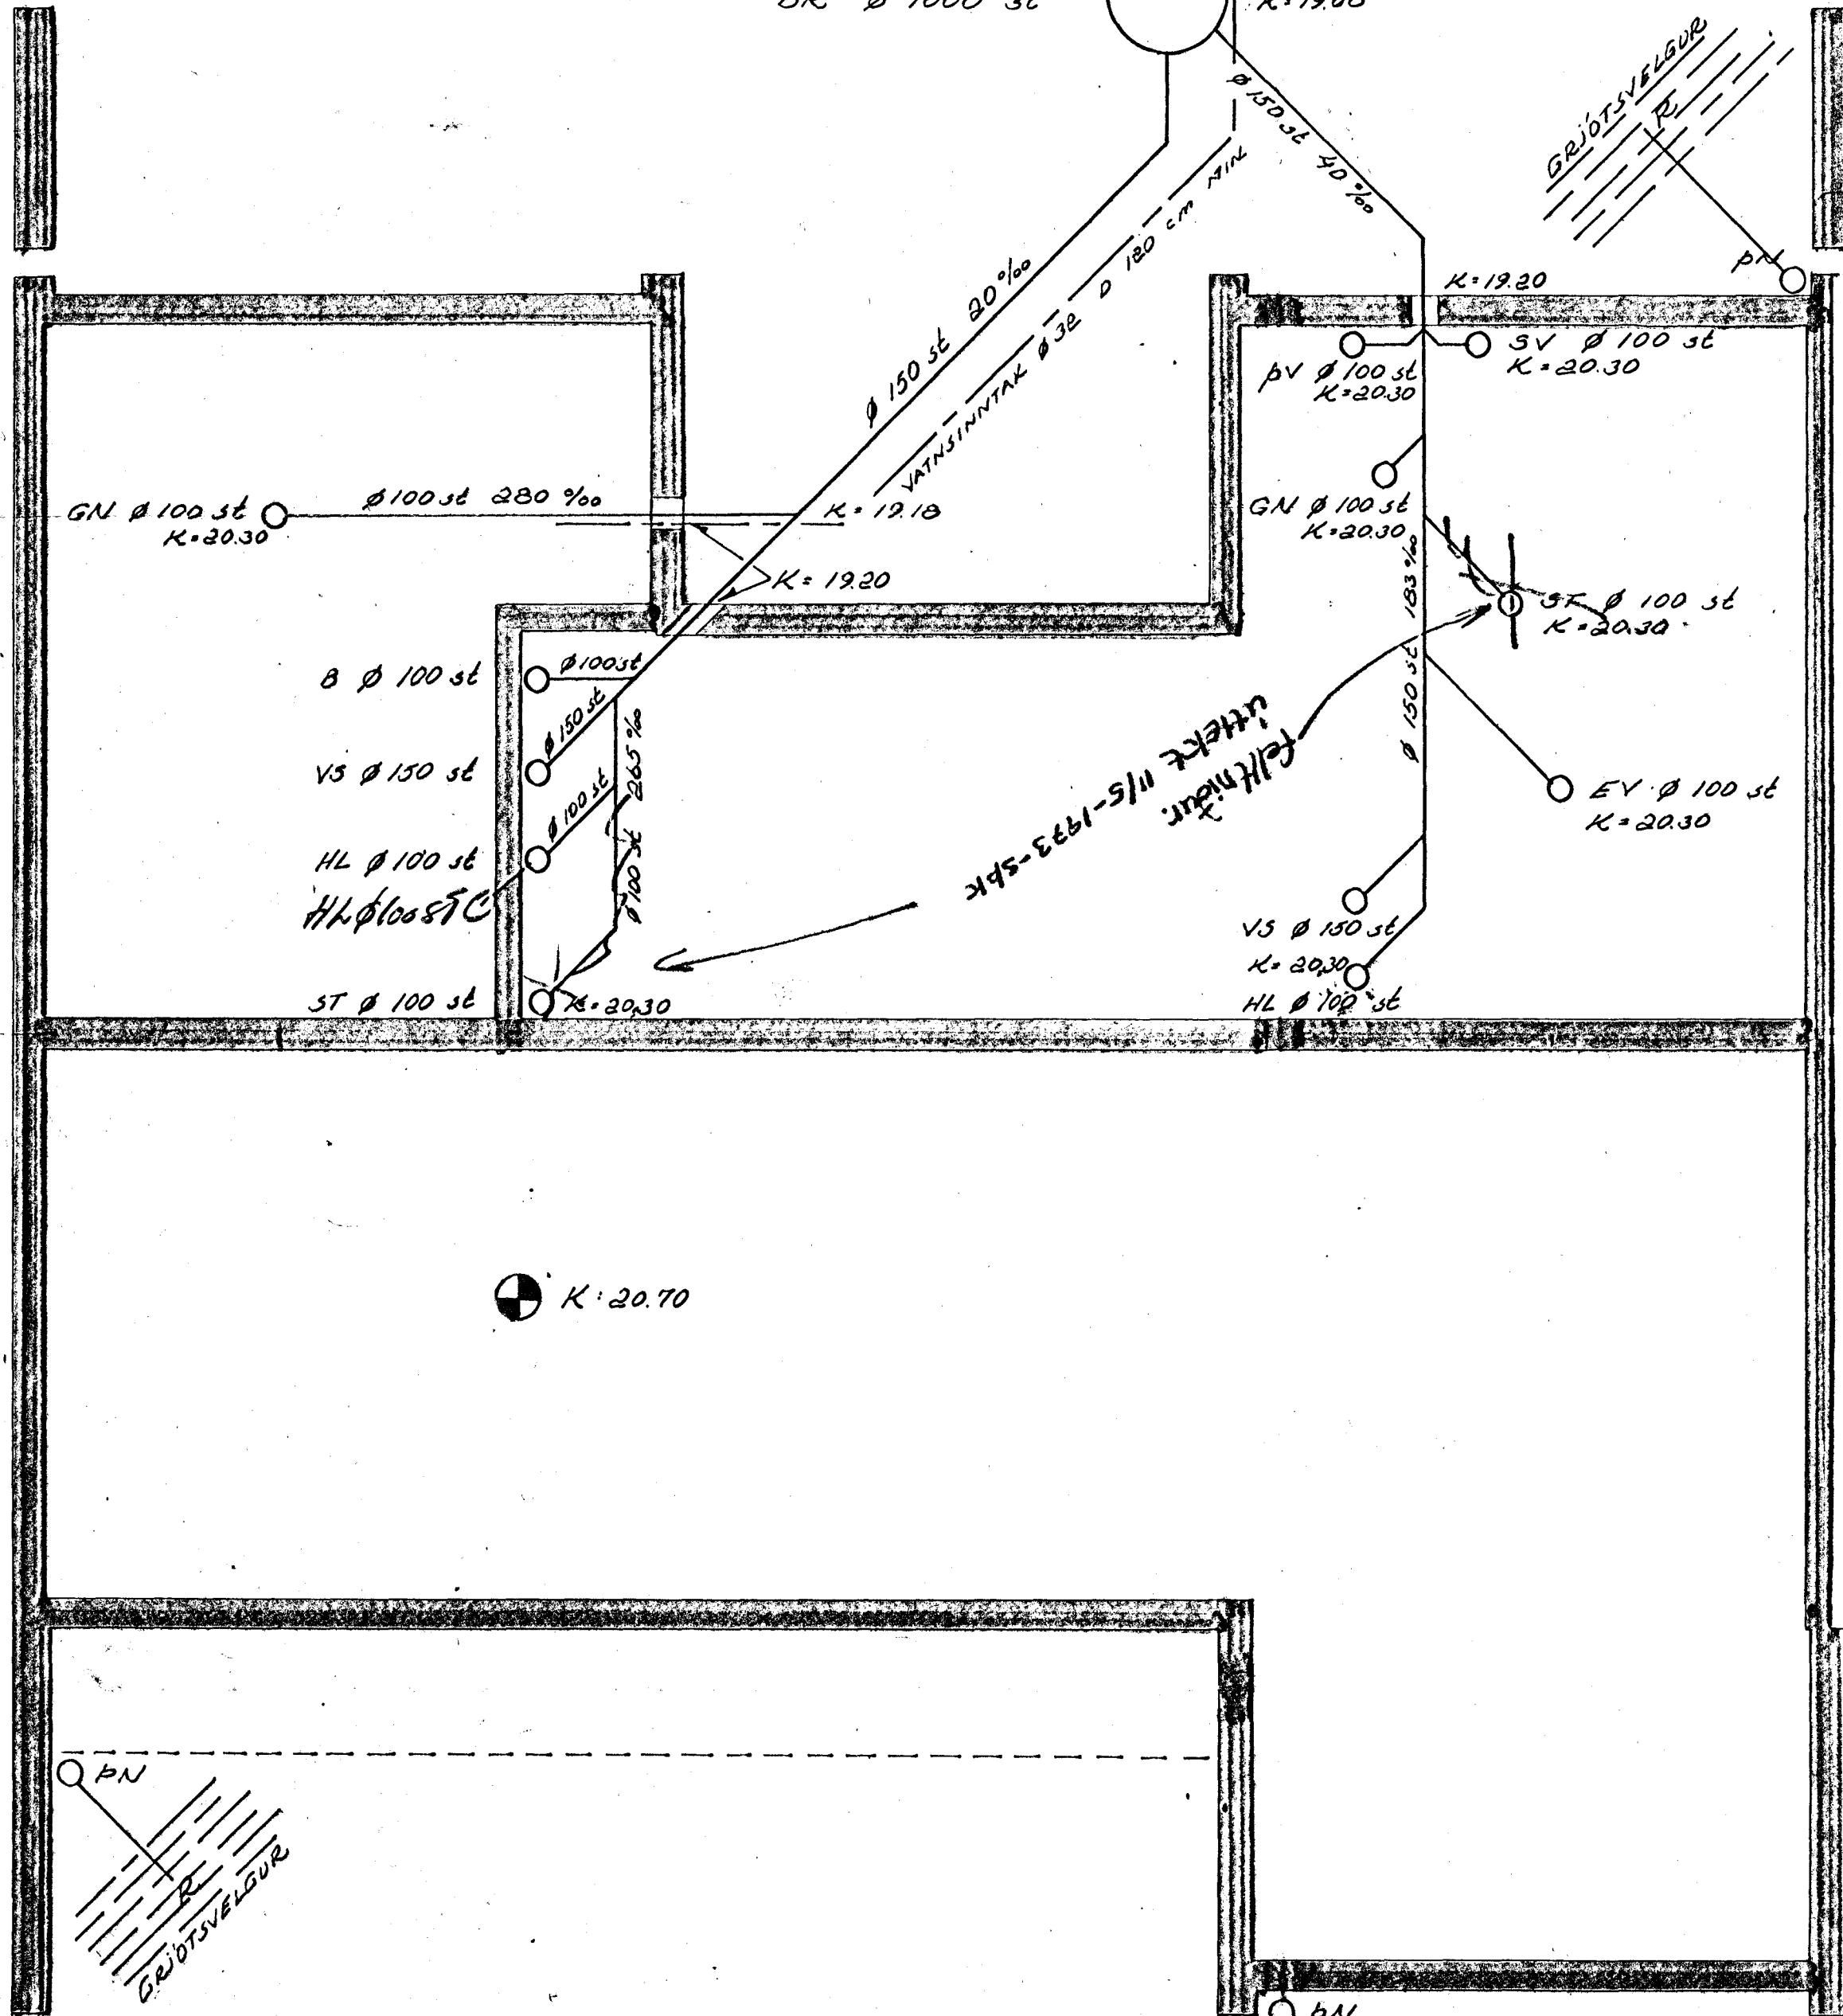




LÖGN TIL GÖTU Ø 150 st 130 ‰

BR Ø 1000 st

K=19.08

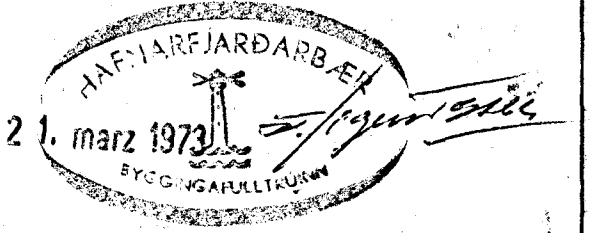

AFSTÖÐUMYND 1:500

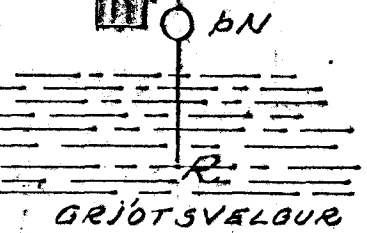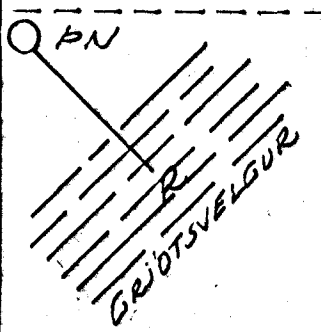

KVARDI TEKNISTOFA HRINGBRAUT 121 REYKJAVIK SIMI 26340

VERKEFNI	NORÐURVANGUR 11	MÁL	1:50	VERK TÍÐ	3-72-27
		DAGS.	9.10.72	BR.	
		TEIKN.	G.H.	TEIKN. NR.	V-2-1
		REIKN.	AD.		

*Arnljófríður Stefánsdóttir*