




Útlit norður

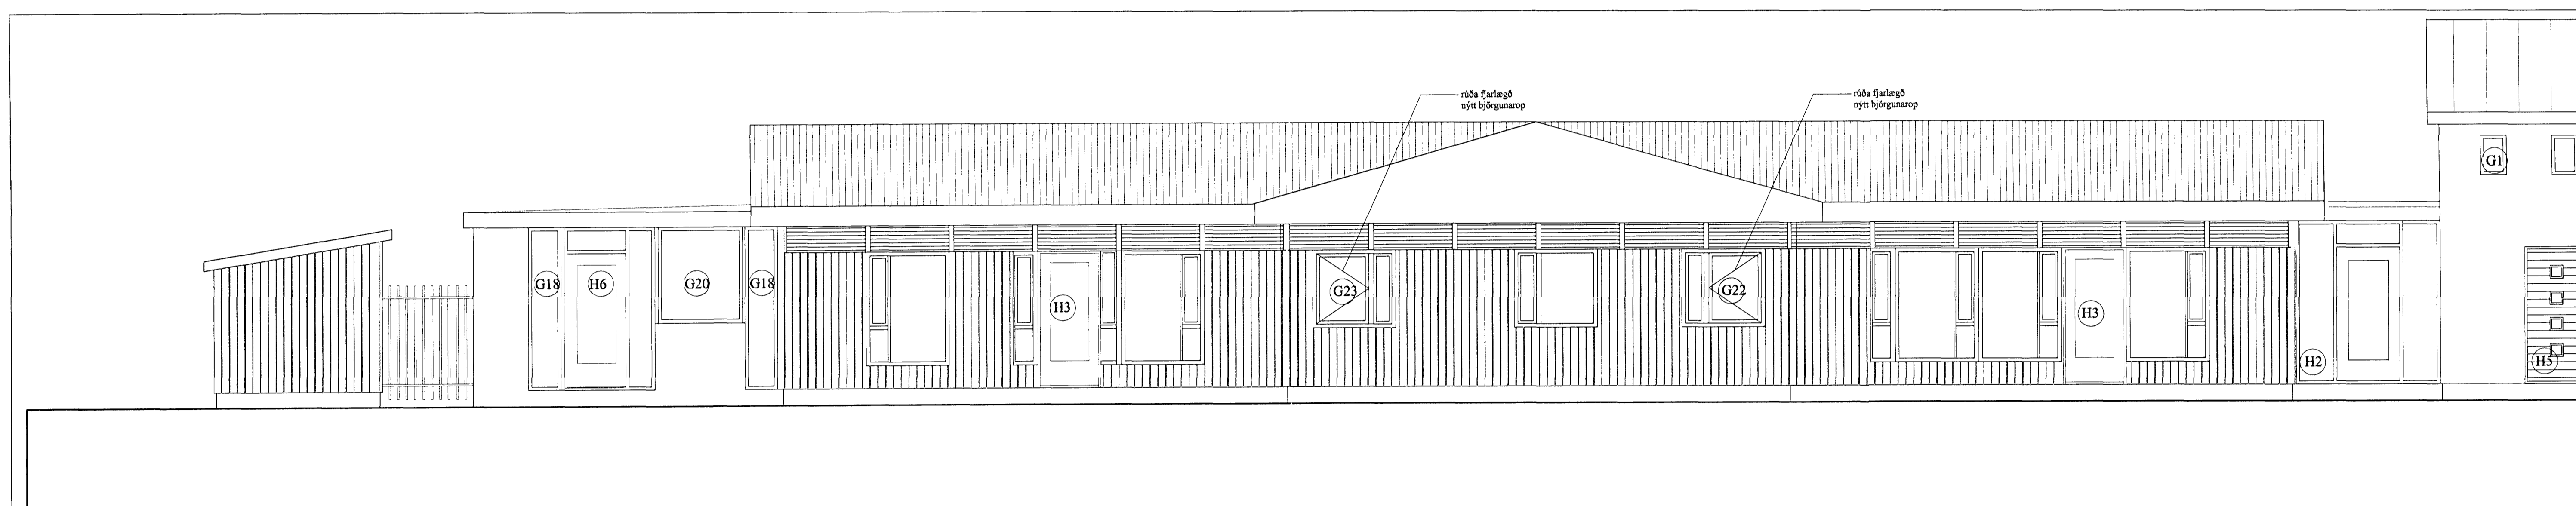

Útlit suður

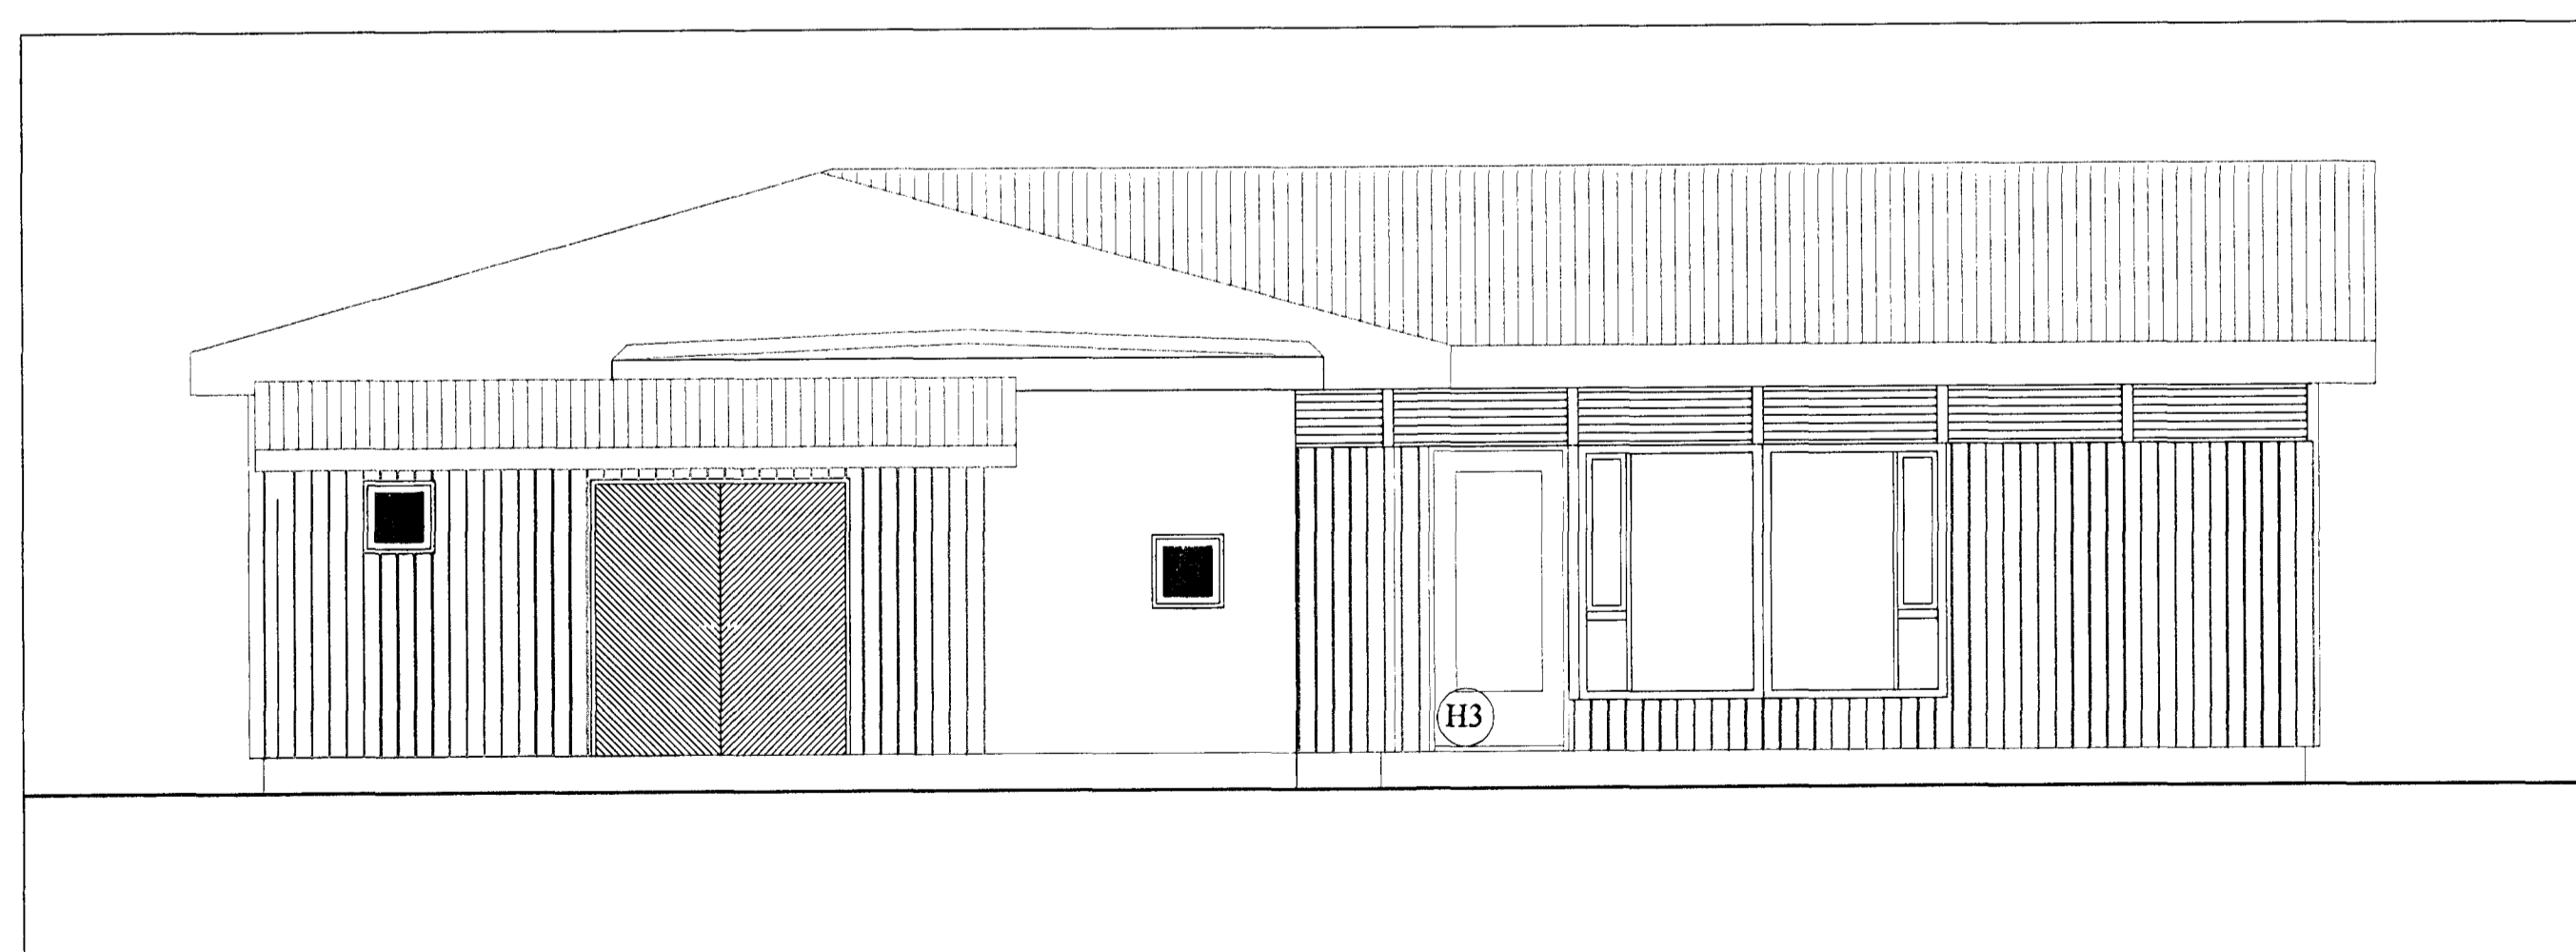

Útlit vestur

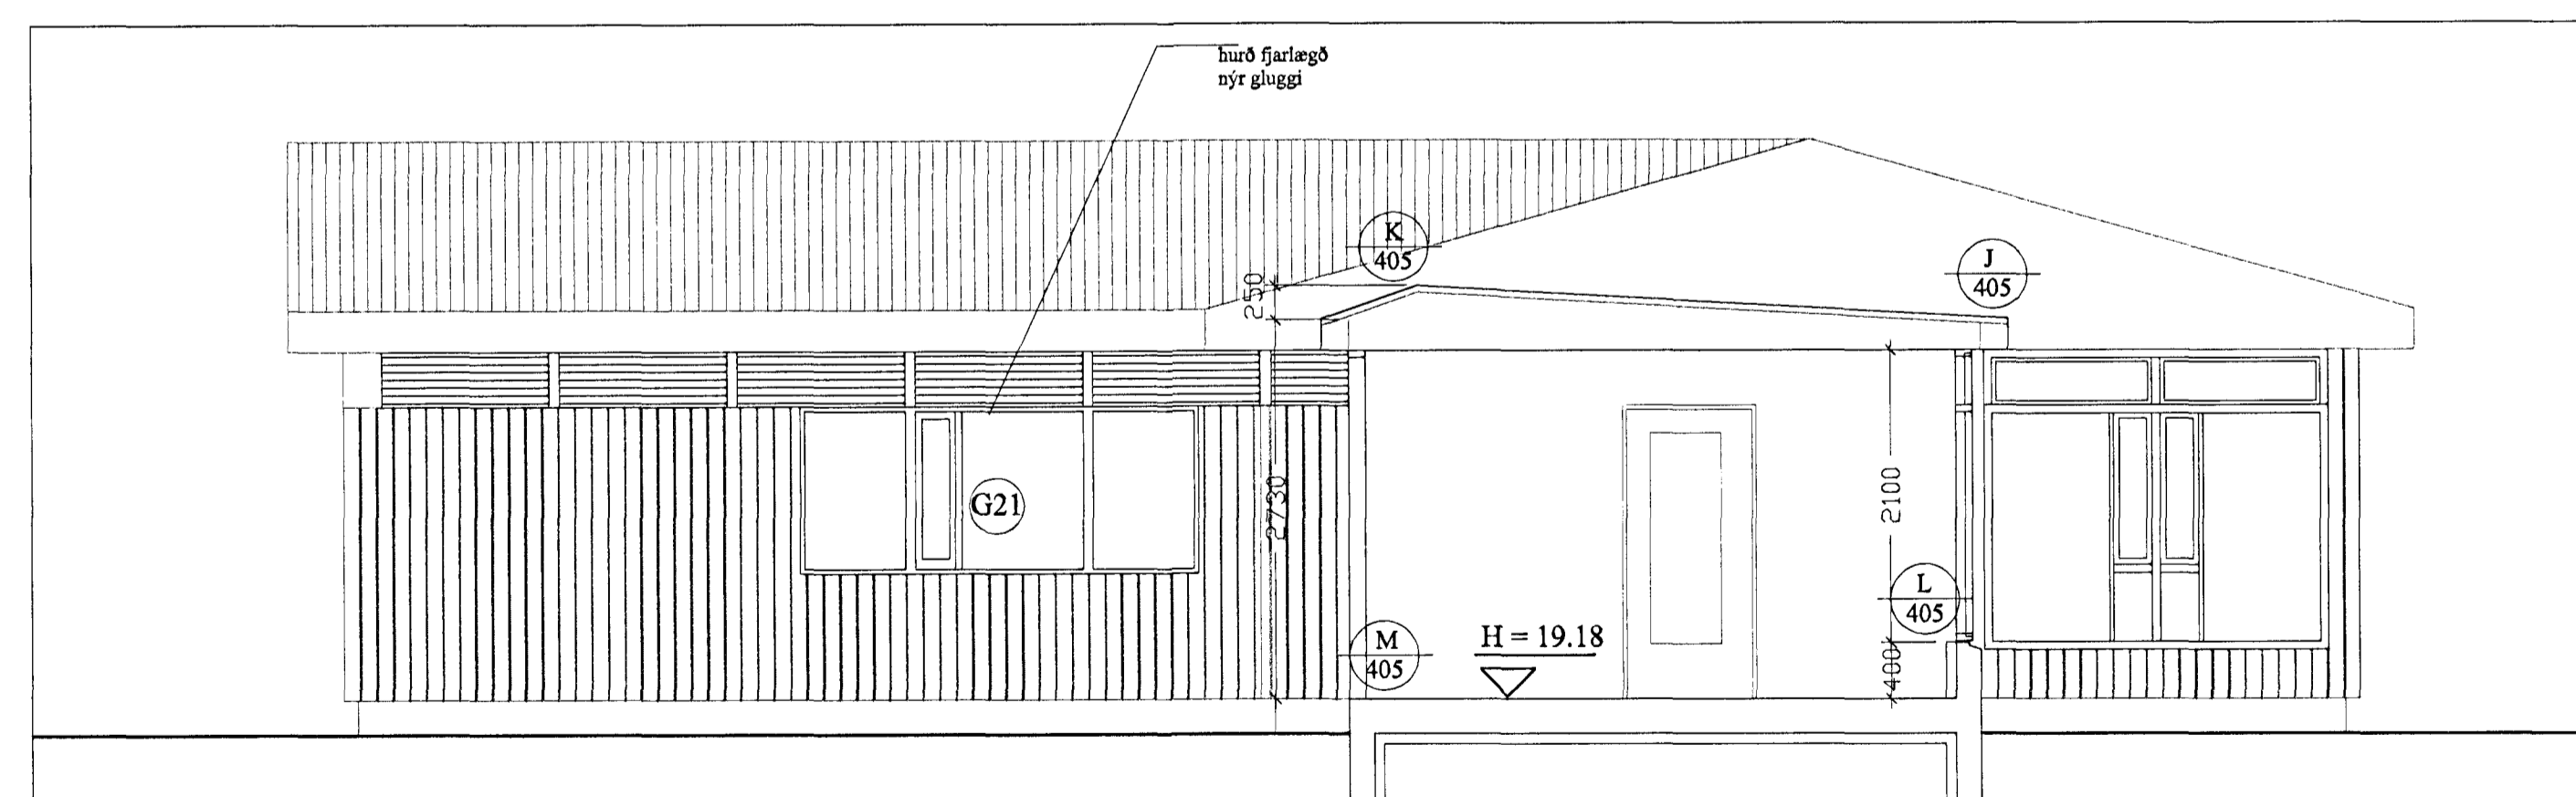

Sníð b-b

07 MARS 2000

borealis
BYGGINGSTÍTTARI
Leikskólinn Norðurberg

verkefni: 99-201
heli tákningar: rúmur
útlit núverandi húss: A-203
dag: 29.02.2000 gg th
skráðaféll: tm_verk_nberg

skráðaféll: 565 2850, fax 565 2858
borealis@centrum.is