
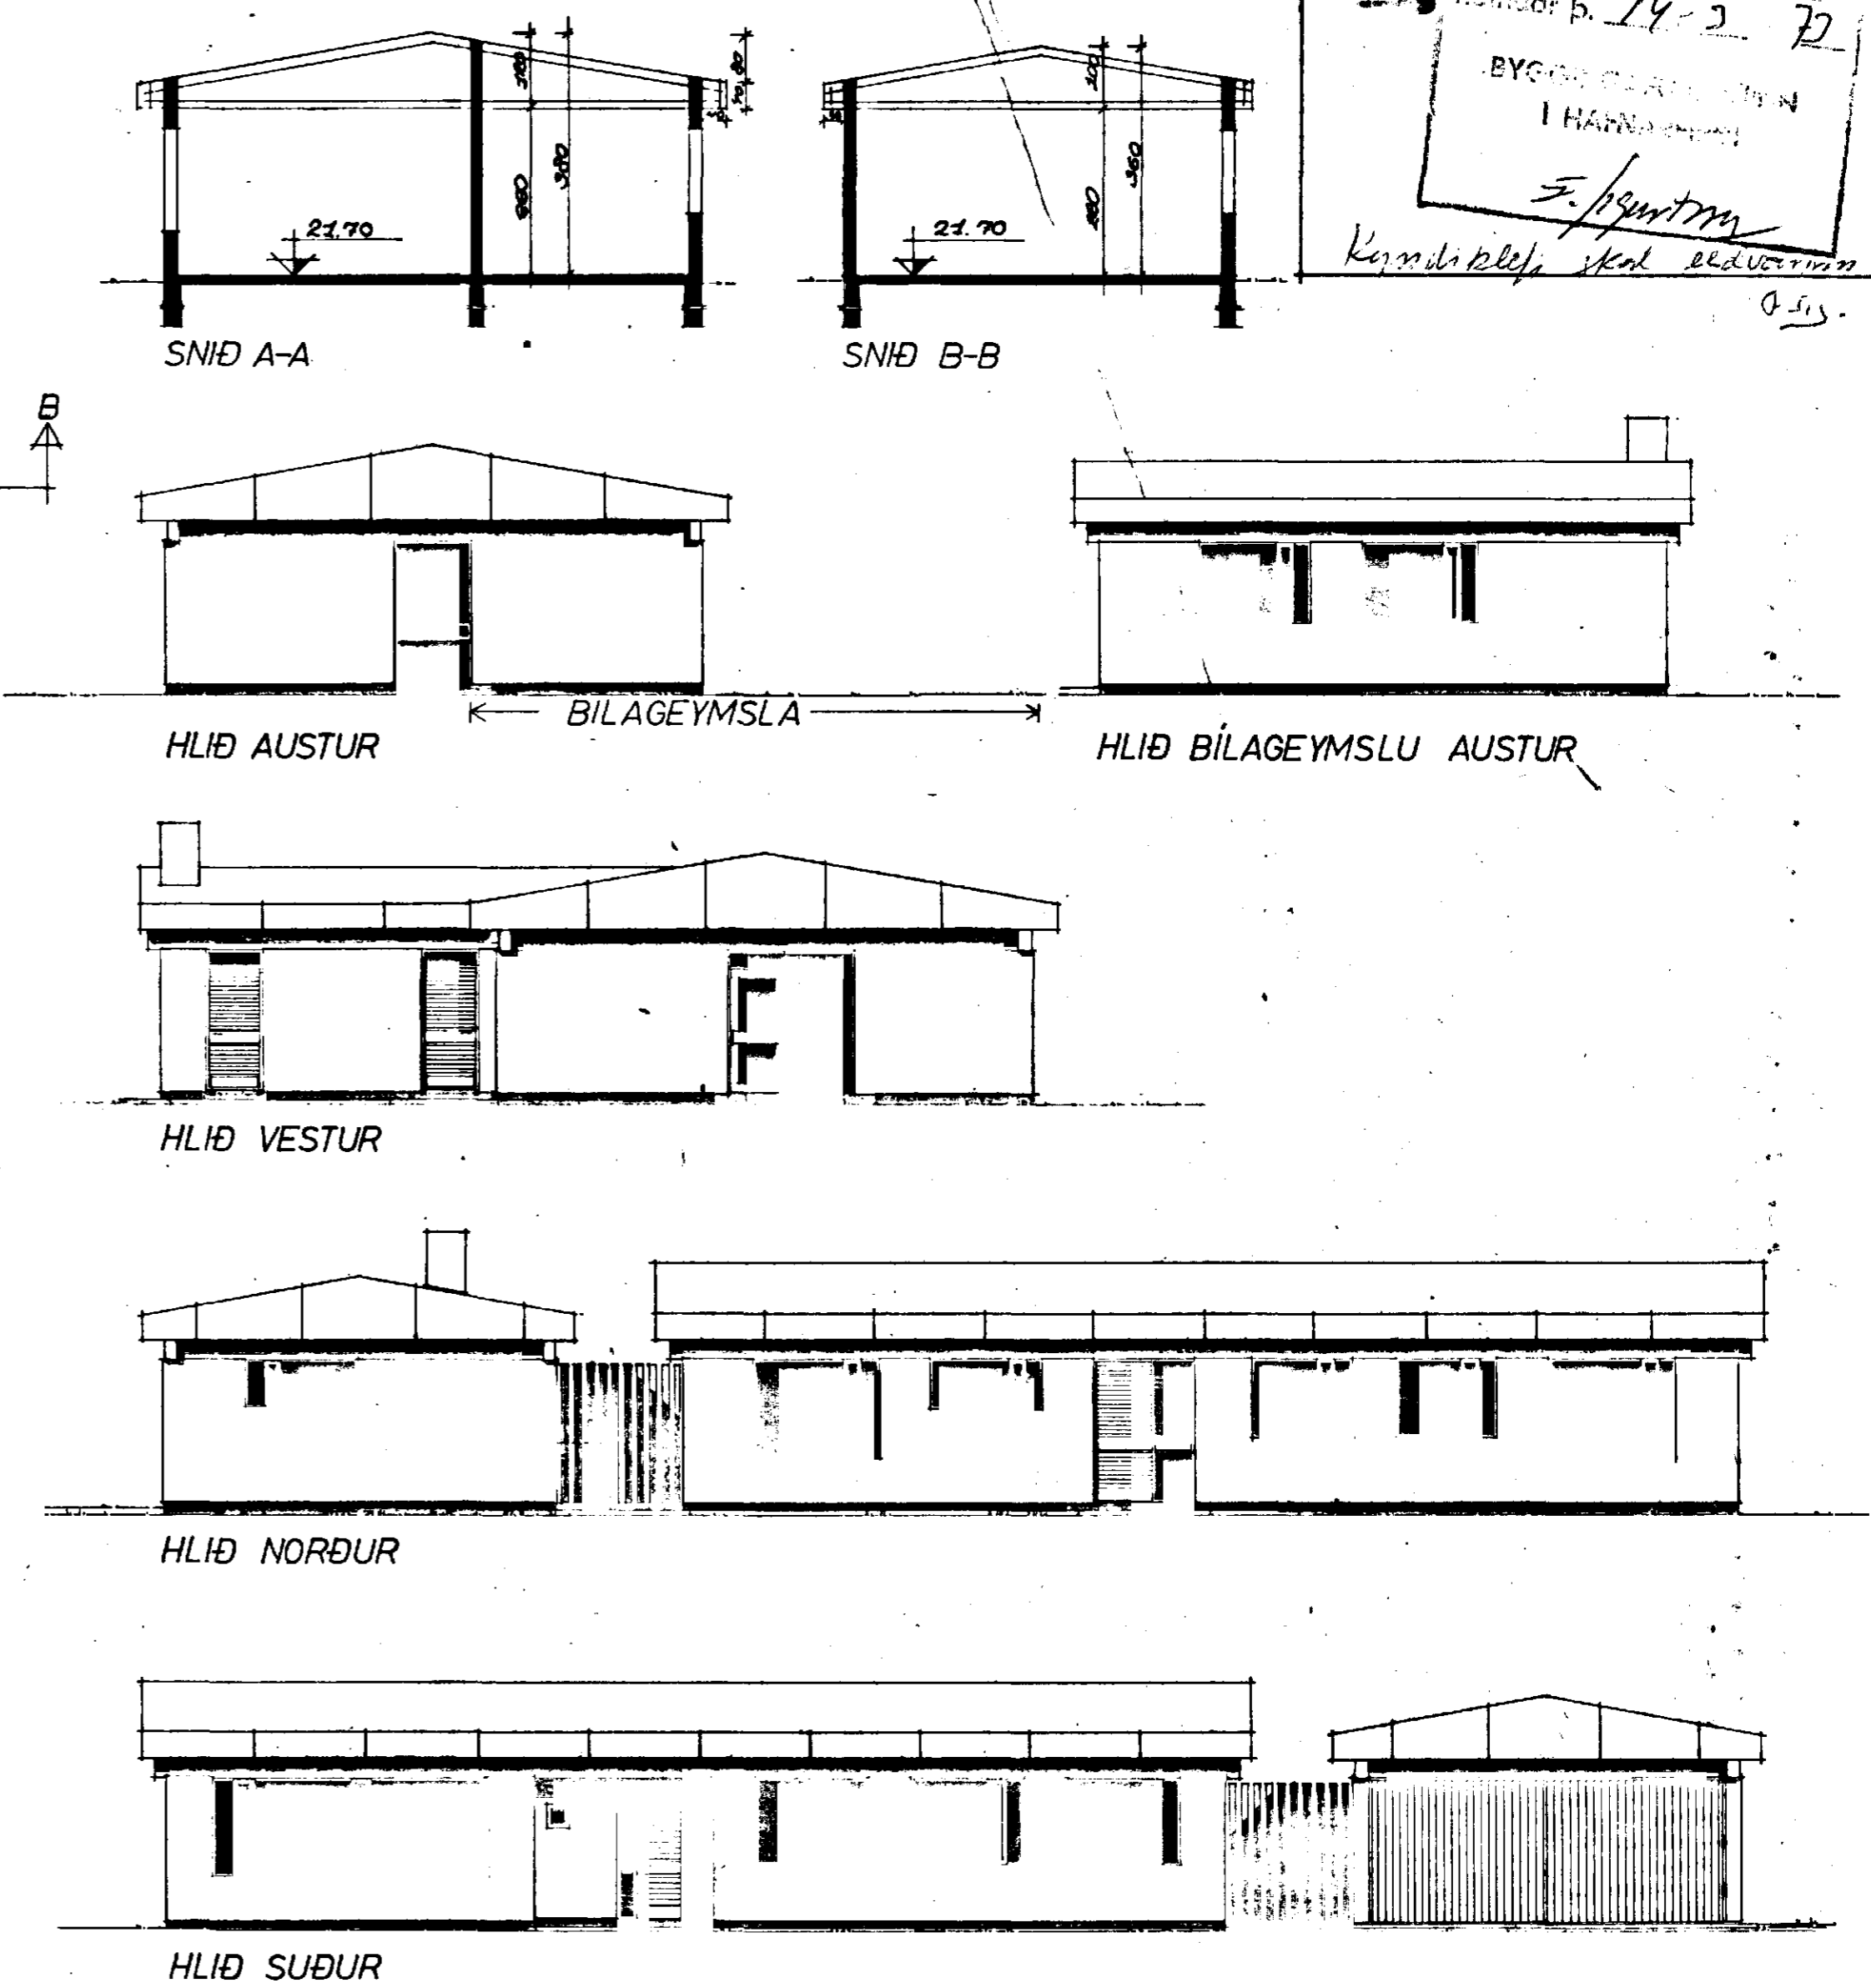


tifftopdf - www.rubissoftware.com - Demo Versiön

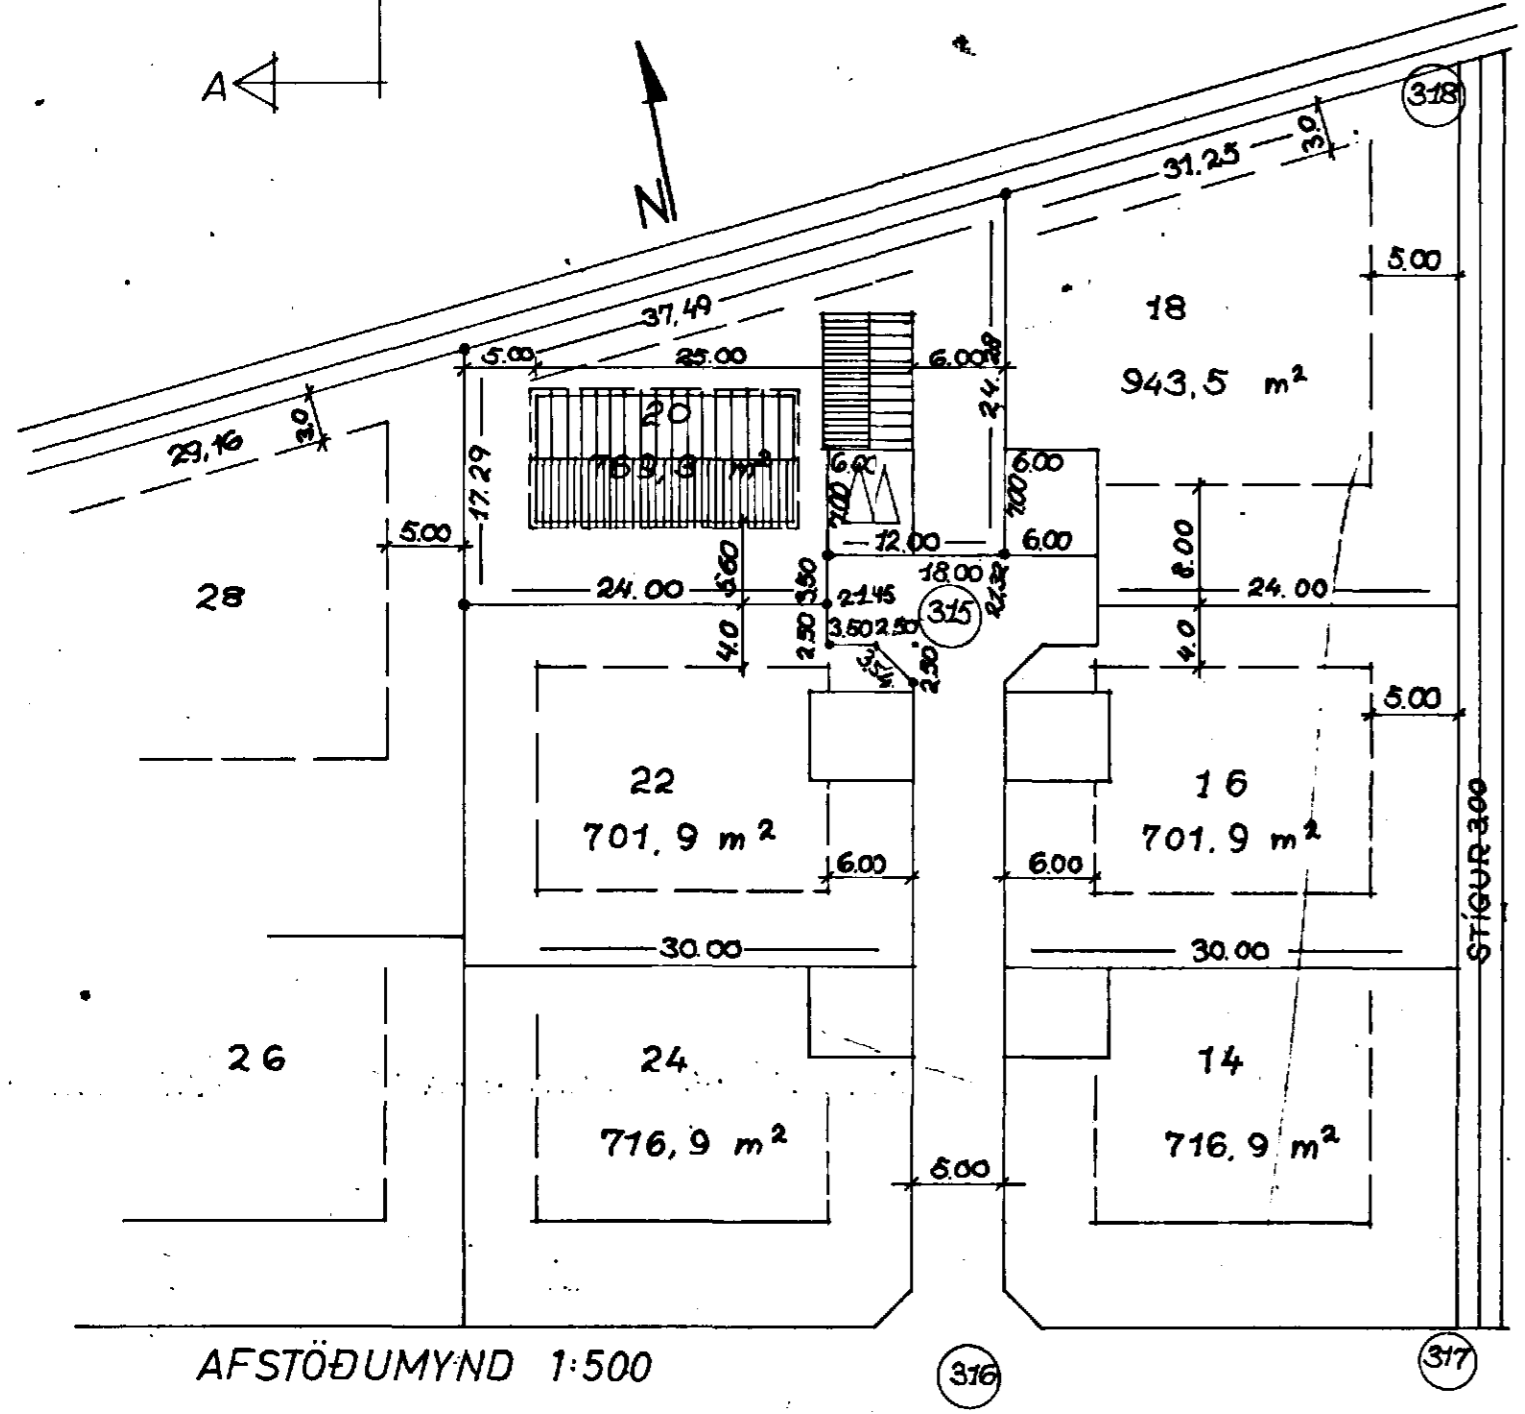

Sambýdd & fundi byggisga-  
notindar þ. 14.2.73  
BYGGINGARFRÖÐUN  
I HAFNARFIRÐI  
F. J. Jónsson  

STÆRÐIR  
HÚS BRÚTTÓ : 140m²  
HÚS NETTÓ : 125m²  
BILAGEYMSLA BRÚTTÓ : 56m²  
LÖÐ : 769.3m²  
NYTINGARHLÚTFALL : 0.25

KVARÐI TEIKNISTOFA HRINGBRAUT 121 REYKJAVIK SIMI 26340		
VERKHEFNI	NORÐURVANGUR 20 HAFNARFIRÐI	SKALA 1:100, 1:500.
GRUNNMYND, ÚTLIT, SNID OG AFSTÖÐUMYND	21.2.73.	VERK NR. 3-73-01.
		BR. TEIKN. SVK. 1A-1.

*Handwritten signature and date: 21.2.73*