


OFNASKRA  $\Delta T 40^\circ C$

NR.	HITATAP KCAL/T	OFN - PANEL	TENGI
1	1385	P 2 440/2480	C + B 10
2	1355	P 2 740/1520	C + B 10
3	1410	P 3 990/640	C + D 10
4	610	P 990/880	A + B 10
5	765	P 740/1440	C + B 10
6	925	P 2 590/1280	C + B 10
7	2945	P 3 440/4000	A + D 15
8A	920	P 440/2800	A + D 10
8B	490	P 2 440/880	A + B 10
9	1250	P 3 990/800	A + B 10
10	680	P 740/1280	A + D 10
11	765	P 740/1440	A + D 10
12	555	P 990/800	C + D 10
13	1410	P 2 990/1200	C + D 10
14A	1485	P 2 500/2400	A + D 10
14B	1530	P 2 500/2480	A + D 10

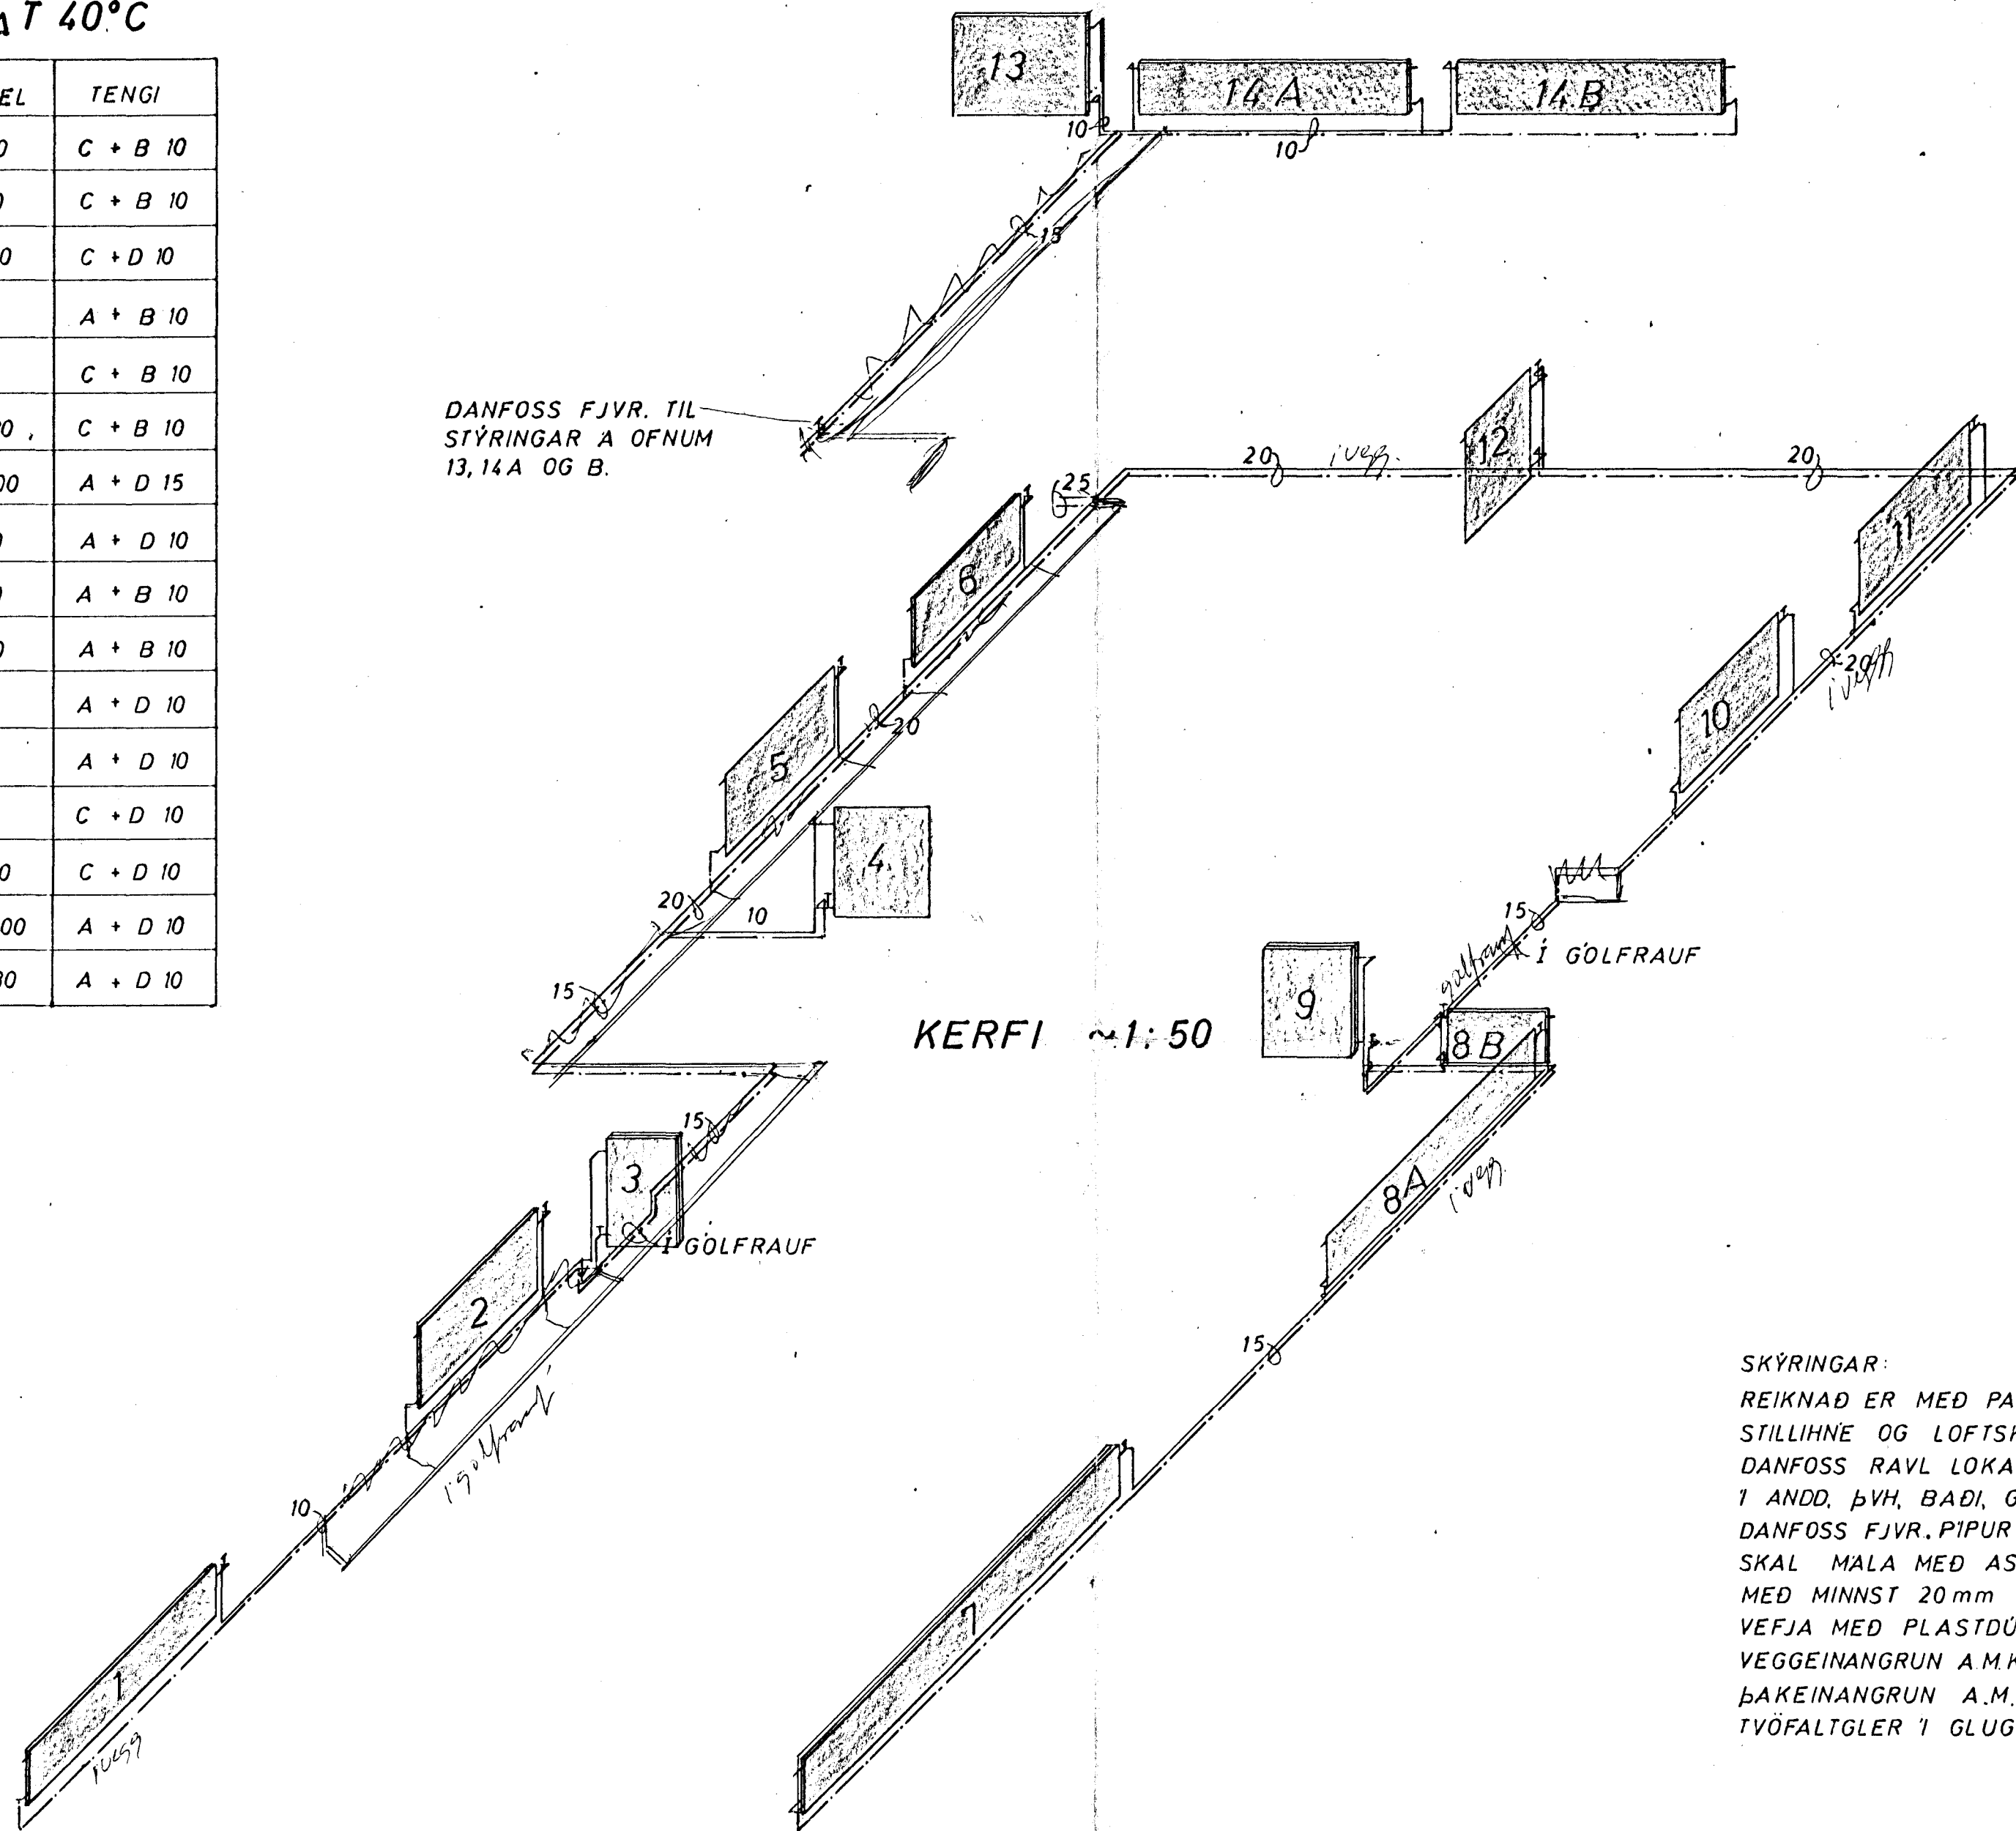

SKÝRINGAR:  
 REIKNAD ER MED PANELOFNUM. SJA OFNASKRA  
 STILLIHNE OG LOFTSKRÚFA A ÖLLUM OFNUM  
 DANFOSS RAVL LOKAR A ÖLLUM OFNUM NEMA  
 1 ANDD, ÞVH, BADI, GEYMSLU OG BILG. ÞAR SEU  
 DANFOSS FJVR. PIPUR VENJULEGAR SVARTAR  
 SKAL MALA MED ASFALTMALNINGU OG EINANGRA  
 MED MINNST 20mm GLERULLARHÖLKUM OG  
 VEFJA MED PLASTDÜK.  
 VEGGEINANGRUN A.M.K 2 1/2" PLAST  
 ÞAKEINANGRUN A.M.K 4"  
 TVÖFALTGLER I GLUGGUM.



NORDURVANGUR 30	MÆLIKVARDI ~1:50	VERK 7230	TEIKN NR 9
HITALÖGN KERFI	Hannað: [Signature]	Yfirfarið: [Signature]	DAGS MAI '73
JÓHANN GUNNAR BERGÞÓRSSON VERKFR MVFI KÖLDUKINN 9 - HAFNARFIRÐI - SÍMI 52895 - STRANDGÖTU 11 SÍMI 53215	Teiknað: [Signature]	Samþ: [Signature]	BREYTT

3514