




AFSTADA 1:500

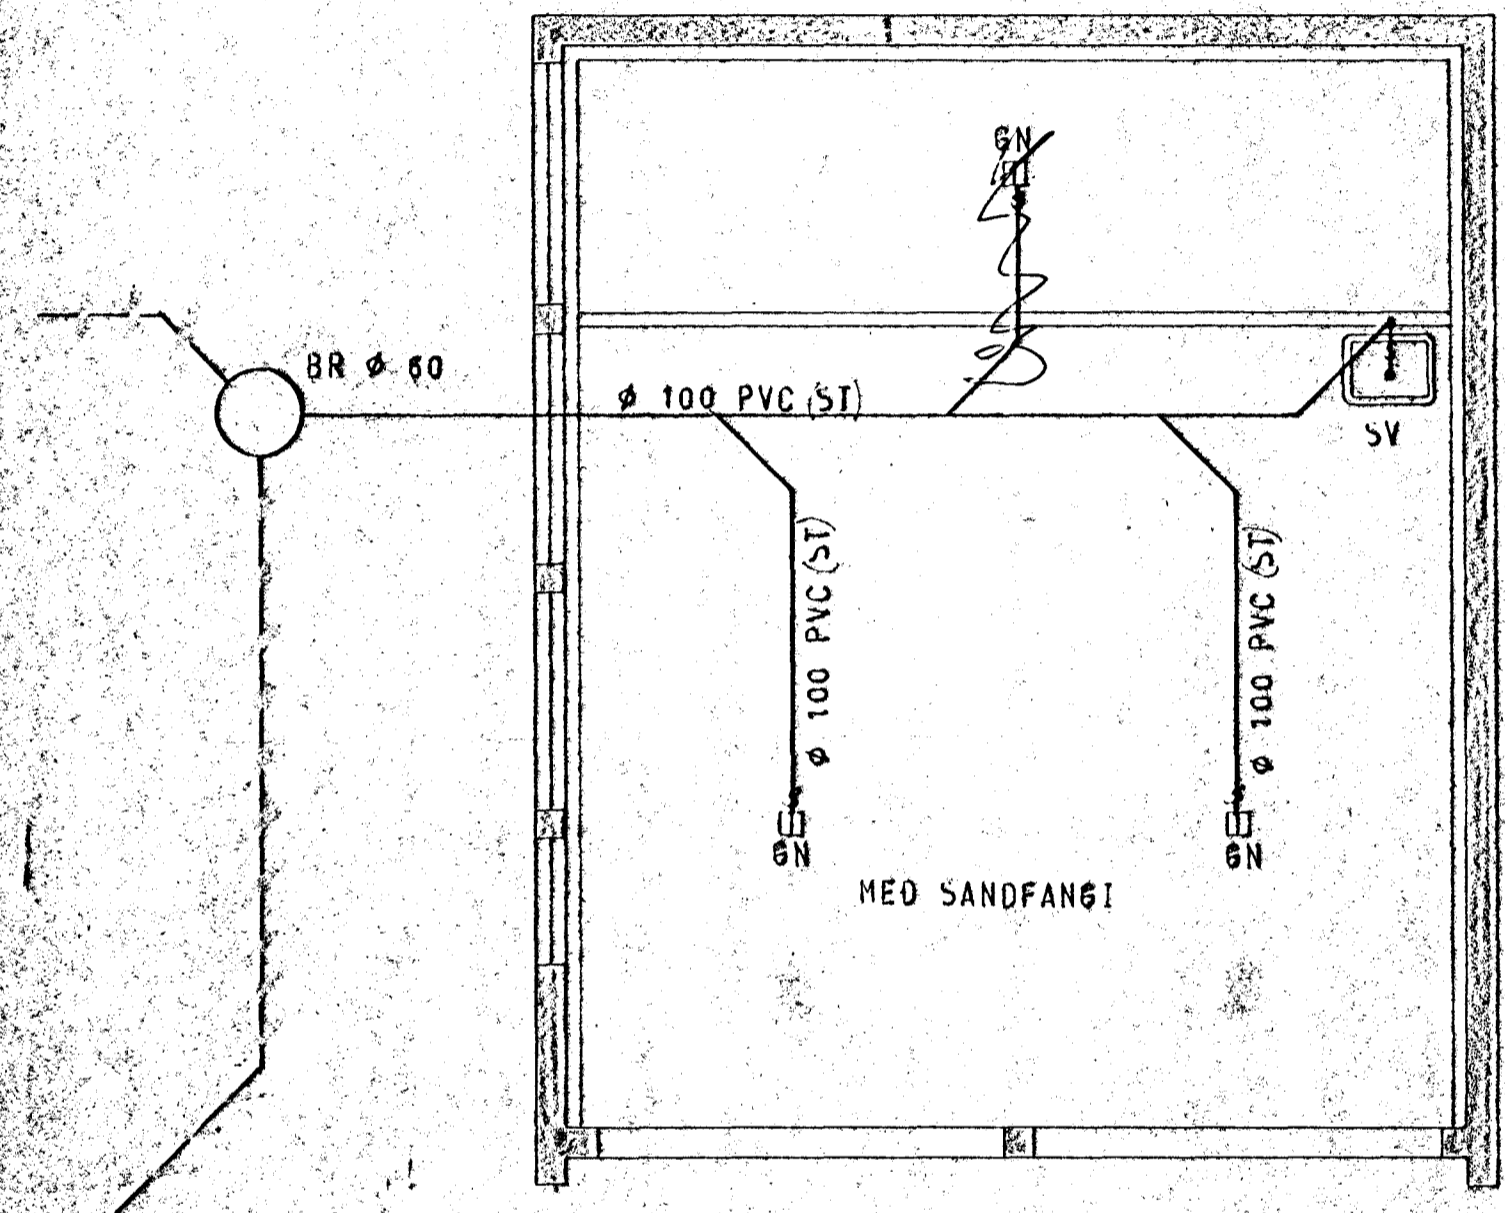

GRUNNMYND 1:50

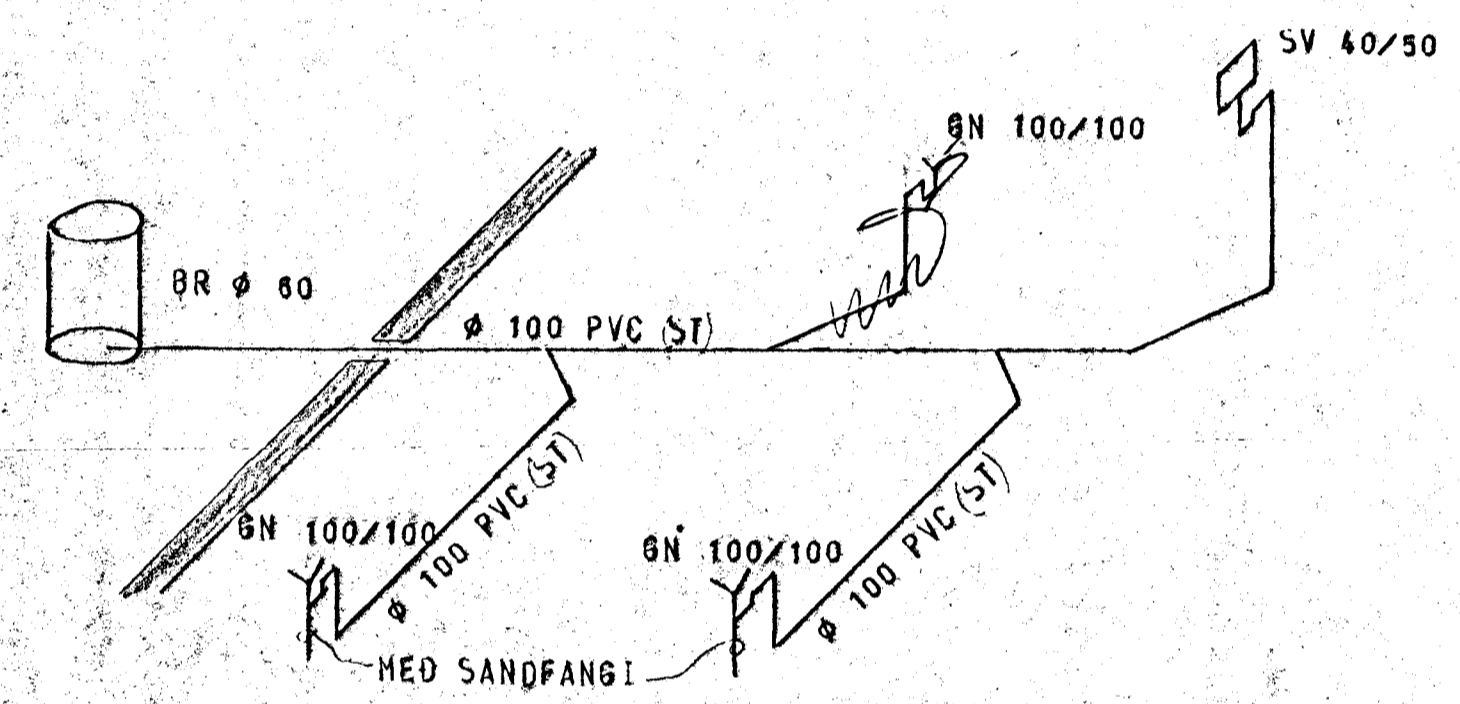

KERFI ~1:50

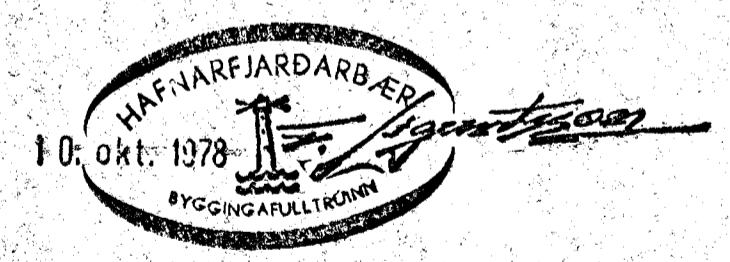

--- LÖGN SEM ER FÍL STADAR
 ——— NÝ LÖGN

NORÐURVANGUR 31	MÆLIKVARDI 1:500 1:50	VERK 7818	TEIKN NR 1
	Hannað: <i>[Signature]</i> Teiknað: <i>[Signature]</i>	Yfirfarið: <i>[Signature]</i> Samb: <i>[Signature]</i>	DAGS OKT. '78
JÓHANN GUNNAR BERGPÓRSSON VERKFR. MVF STRANDGÖTU 11 — HAFNARFIRÐI — Sími 53318		BREYTT	