


Nordurvangur 3.  
brayting á Skilplötu.

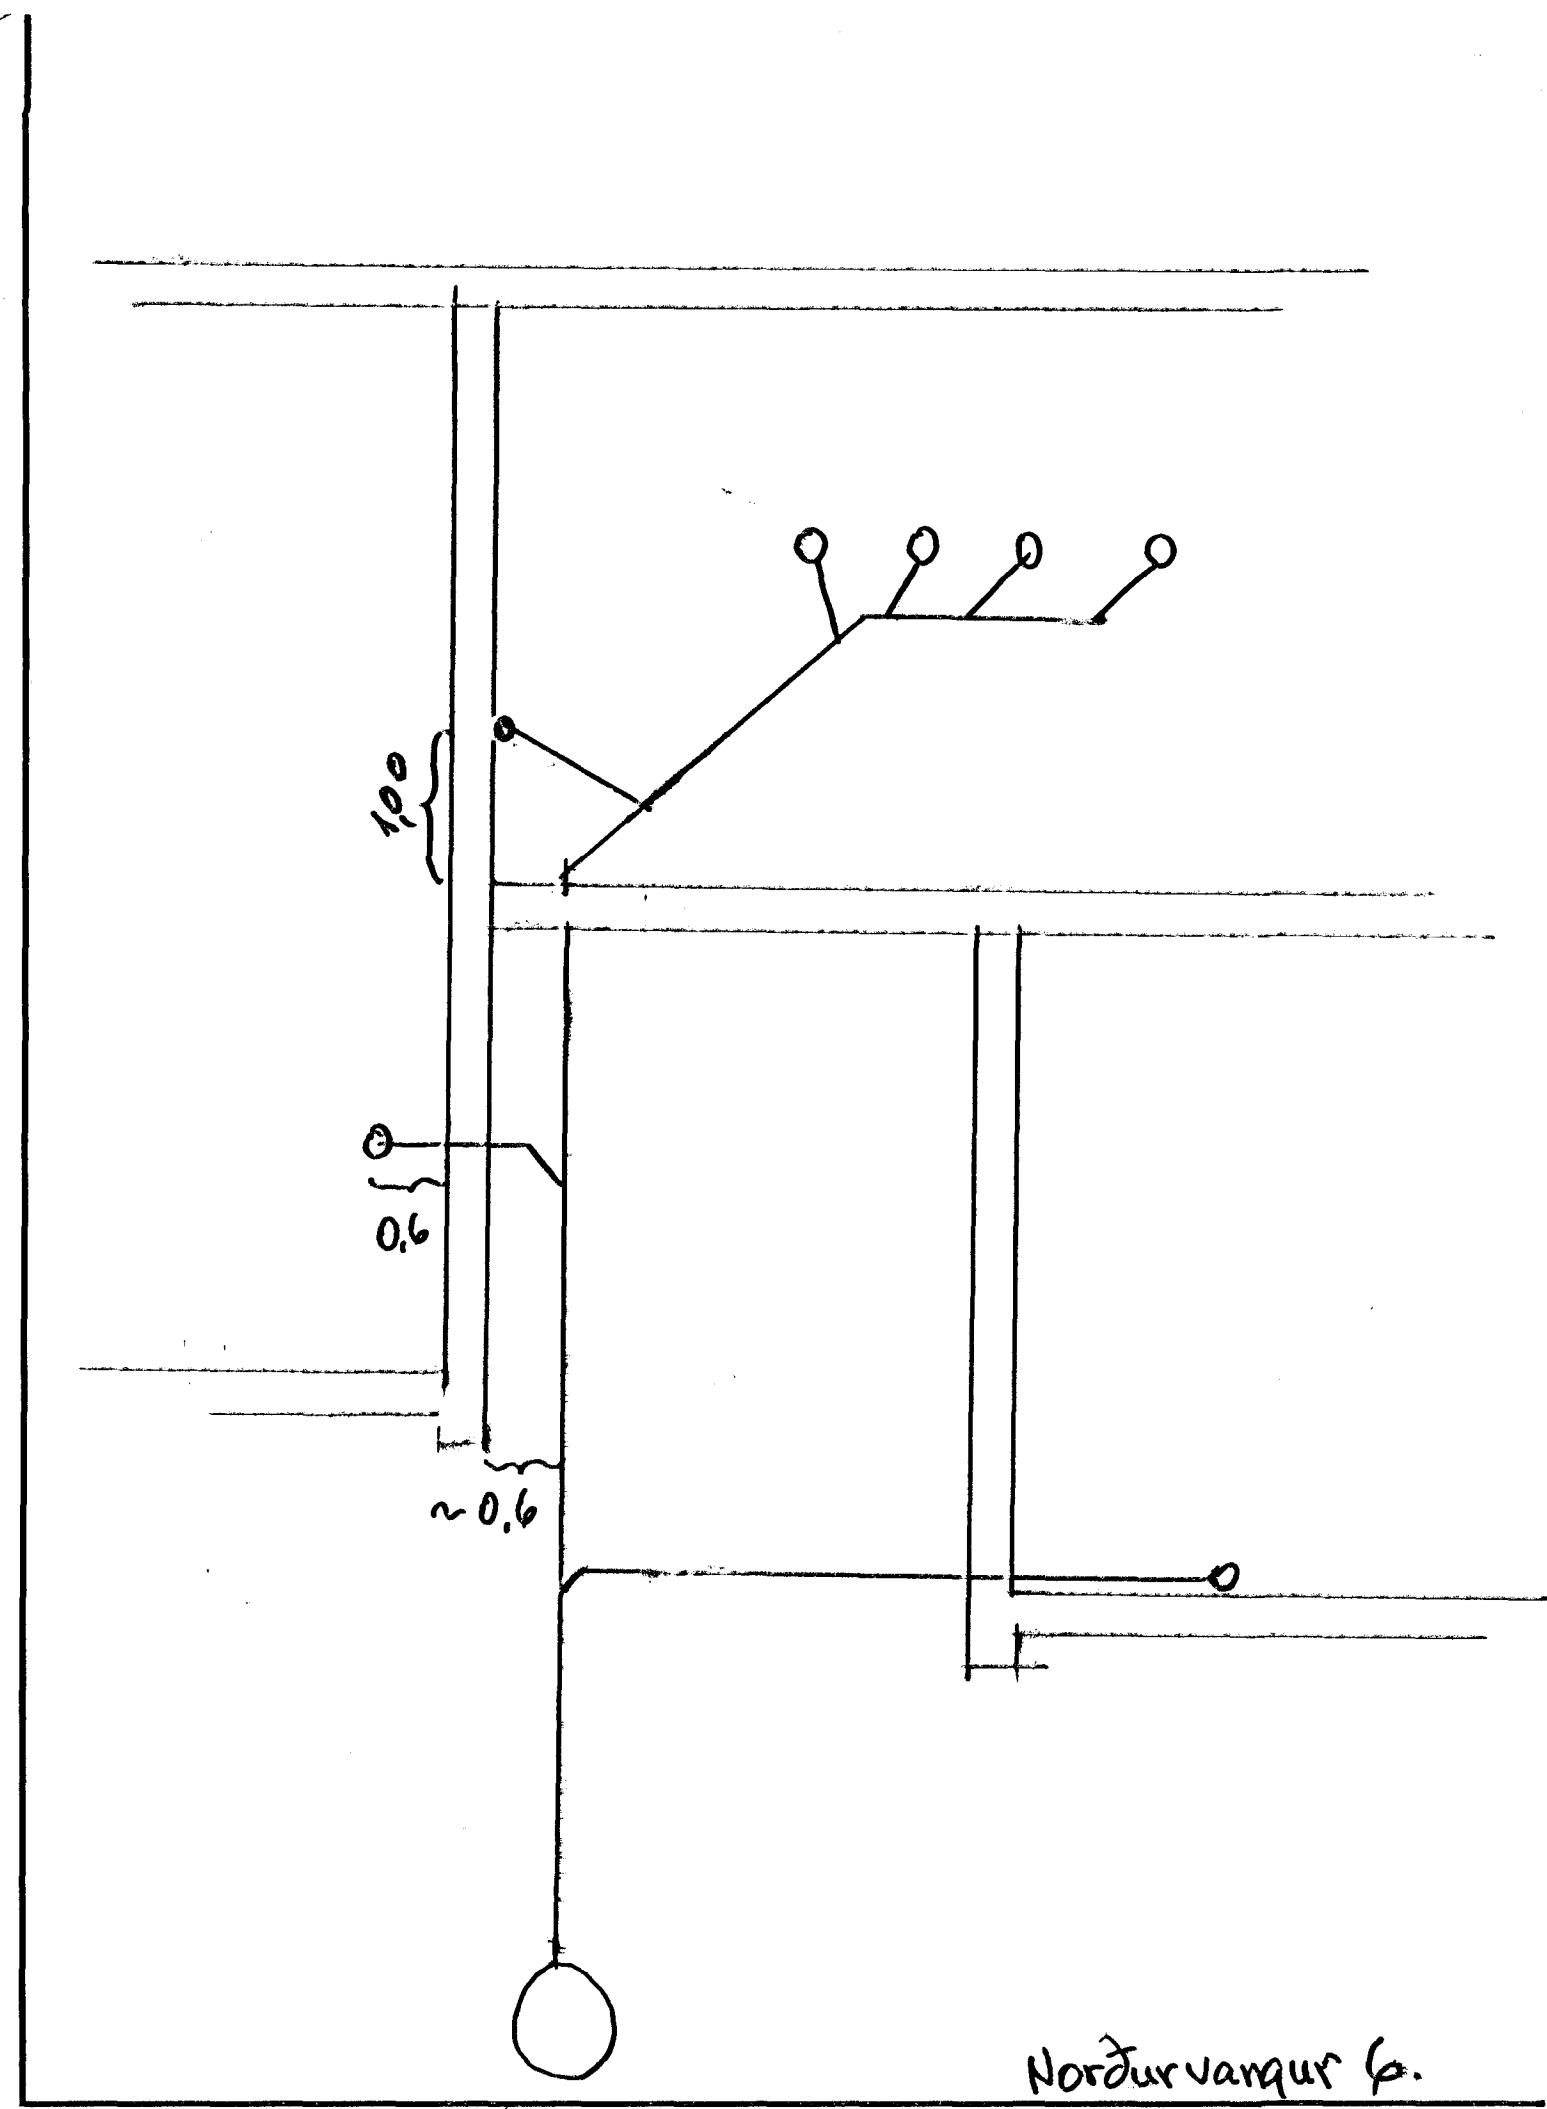

