

ÖLDUGATA 2 HAFNARFIRÐI


EFTIR GLUGGABREYTINGU

Samþykkt þann

20 AUG. 1996


Byggingatulltrúnn / Hafnarfirði
Erlendur Hjálmarsson

ATH. BÍÐGUNARÞOP

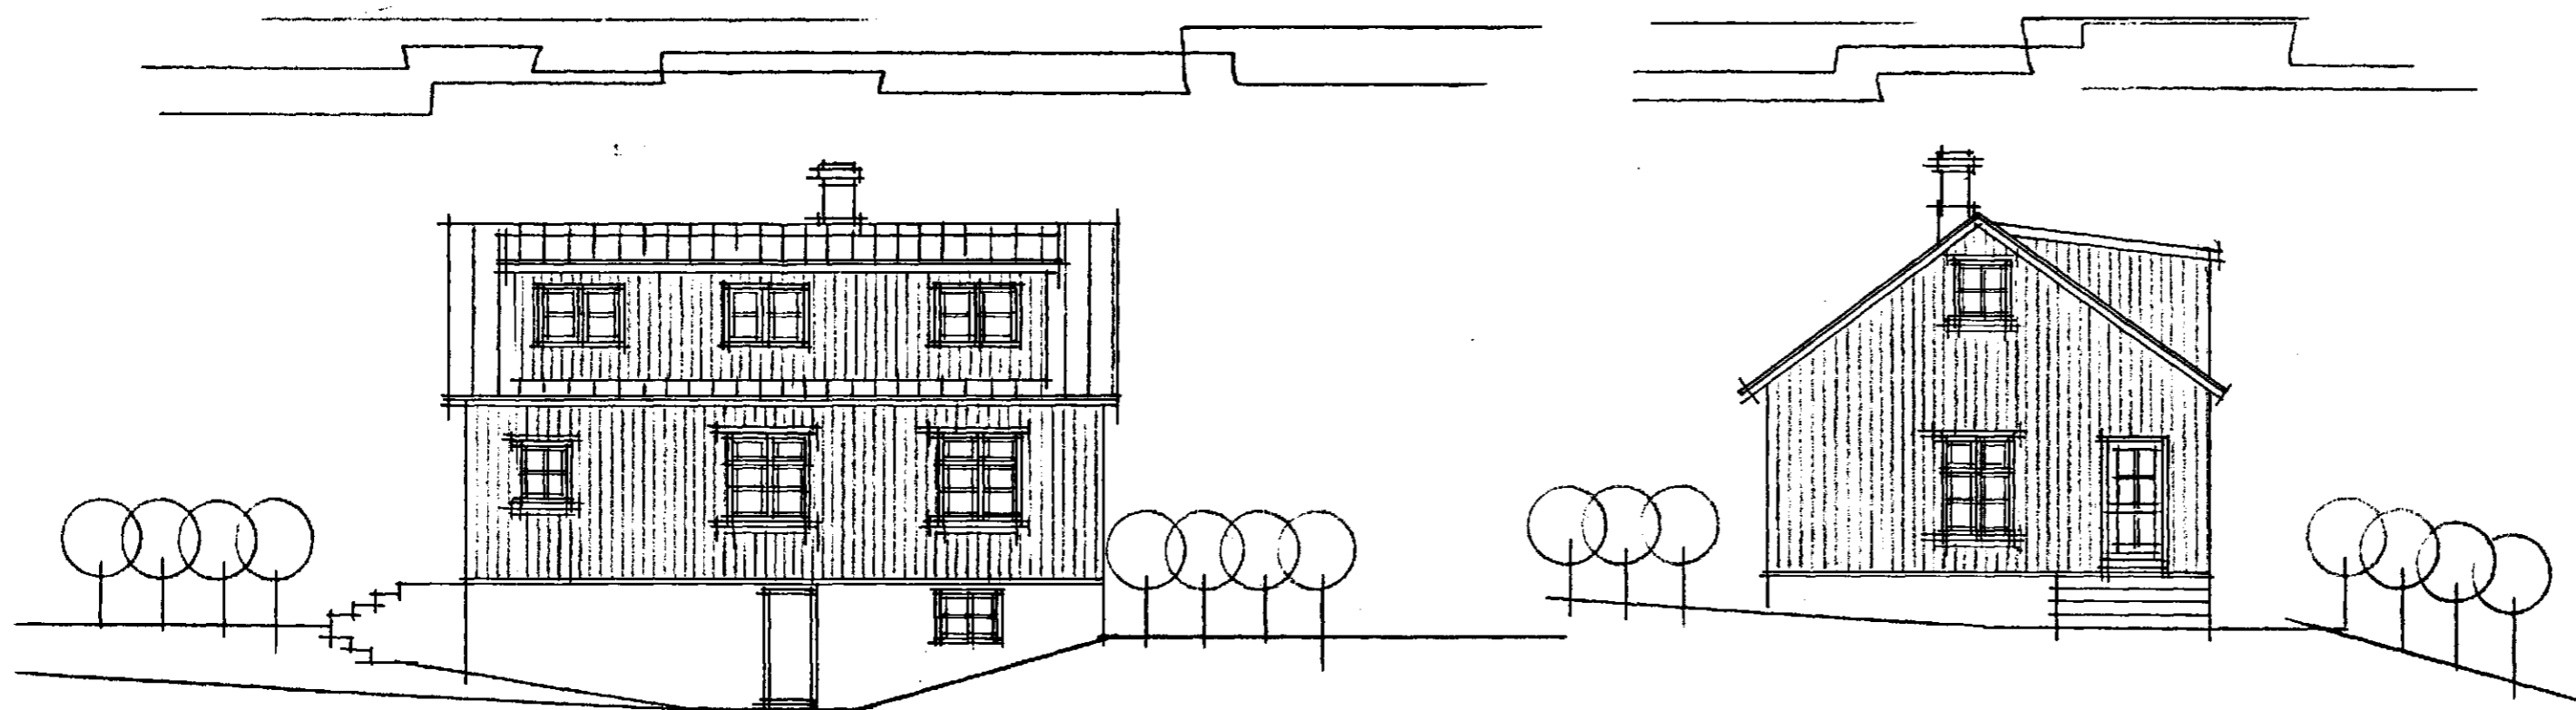


NORD-VESTUR


NORÐ-AUSTUR

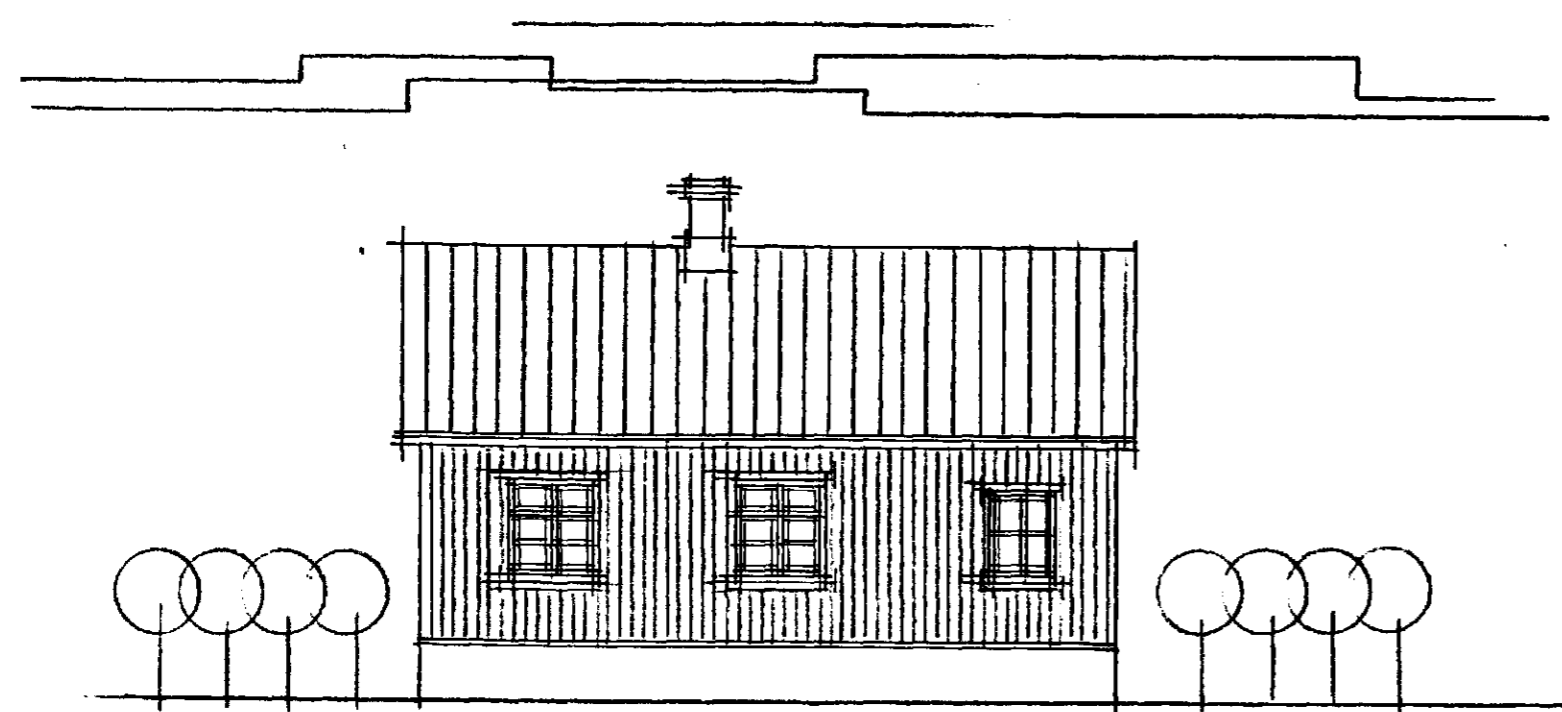

SUÐ-AUSTUR

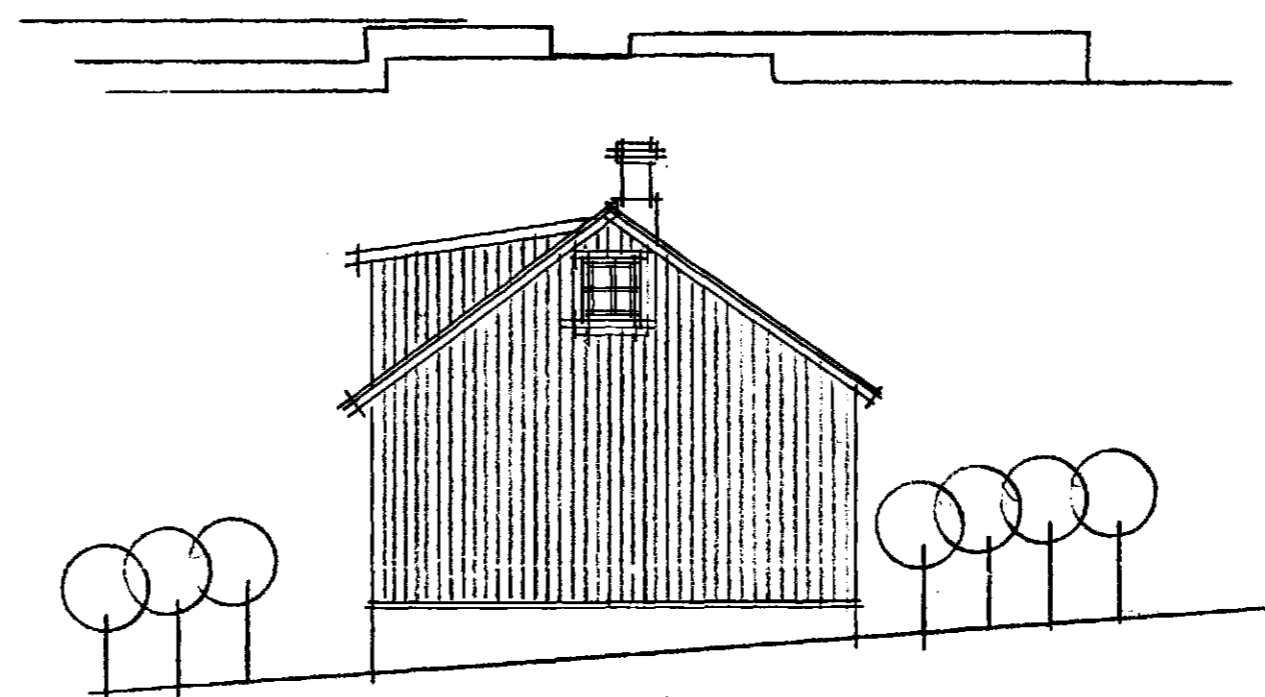

SUÐ-VESTUR

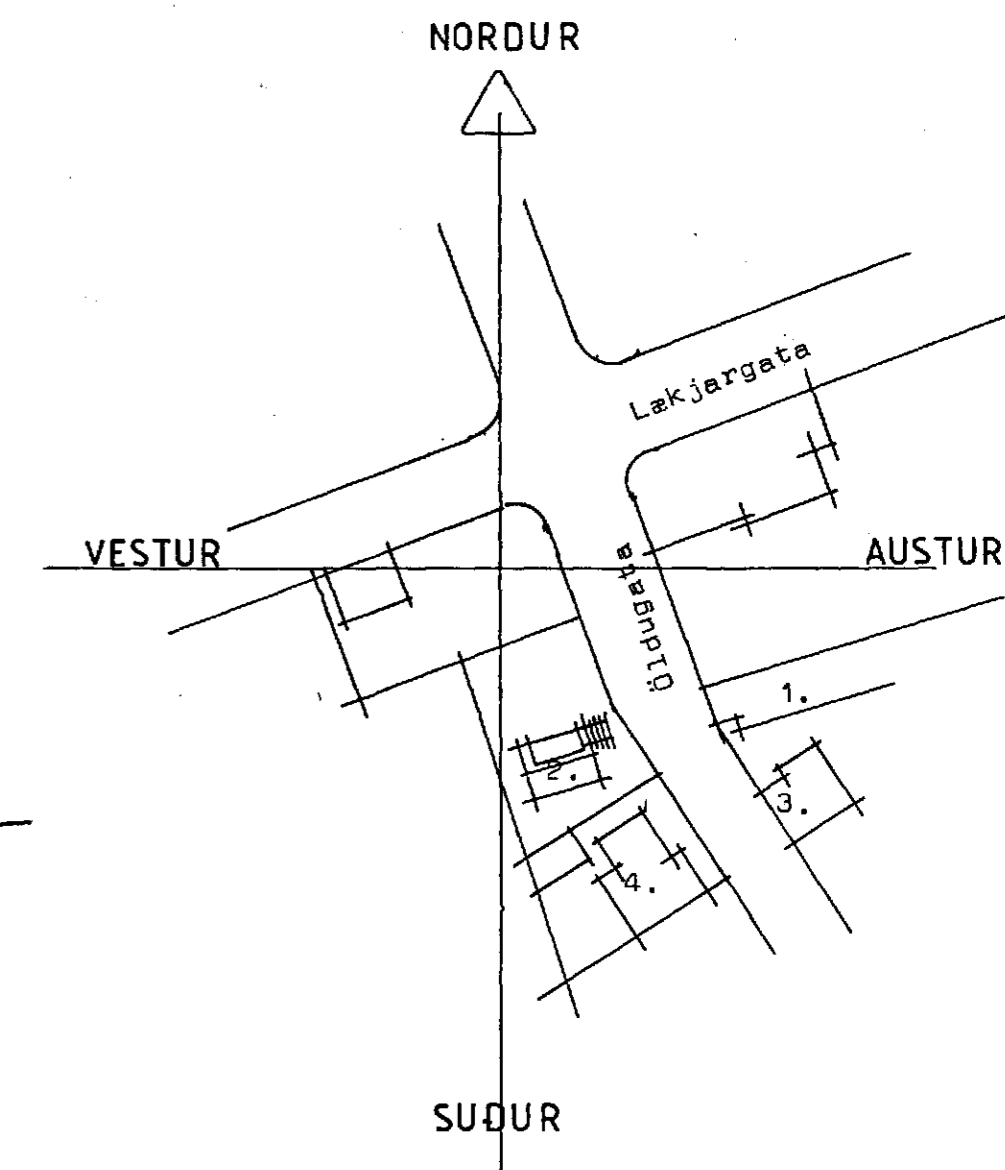

AFSTÖÐUMYND MK 1:1000

KT 270738 4439

B1. 2.

TEIKNISTOFAN HÁALEITI

Sími 5536239 • Háaleitisbraut 125 • 108 Reykjavík

Öldugata 2 Hafnarfirði
Gluggabreyting

Dags. 1. ág. 96 Arkv. 1:100 1:1000 Verk nr. 9612

Erlendur Hjálmarsson

Erlendur Hjálmarsson