
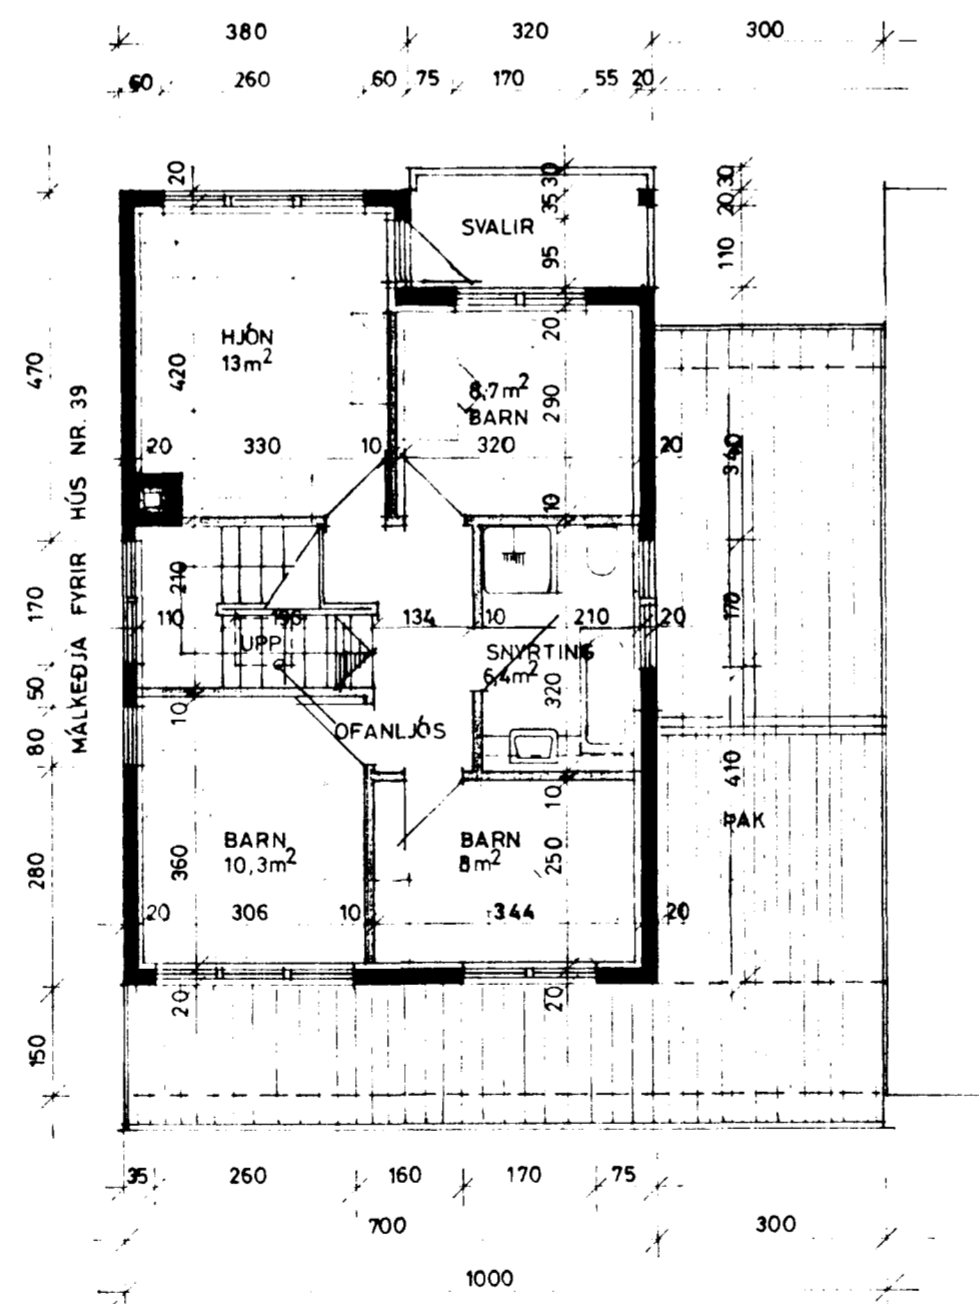
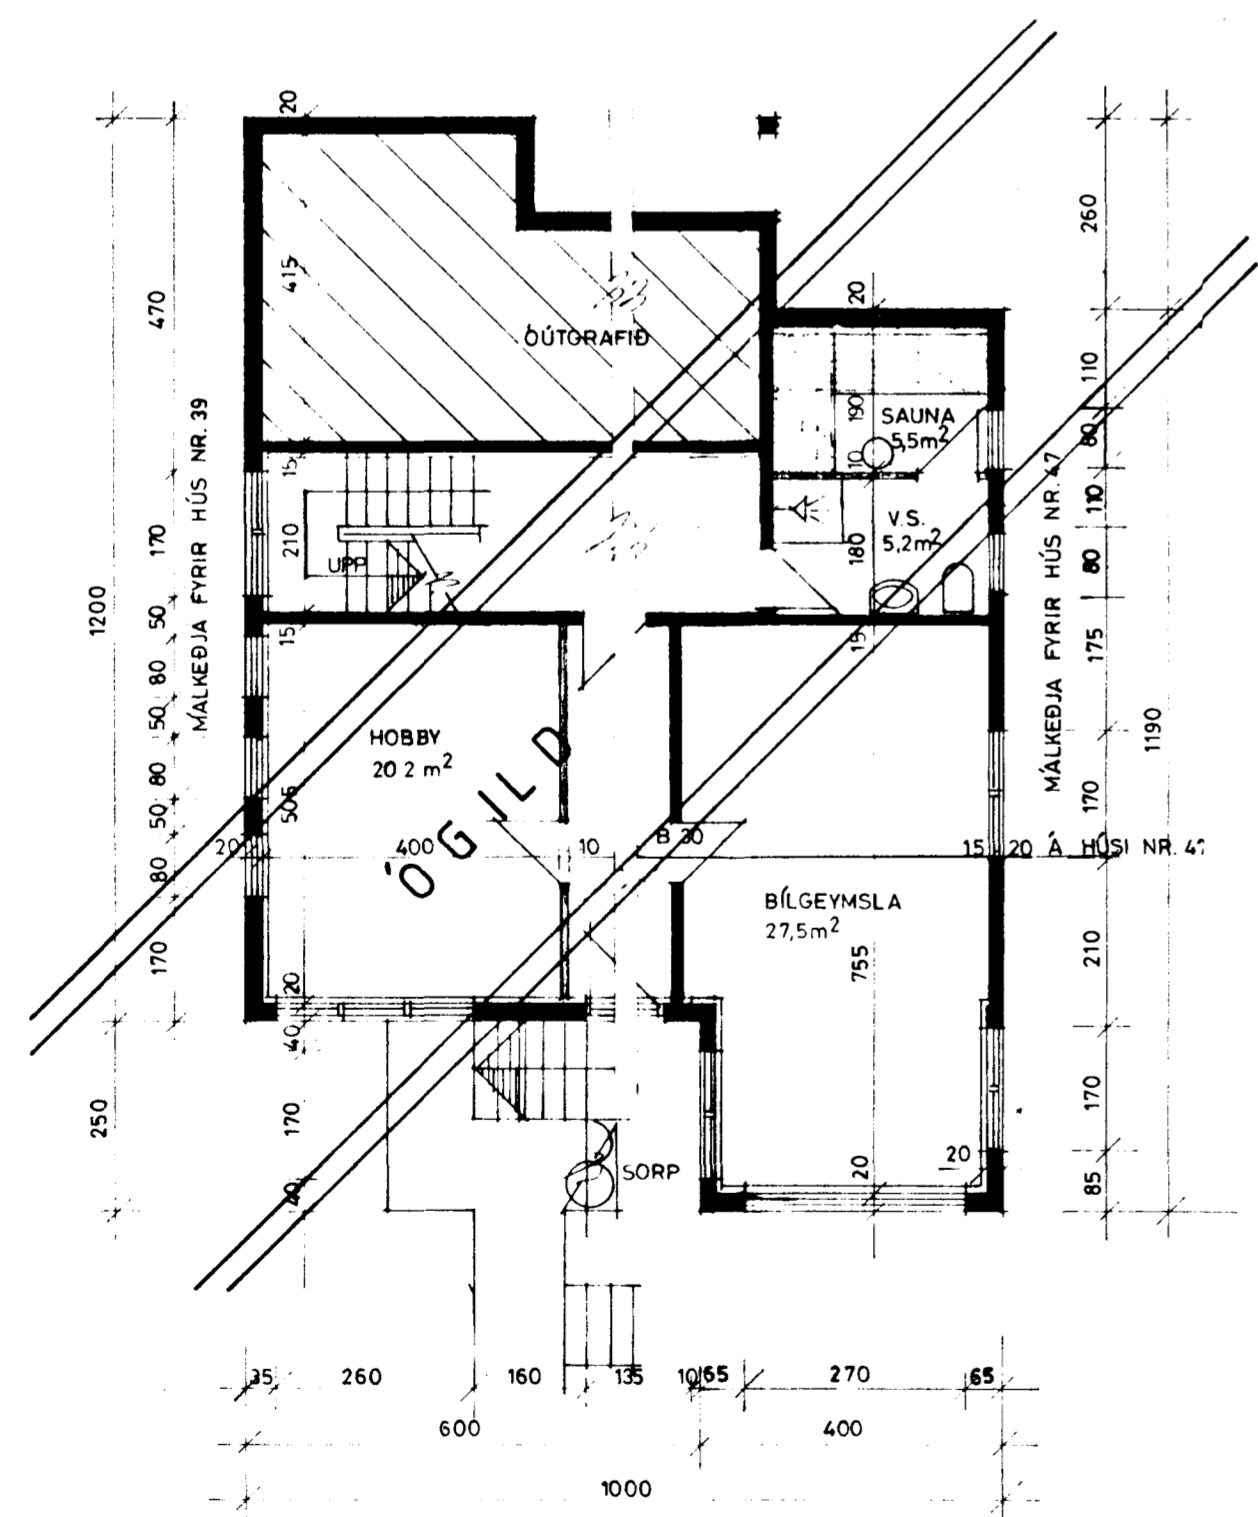
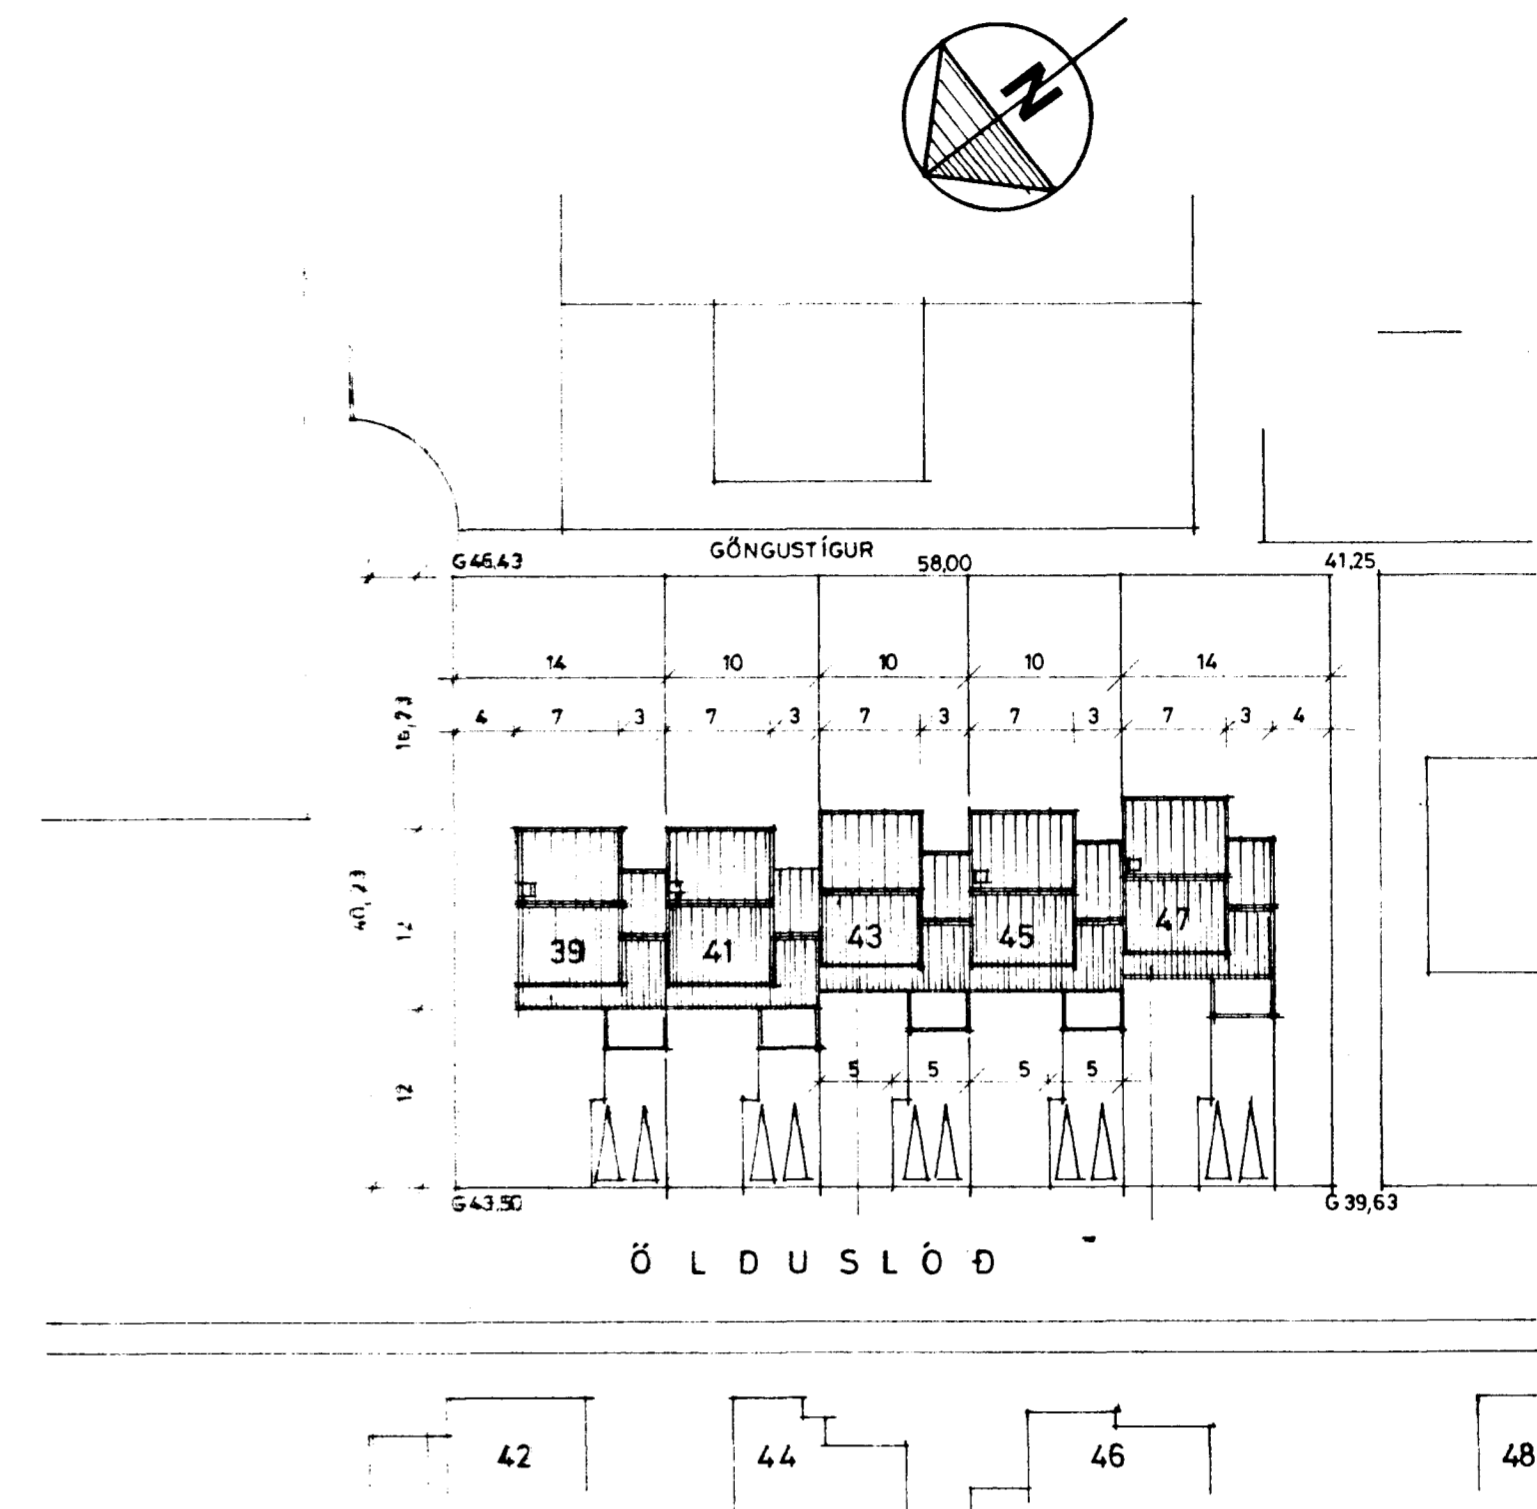


Sambykkt á fundi bygginga-
nefndar 20/1/1982
BYGGINGARLÖG
I HAFNARFIRI
[Signature]

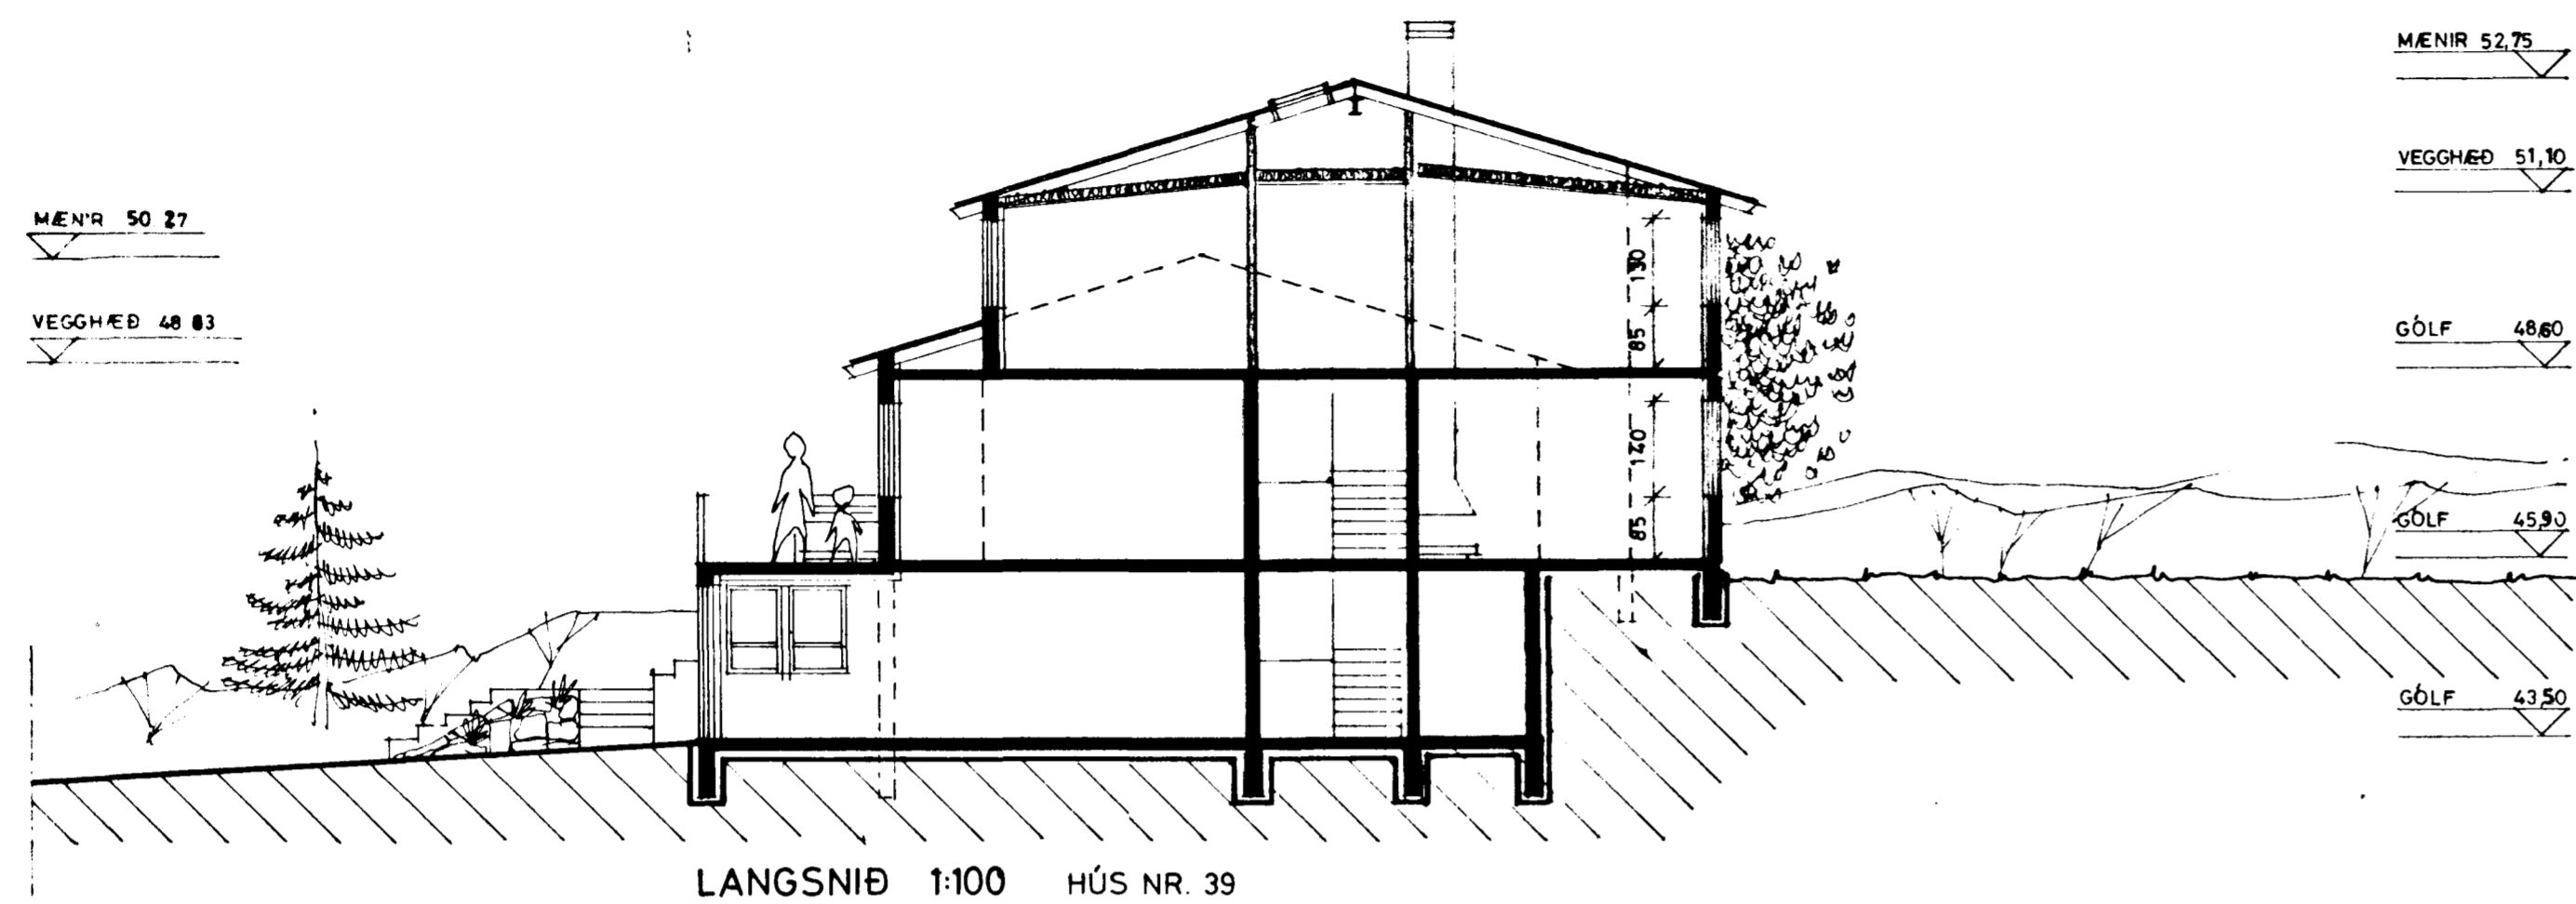

AFSTÖÐUMYND 1:500

STERDIR	BR m ²	BR m ³
KJALLARI	87	217
HÆÐ	104	298
EFRI HÆÐ	69	235
ALLS	260 m ²	750 m ³
NÝTINGARHLÚTFALL 0,22		
KÖLNUN:		
MEDALGILDI VEGGJA	1,0 W/m ² C	
ÞAK	0,3 "	
NEÐSTA PLATA	0,4 "	

TEIKNISTOFAN HRINGBRAUT 56 220 HAFNARFIRDI S 54355
PALL V BJARNASON ARKITEKT FAI

121.03

DAGS	DES. 1981
KYRD	1:100, 1:500
HANNAÐ	PVB
TEIKNAD	PVB

Páll V. Bjarnason