

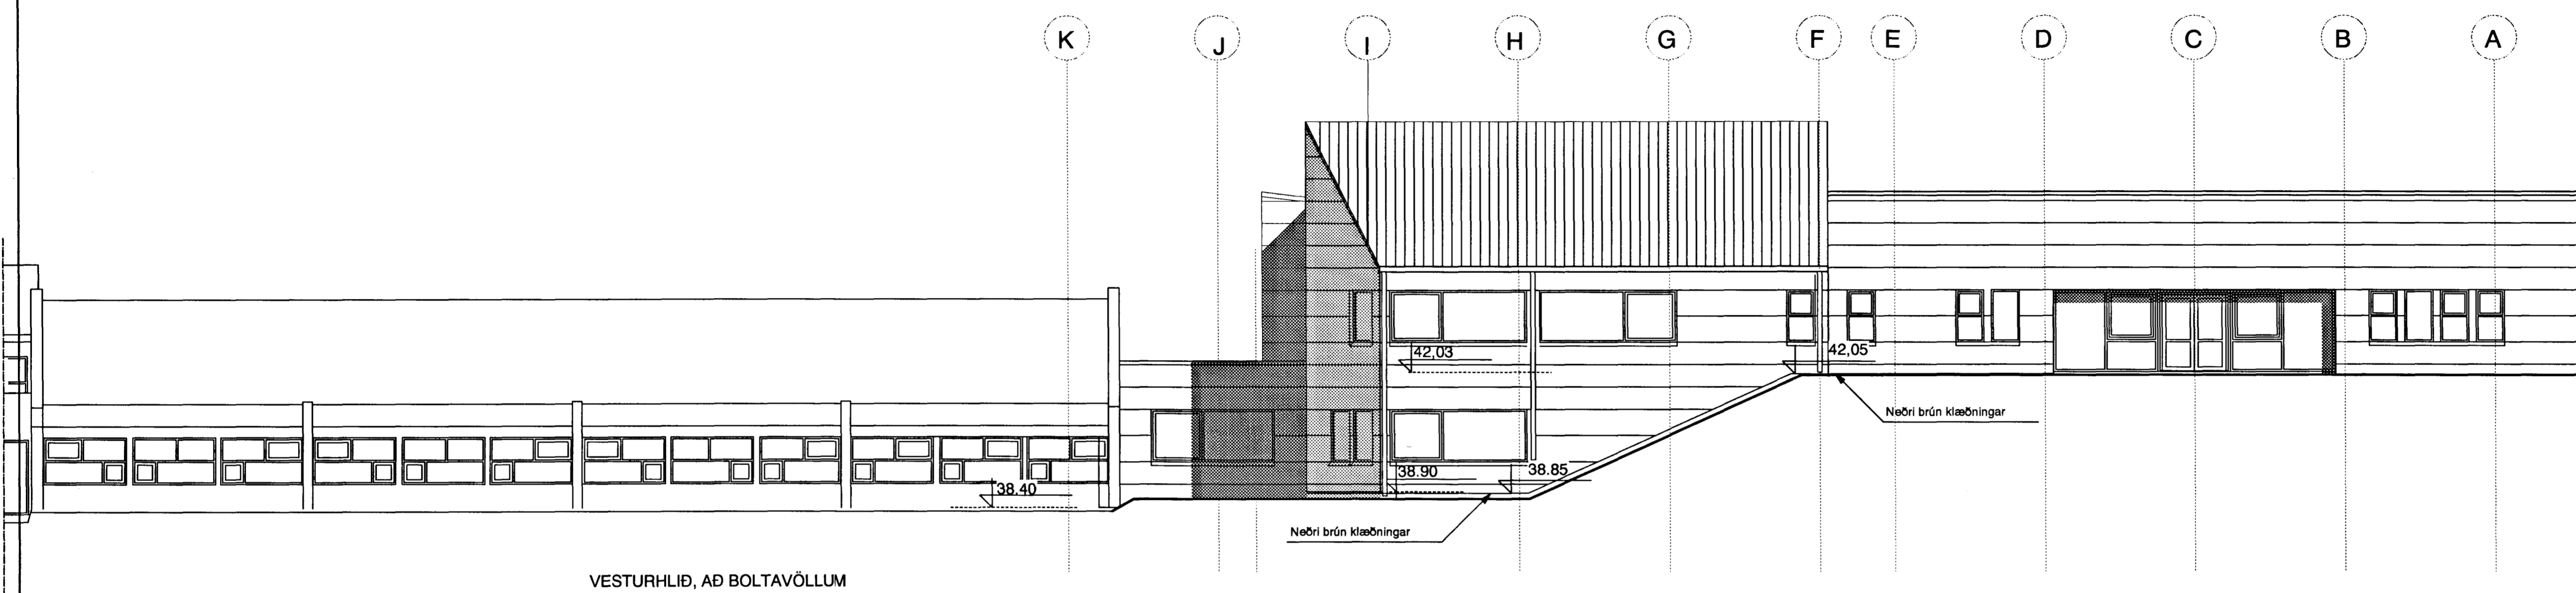
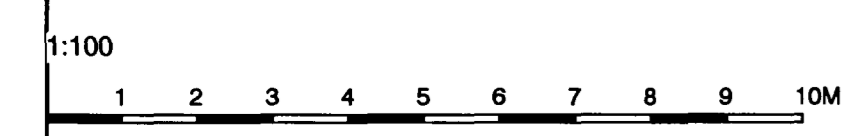


KJP

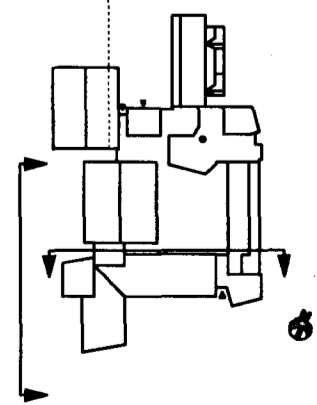

tifftopdf - www.rubissoftware.com - Demo Version

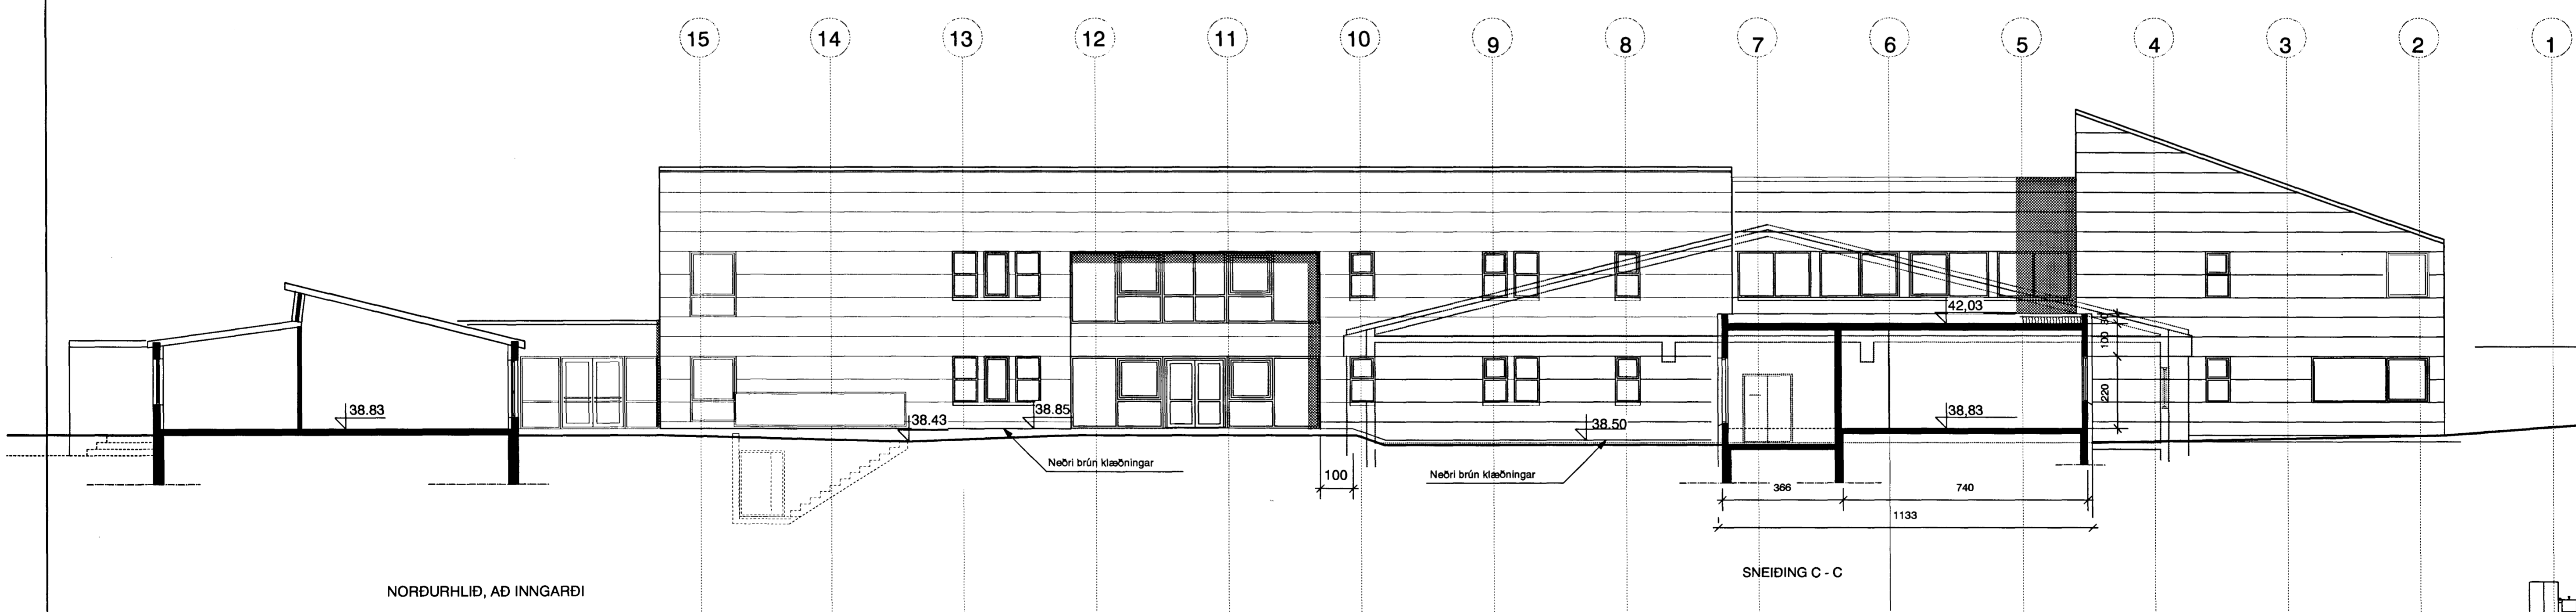

Dags.	Breyting	Tekn.	Útgáfa	Verkhöfi	Verk. nr.	Máv.
20.10.00	Ýmsar breytingar, reyndarteikning			ÖLDUTÚN 9 - HAFNARFIRÐI Öldutúnsskóli - Útlit E-húss	3723	1:100
					PG	Dags. 05.09.97
						Útgáfa.
						AT-06



Arkitektar Skógarhlíð  
 Skógarhlíð 18 105 Reykjavík  
 Sími: 551 1010 Fax: 562 0588  
 www.arkitektar.is

Fall Gunnlaugsson arkitekt FAÍ. Kt. 210552-2199