


KP

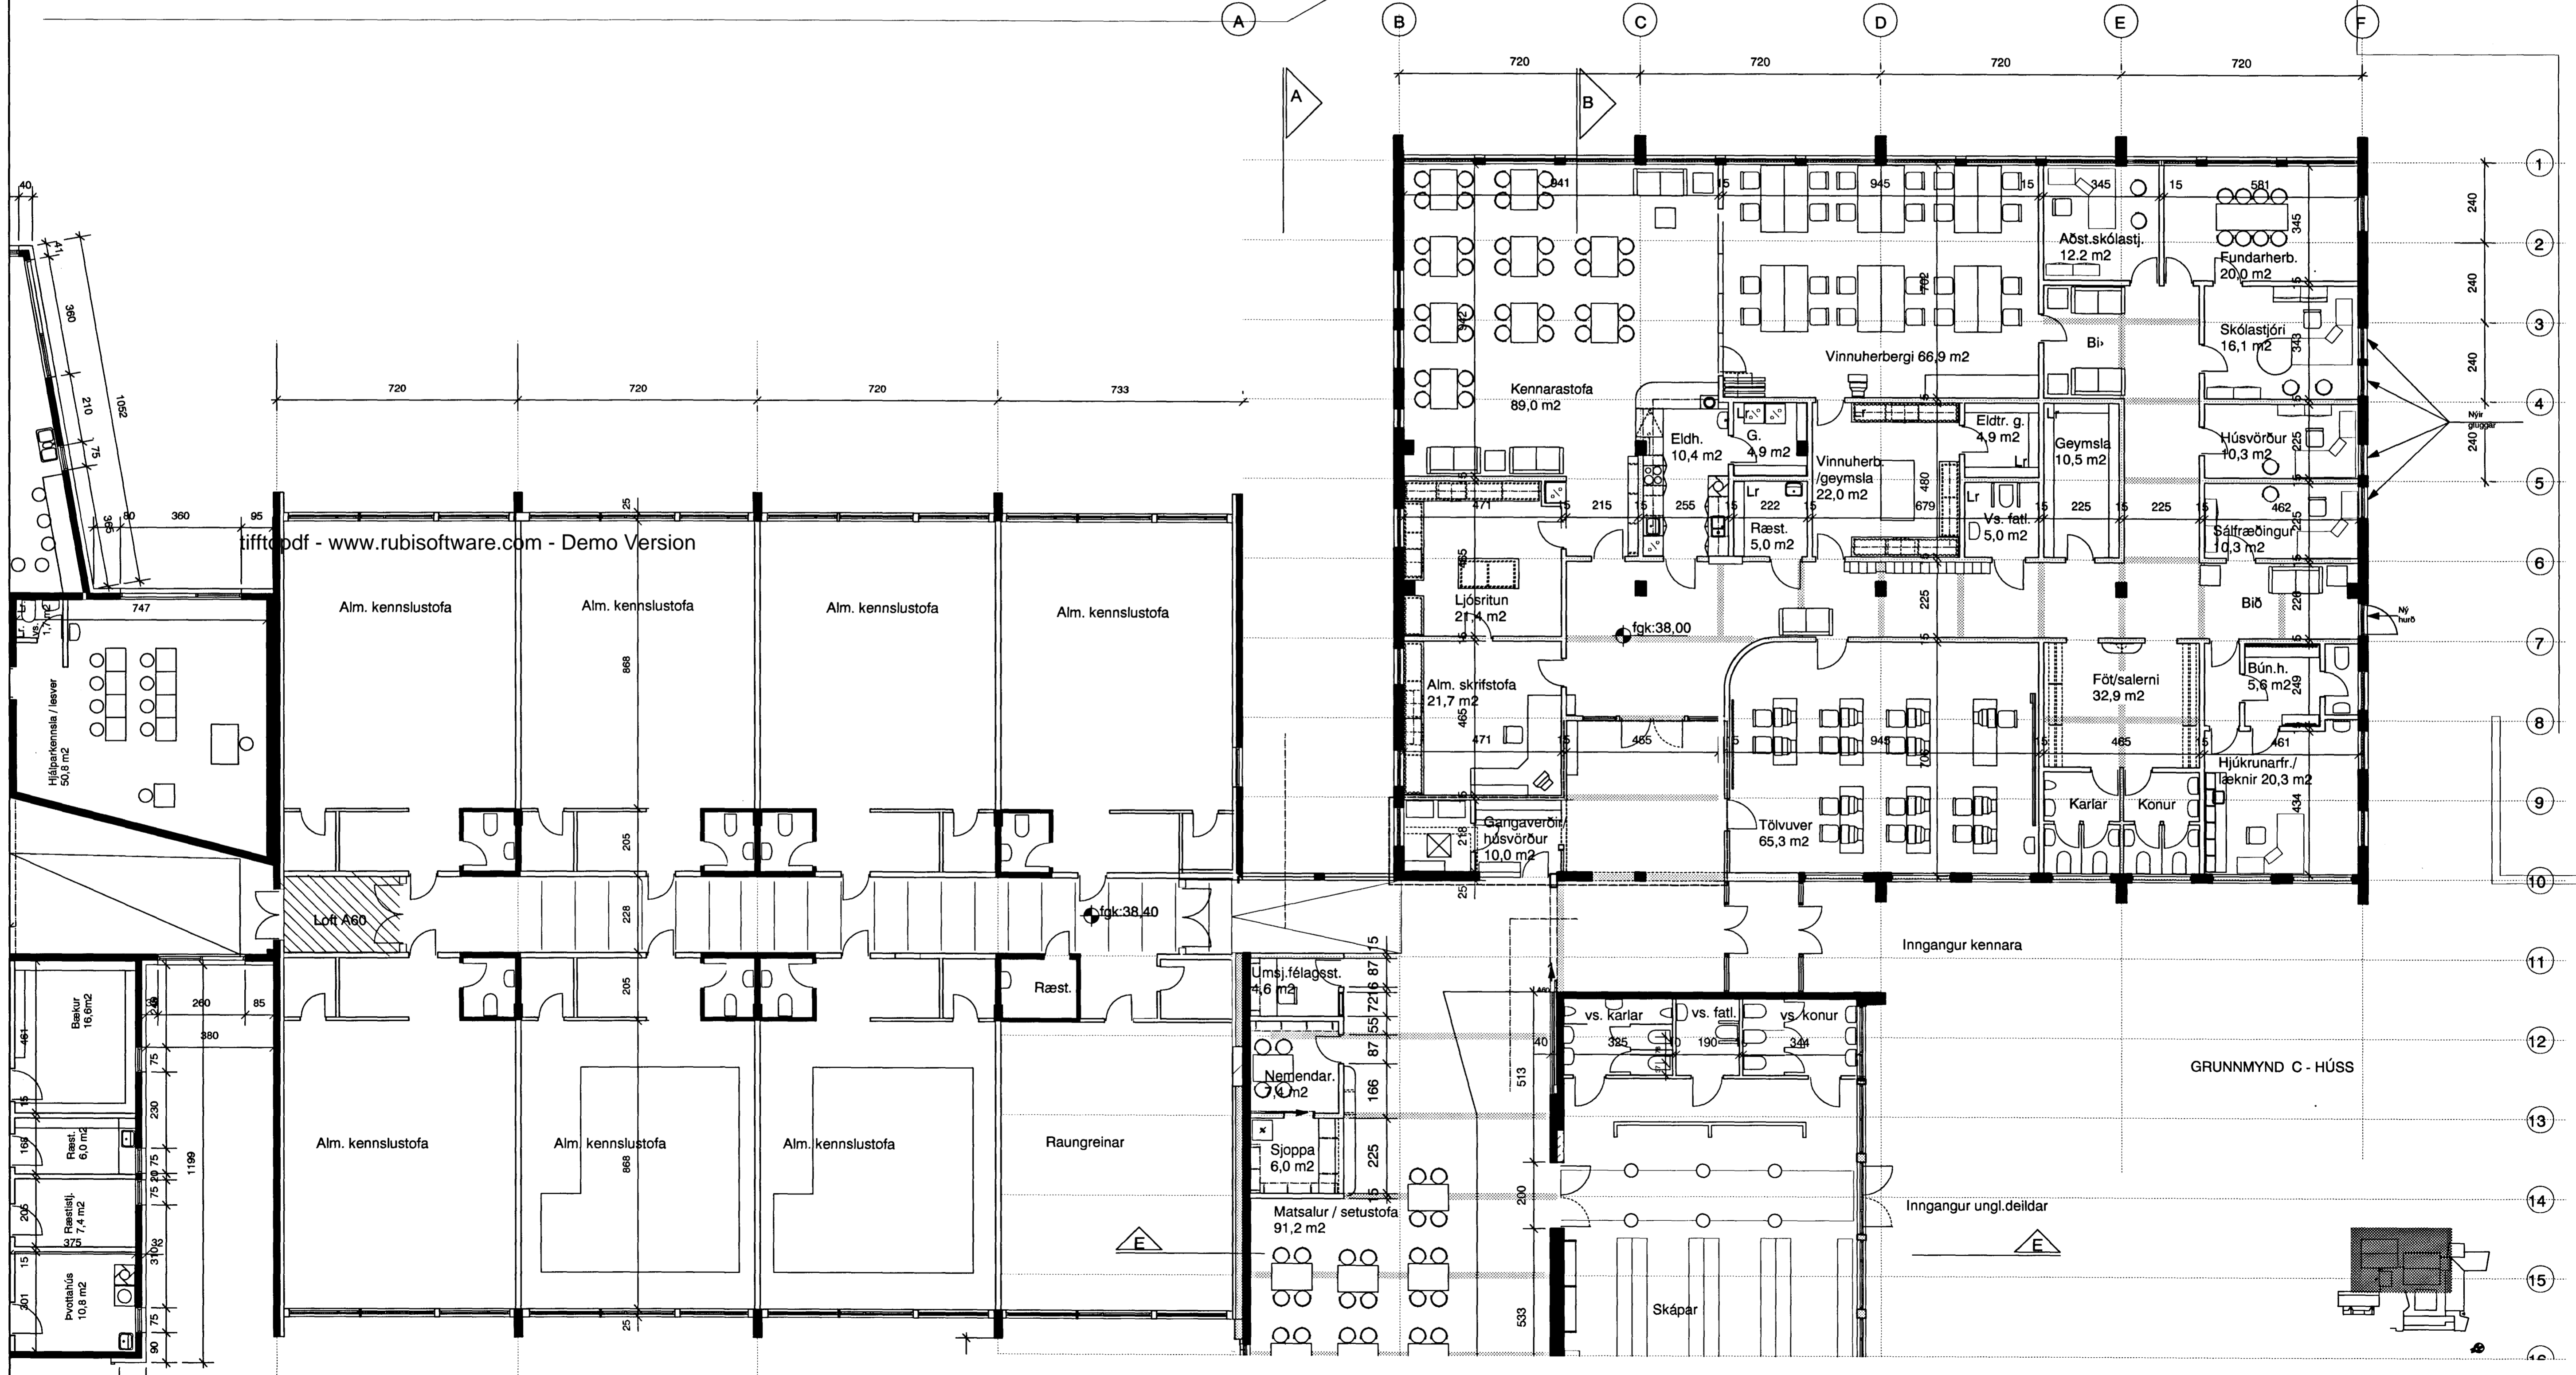

1:100
1 2 3 4 5 6 7 8 9 10M

GRUNNMYND C - HÚSS

| Daga | Breyting | Talnr. | Útgáfa |
|----------|----------------------------------|--------|--------|
| 20.10.00 | Ymsar breytingar, reyndartekning | | |
| | | | |
| | | | |



Verkhv. ÖLDUTÚN 9 - HAFNARFIRÐI
Öldutúnskóli - Grunnmynd 1. hæð C og D-hús
Páll Gunnlaugsson arkitekt FAI, Kt. 210552-2199

| Verk. nr. | Máv. |
|-----------|----------|
| 9723 | 1:100 |
| Tekn. nr. | Dag. |
| PG | 04.01.98 |
| Tekn. nr. | Útgáfa |
| | |

AT-11