



KP


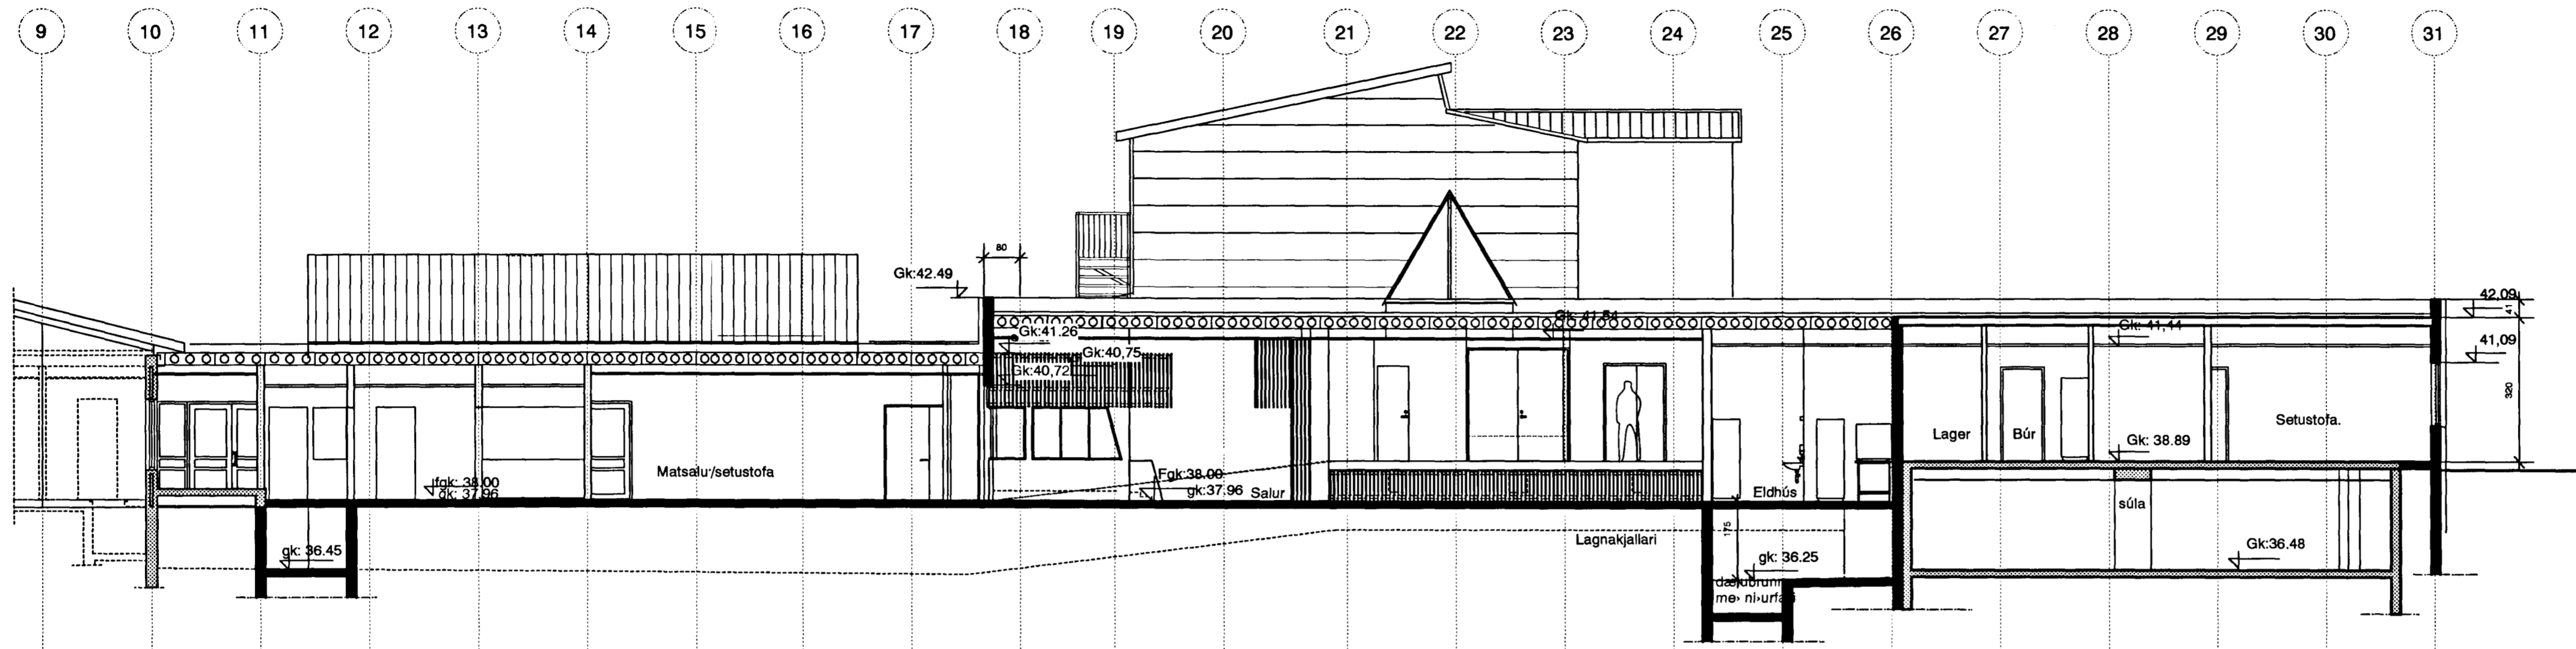


SNEIING A - A

tifftopdf - www.rubissoftware.com - Demo Version

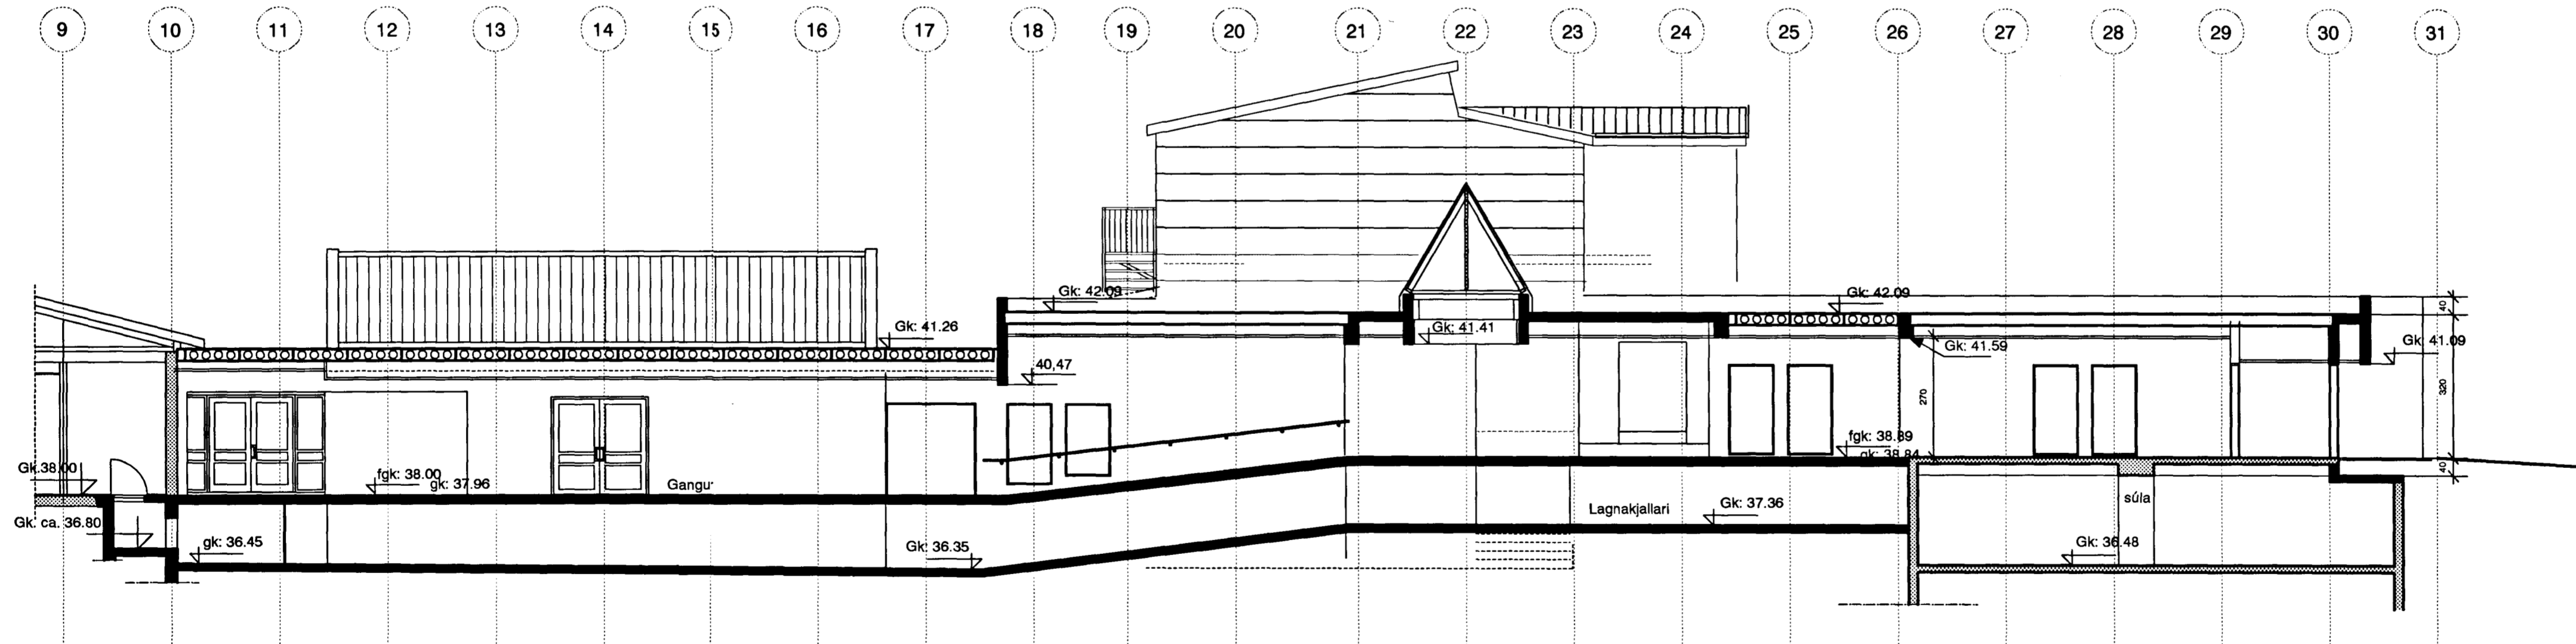

SNEIING B - B

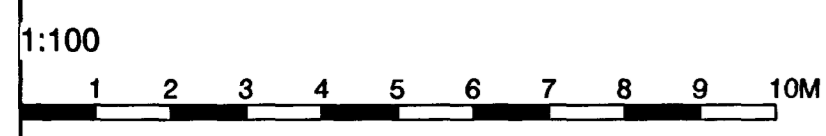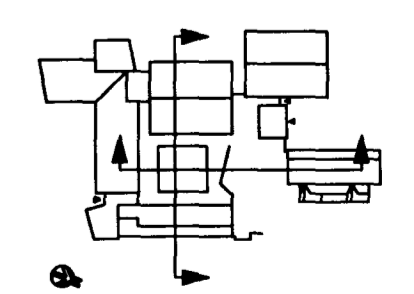

Daga	Breyting	Tekn.	Útgáfa
20.10.00	Ýmsar breytingar, reyndartekning		

Verkefni: ÖLDUTÚN 9 - HAFNARFIRÐI Öldutúnsskóli - Sneiðingar	Verk. nr. 9723	Máv. 1:100
Arkitektar Skógarhlíð Skógarhlíð 18 105 Reykjavík Sími: 551 1010 Fax: 552 0508 www.arkitektar.is	Tekn. PG Útgáfa.	Útgáfa.
Páll Gunnlaugsson arkitekt FAL, Kt. 210552-2199	AT-12	