



KP

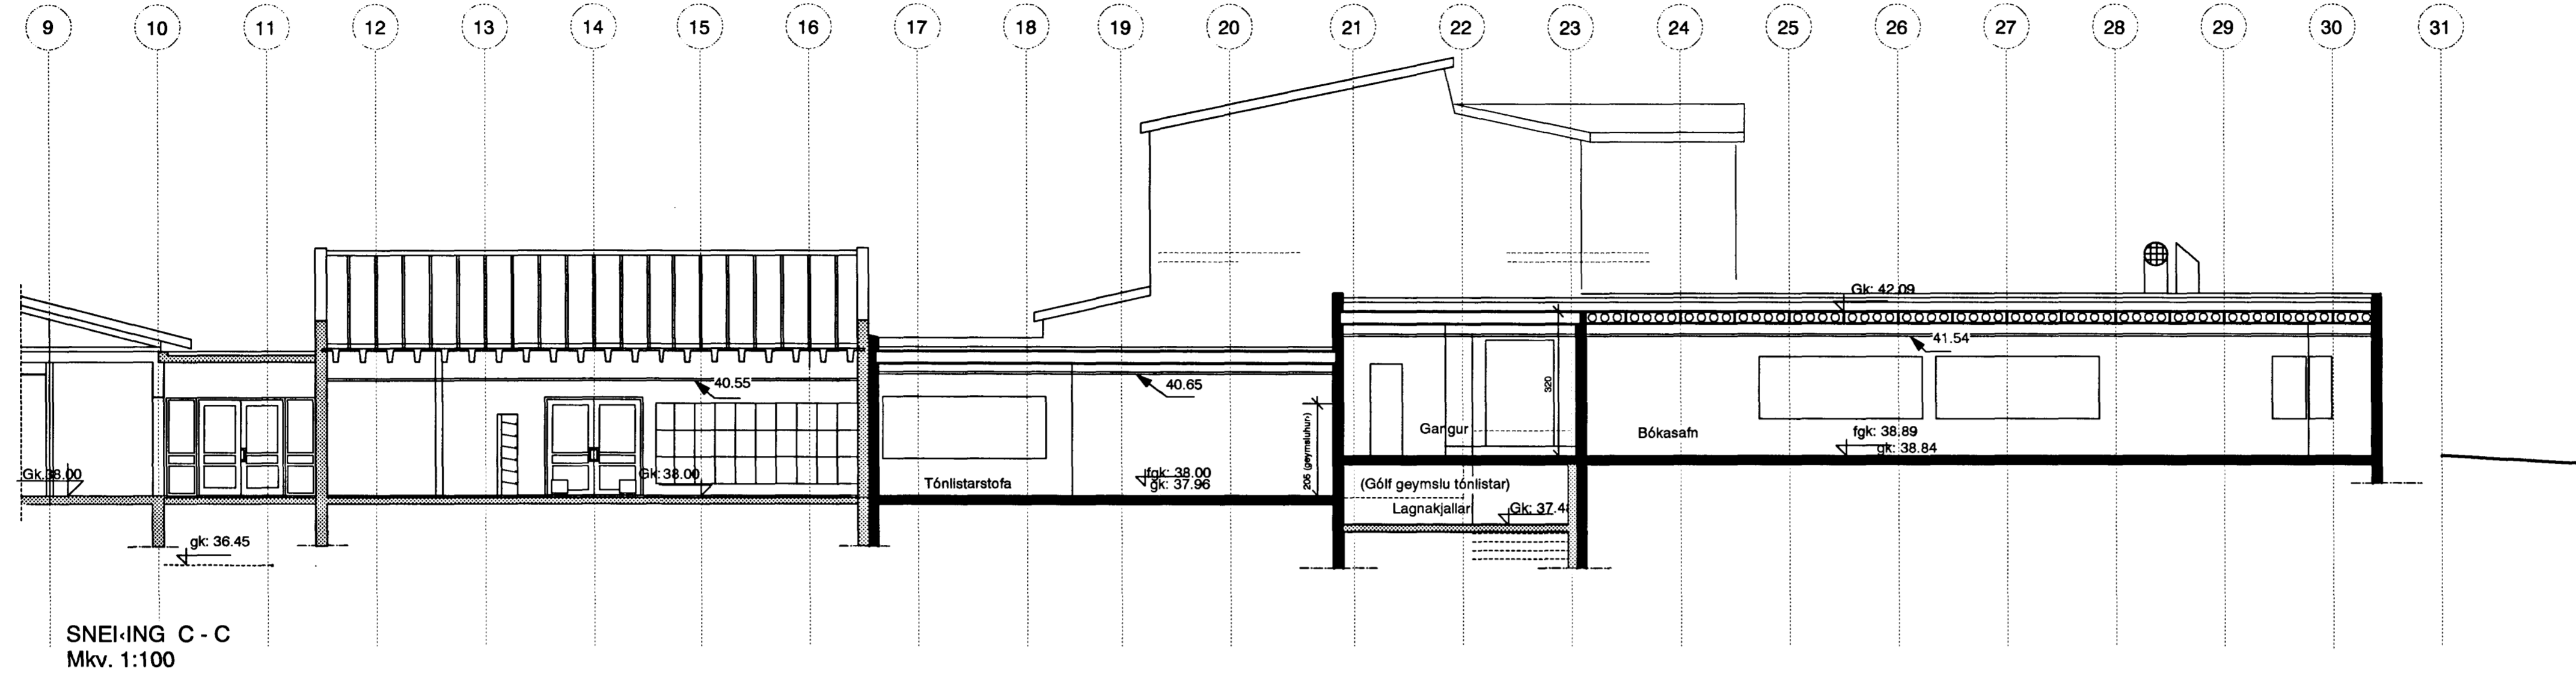



SNEIÞING C - C
Mkv. 1:100

tiffpdf - www.rubissoftware.com - Demo Version

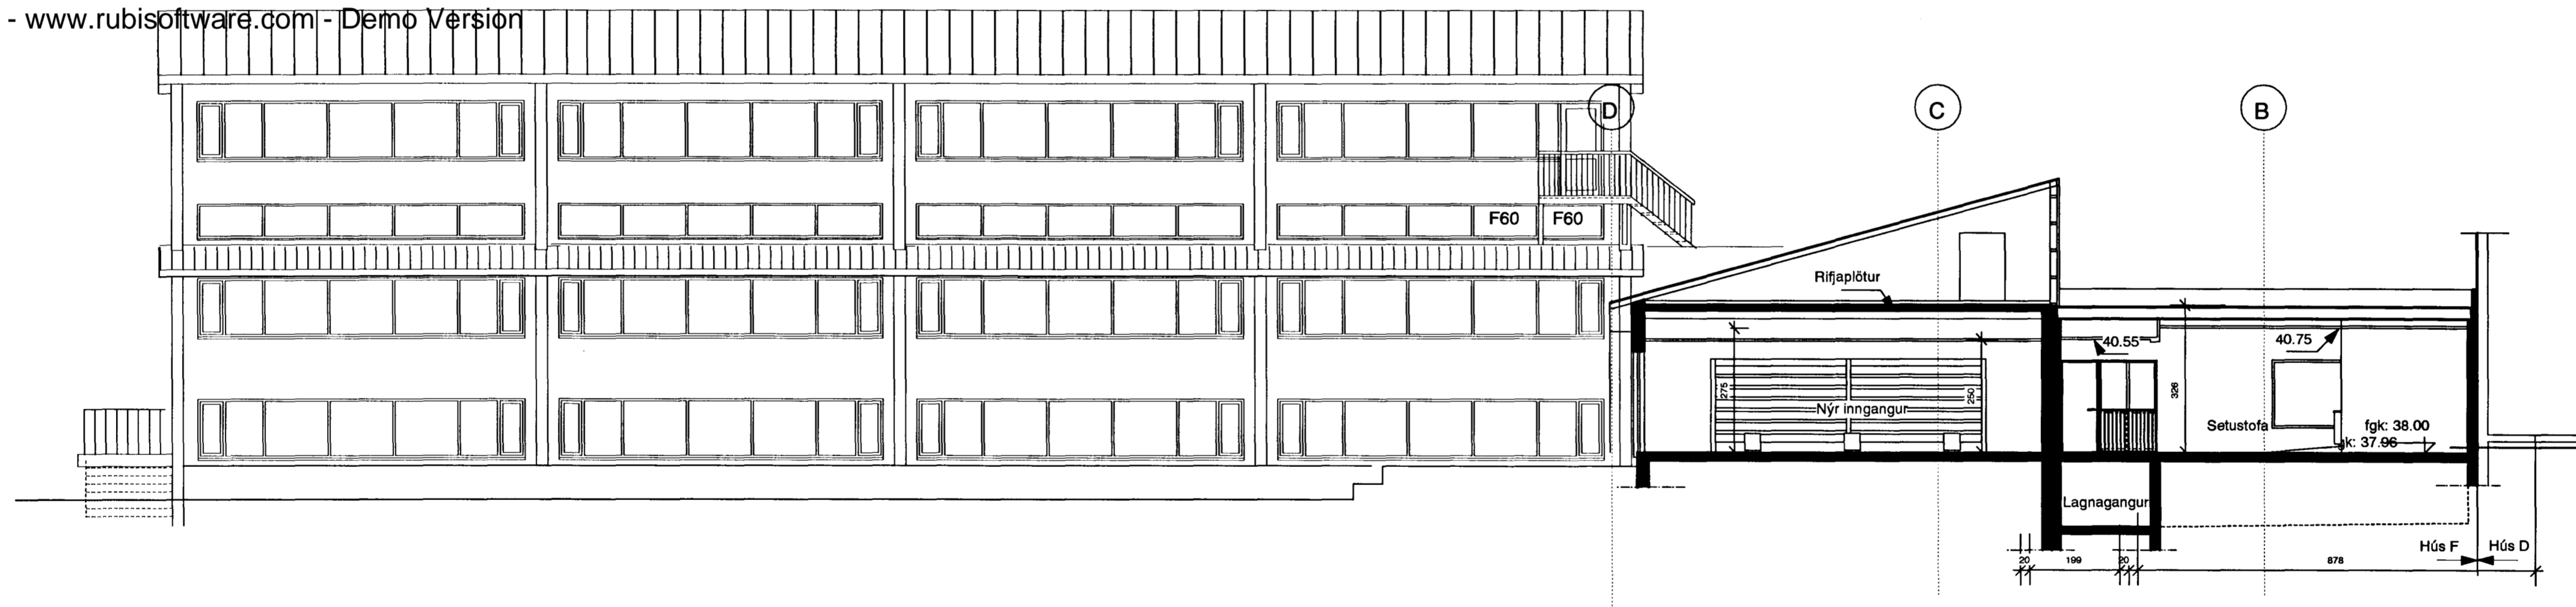

Vesturhlíð

SNEIÞING E-E Mkv. 1:100

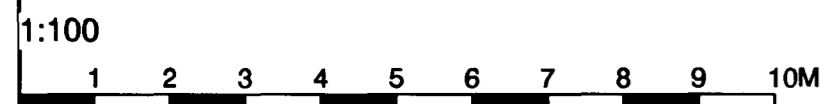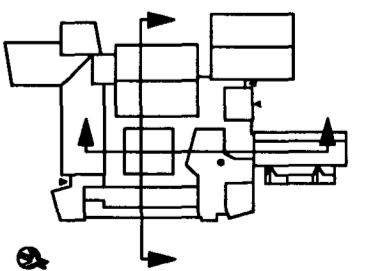

Dags.	Breyting	Telkn.	Útgáfa
20.10.00	Ýmsar breytingar, reyndartekning		

Arkitektar Skógarhlíð
Skógarhlíð 18 105 Reykjavík
Sími 551 1010 Fax: 562 0588
www.arkitektar.is

Verkefni: ÖLDUTÚN 9 - HAFNARFIRÐI Öldutúnsskóli - Sneiðingar-útlit	Verk nr. 9723	Mkv. 1:100
	Telkn. PG	Dags. 04.01.98
	Telkn. nr.	Útgáfa.
Fall Gunnlaugsson arkitekt FAl. Kt. 210552-2199		AT-14