



FISKVERKUNARHÚS HREIFA #/F, STÆKKUN 1:100
 ÓSEYRARBRAUT 9-11, HAFNARFIRÐI

Samþykkt á fundi bygginga-
 nefndar þ. 8/7 1970
 BYGGINGAFULLTRÚINN
 Í HAFNARFIRÐI
[Signature]

BLAD 1

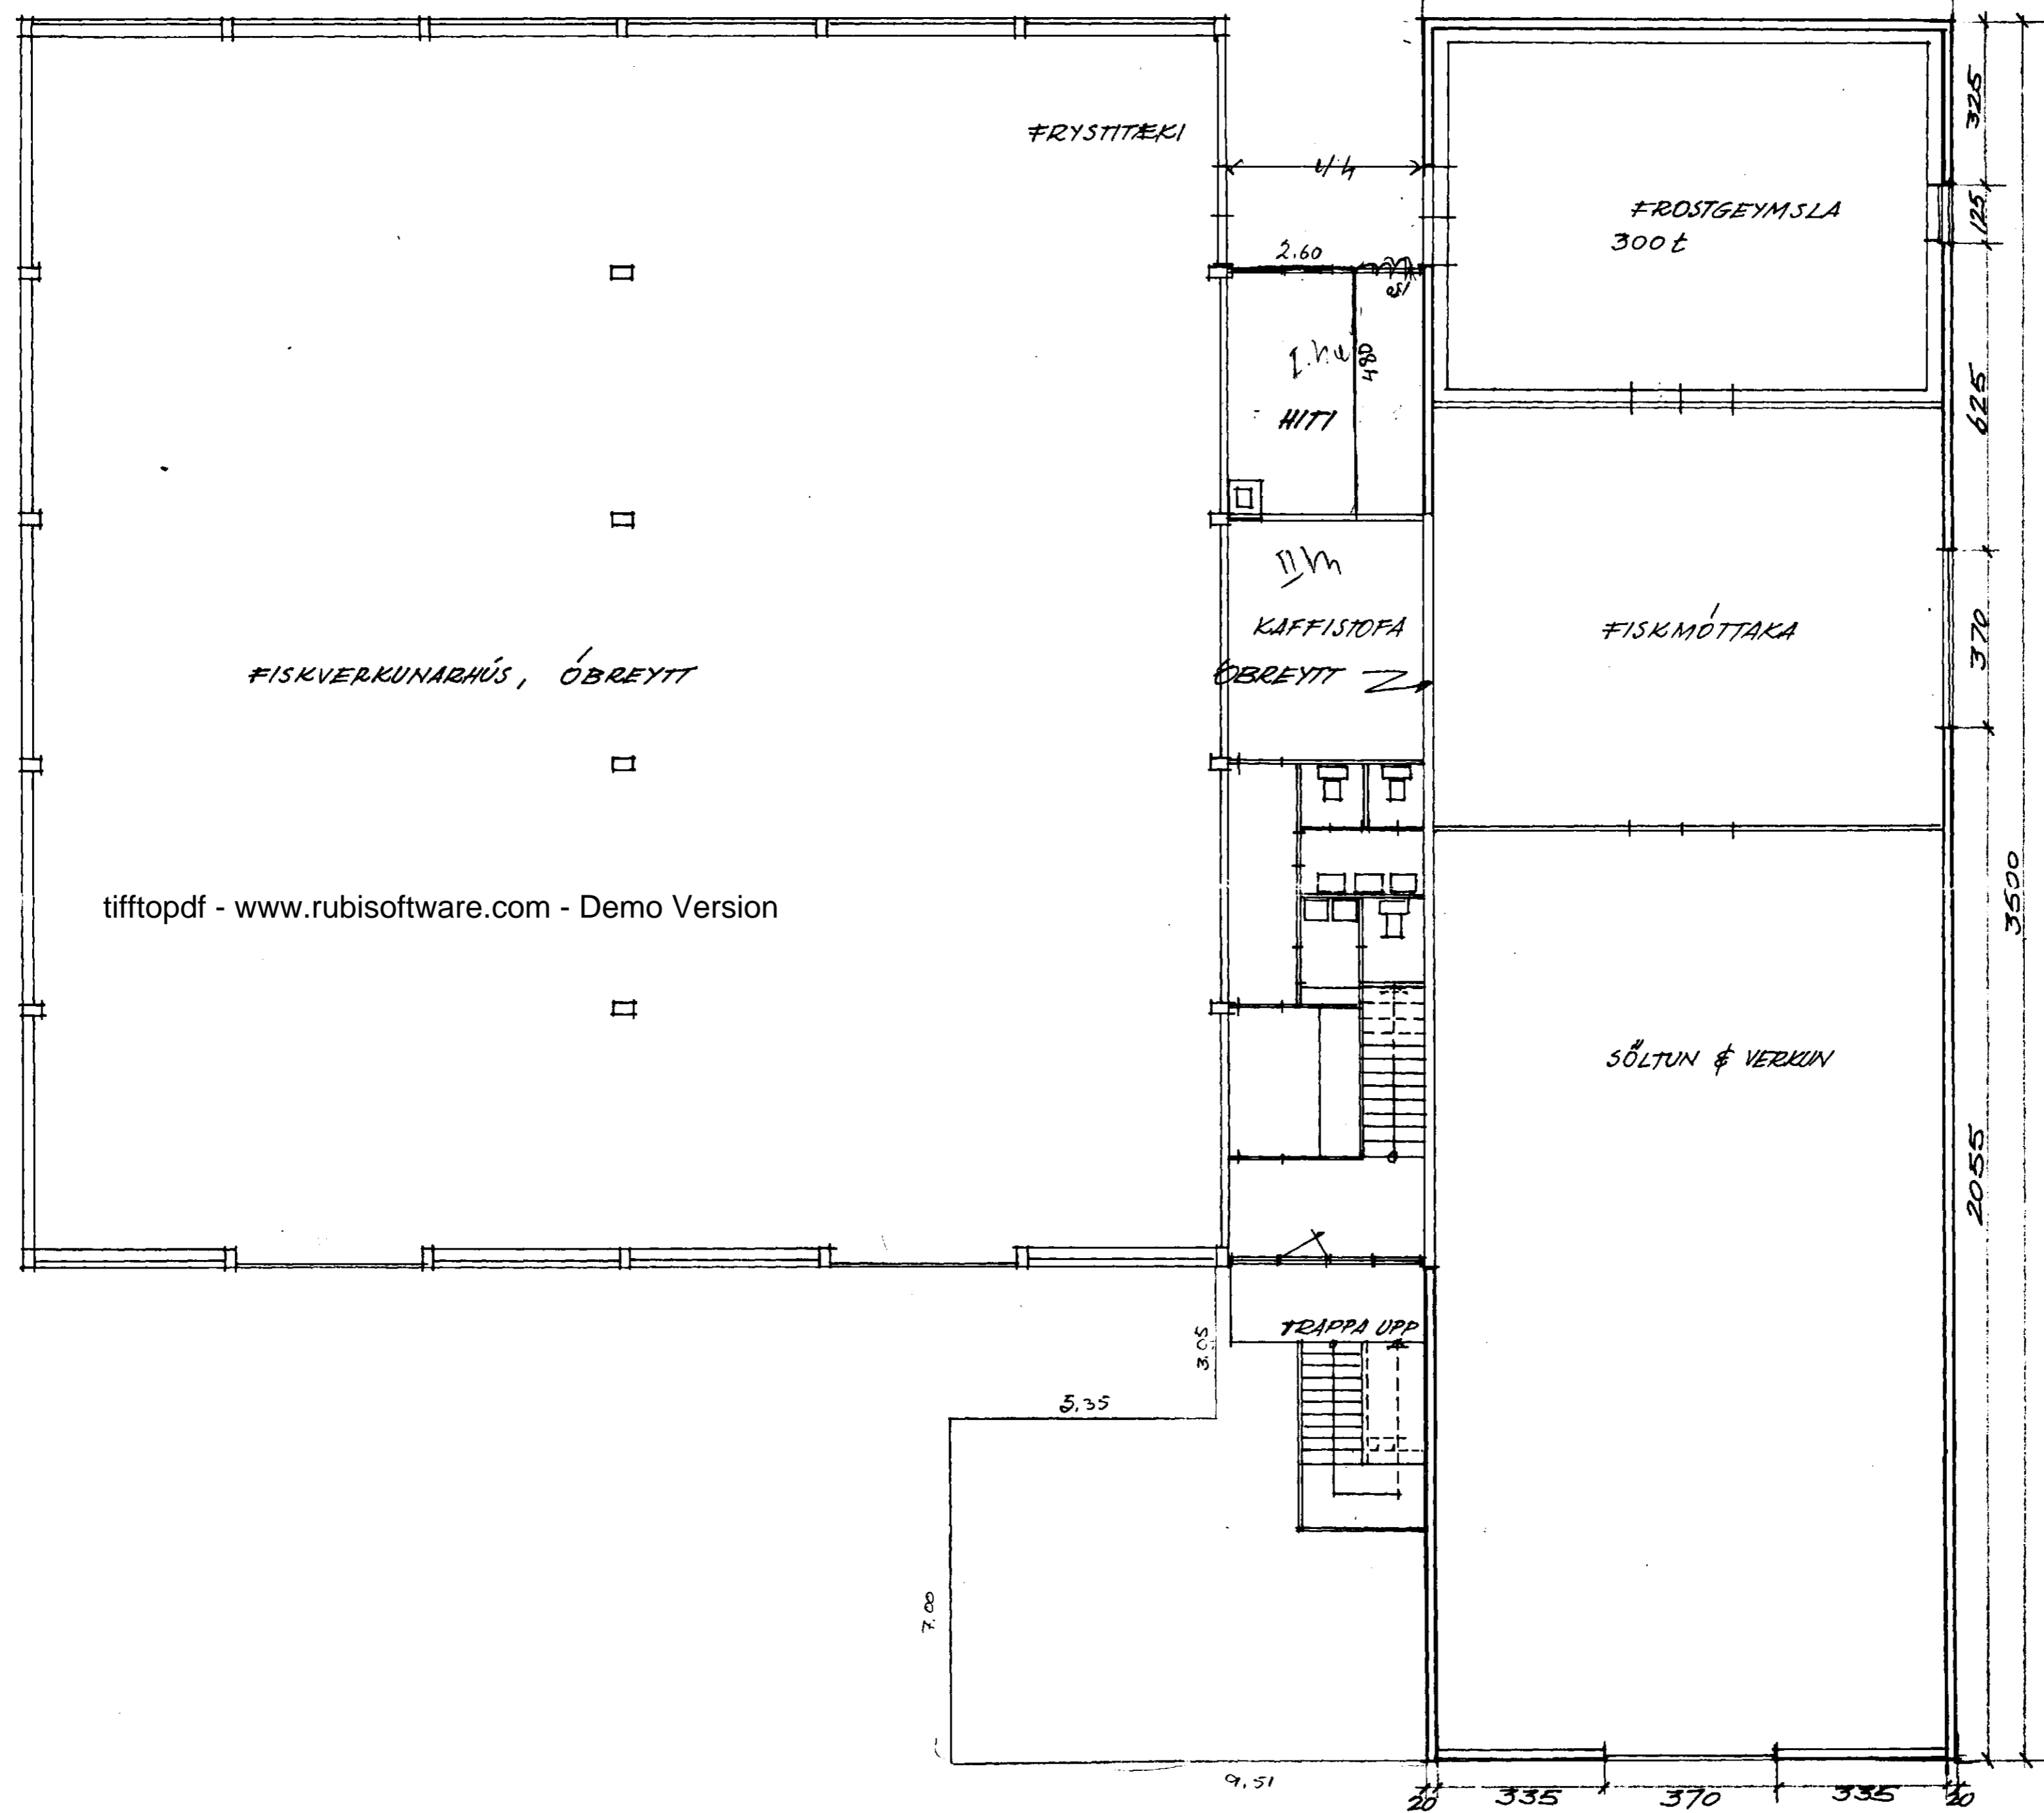

tifftopdf - www.rubissoftware.com - Demo Version

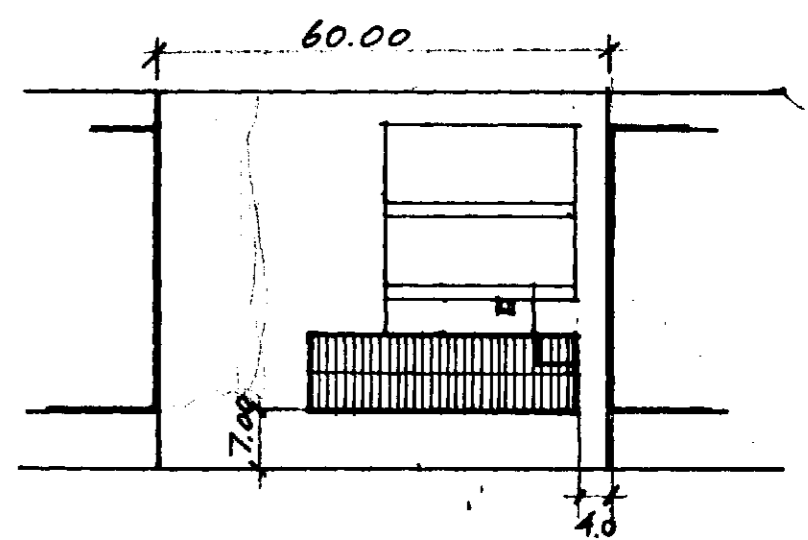

ÓSEYRARBRAUT
 AFSTÖÐUMYND 1:1000

LÖB: 3000 M²
 NÚV. HÚS: 685 M²
 STÆKKUN: 378 M² 378
 SAMTALS: 1055 M² 1063

PLAN 1. HÆÐ

JÚLÍ 1970, Ó.H. HERTERJÓSS