


ALLIR BRUNNAR Ø1000
LÖGN Ø300 ST

UPPMELDAR RÍSGYR 1:100

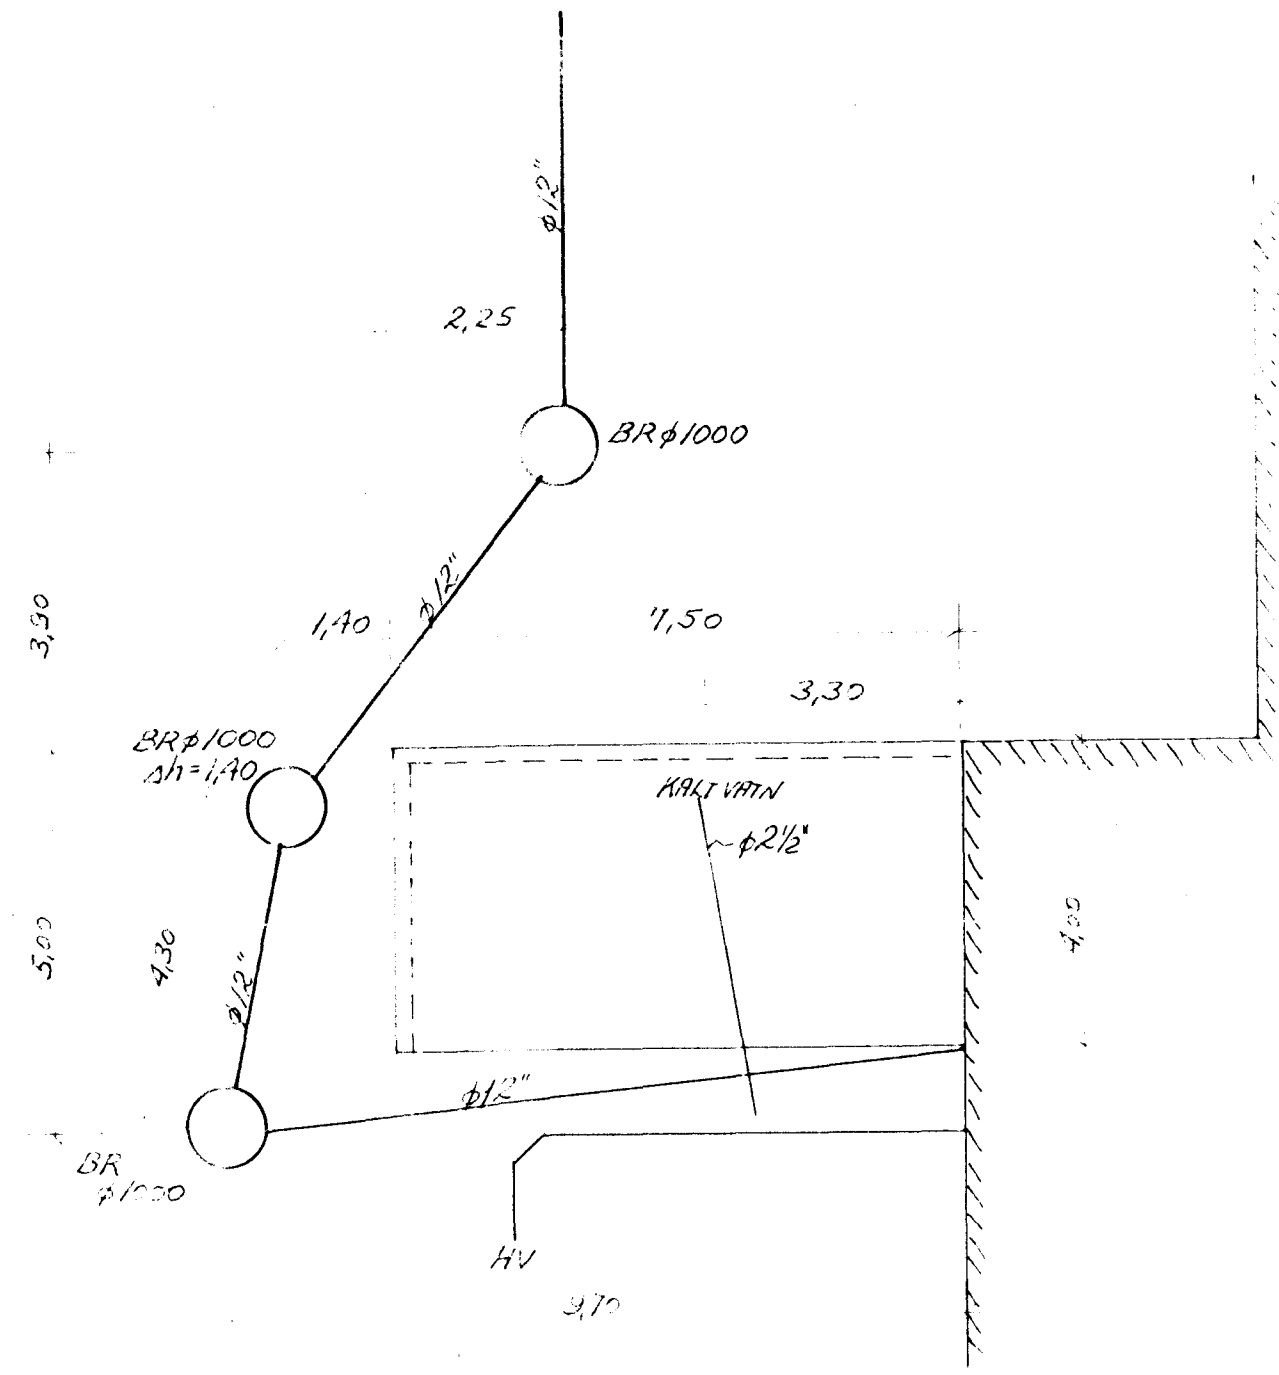

ÖSEYRARBRAUT 5-7 HAFNARFIRDI	VERK	BL.NR
STÆSETNING NÝRRAR HOLRÆSALAGNAR	HAFNARFJÚLÍ '85	
	MKV. 1:500	REIKN. TEIKN.
VERKFRÆÐISTOFA HALDÓRS HANNESSONAR SÚÐURGÖTU 14 HAFNARFIRDI SÍMI 54355		