


Samþykkt 19/5 1988
 VEGNA FULLNÁÐARFRÁGANGS
Jóno Björnsson
 Lj. Rafveitu Hafnarfiardar

Inntök samþykkt 19.10. 1988
 Lj. RAFVEITU HAFNARFIARDAR
Albert Þrastinnsson

HLÚSVEITA TENGIST Á R-FAGA

AFSTÖÐUMYND M 1:500

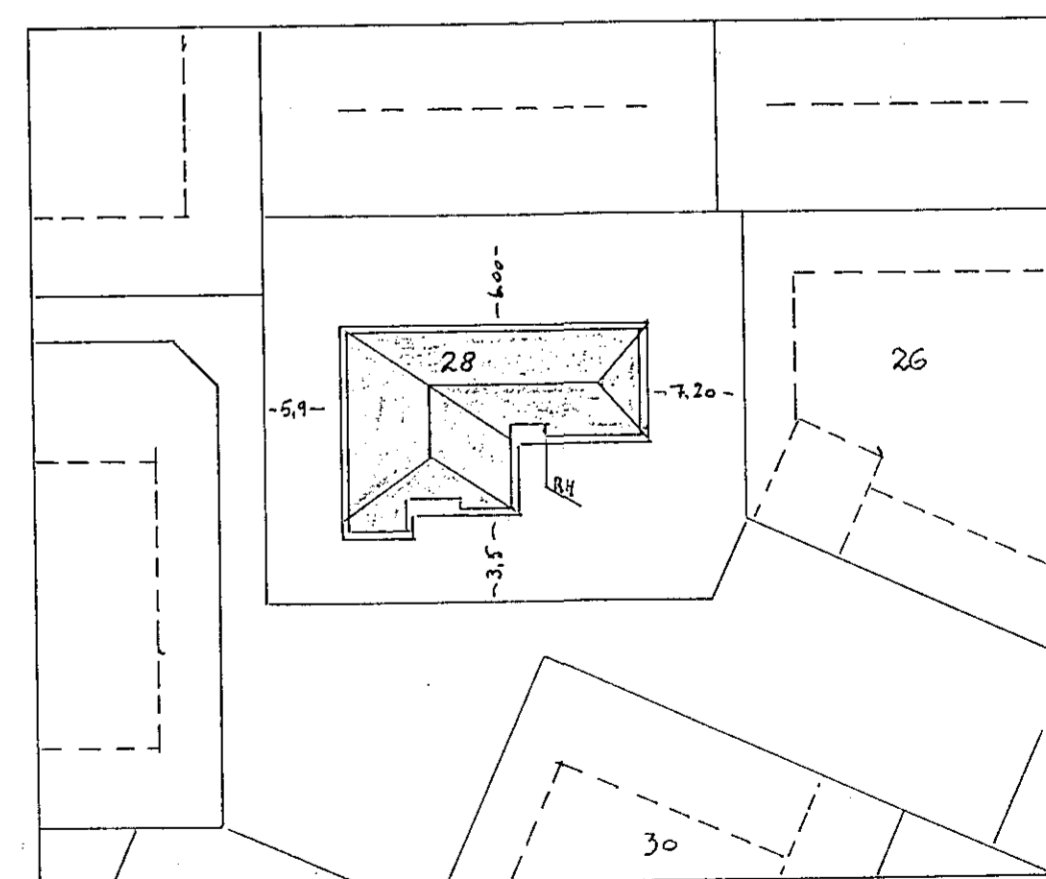

TEIKNING NR. 2865

NR.	BREYTING	DAGS	BR.
	LJÓSABERG 28 HAFNARF.		
	RAFLÖGN	HANNAD	G.Sig.
	TEIKNAD	TEIKNAD	G.Sig.
	AFSÖÐUMYND	DAGS	APRIL '88
		KVARDI	1:50 1:500
	Ljósioð S.F. S: 671889	BLAÐ NR.	1 AF 2