



HAMRABERG

STUOLABERG

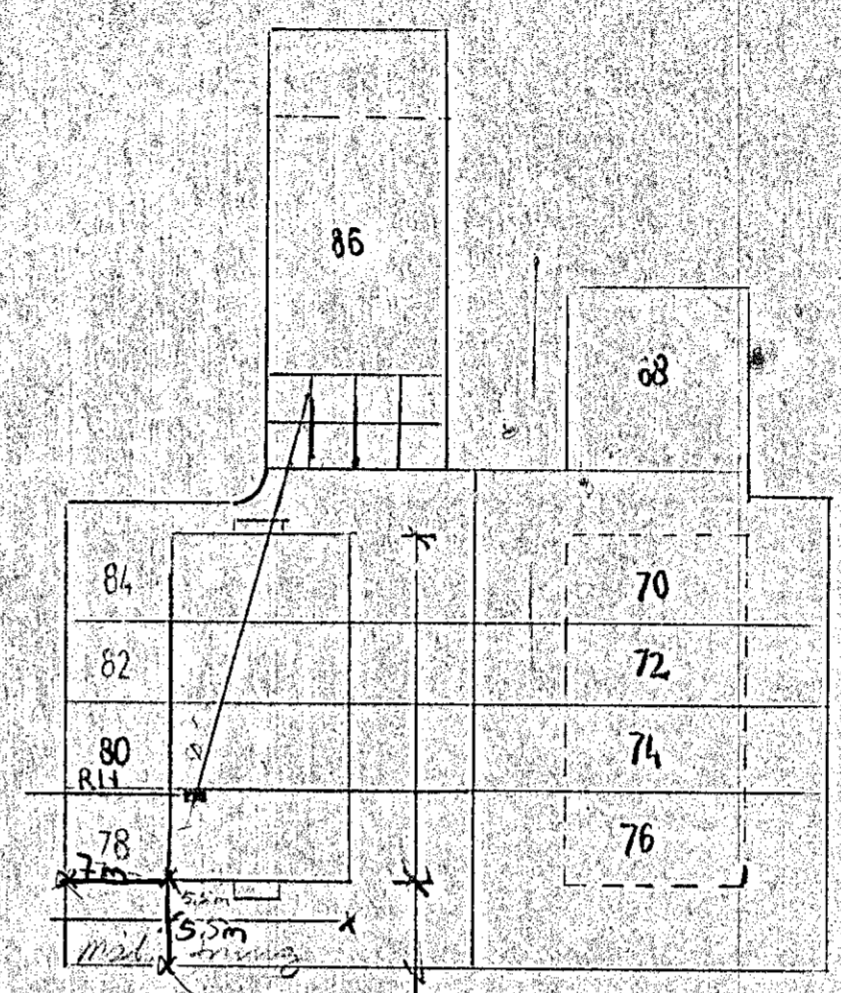

AFSTANDMYND 1:500

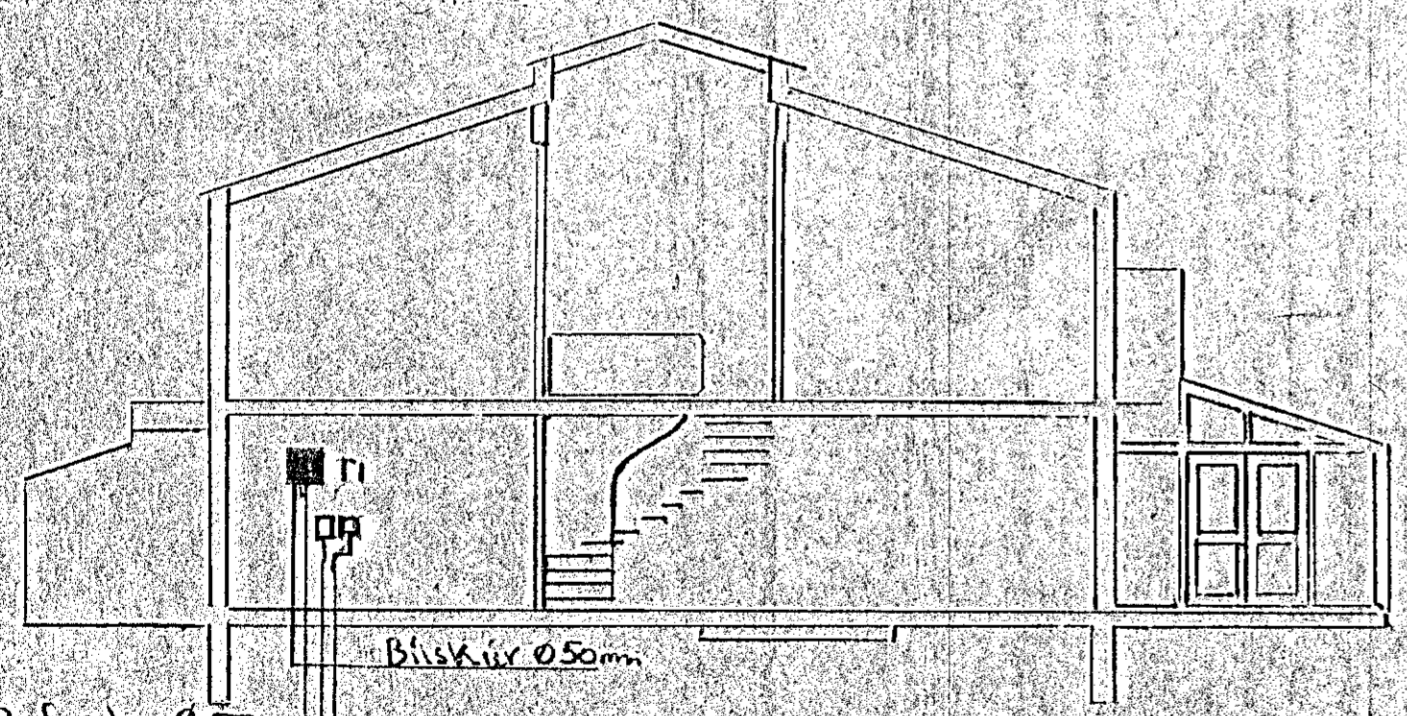

Til Ráfrætti $\varnothing 50$
 Póstur og Sími $\varnothing 50$
 Loftnet $\varnothing 25$

Blískúr $\varnothing 50$ mm

SNEIÐING D-D 78

STUOLABERG 7E	Mkw 1:500 1:100
<i>Grundin</i>	dag. 09.88