

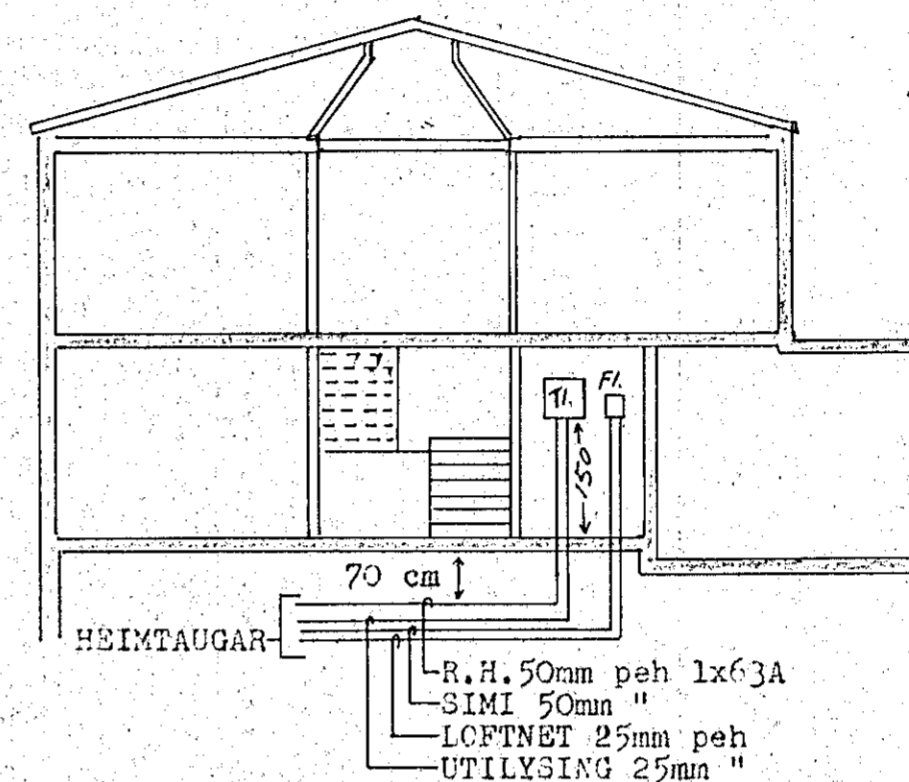


Inntök samþykkt 27.9.1988
 f.h. RAFVEITU HAFNARFJARÐAR
Filbert Þorsteinsson

TAFLA

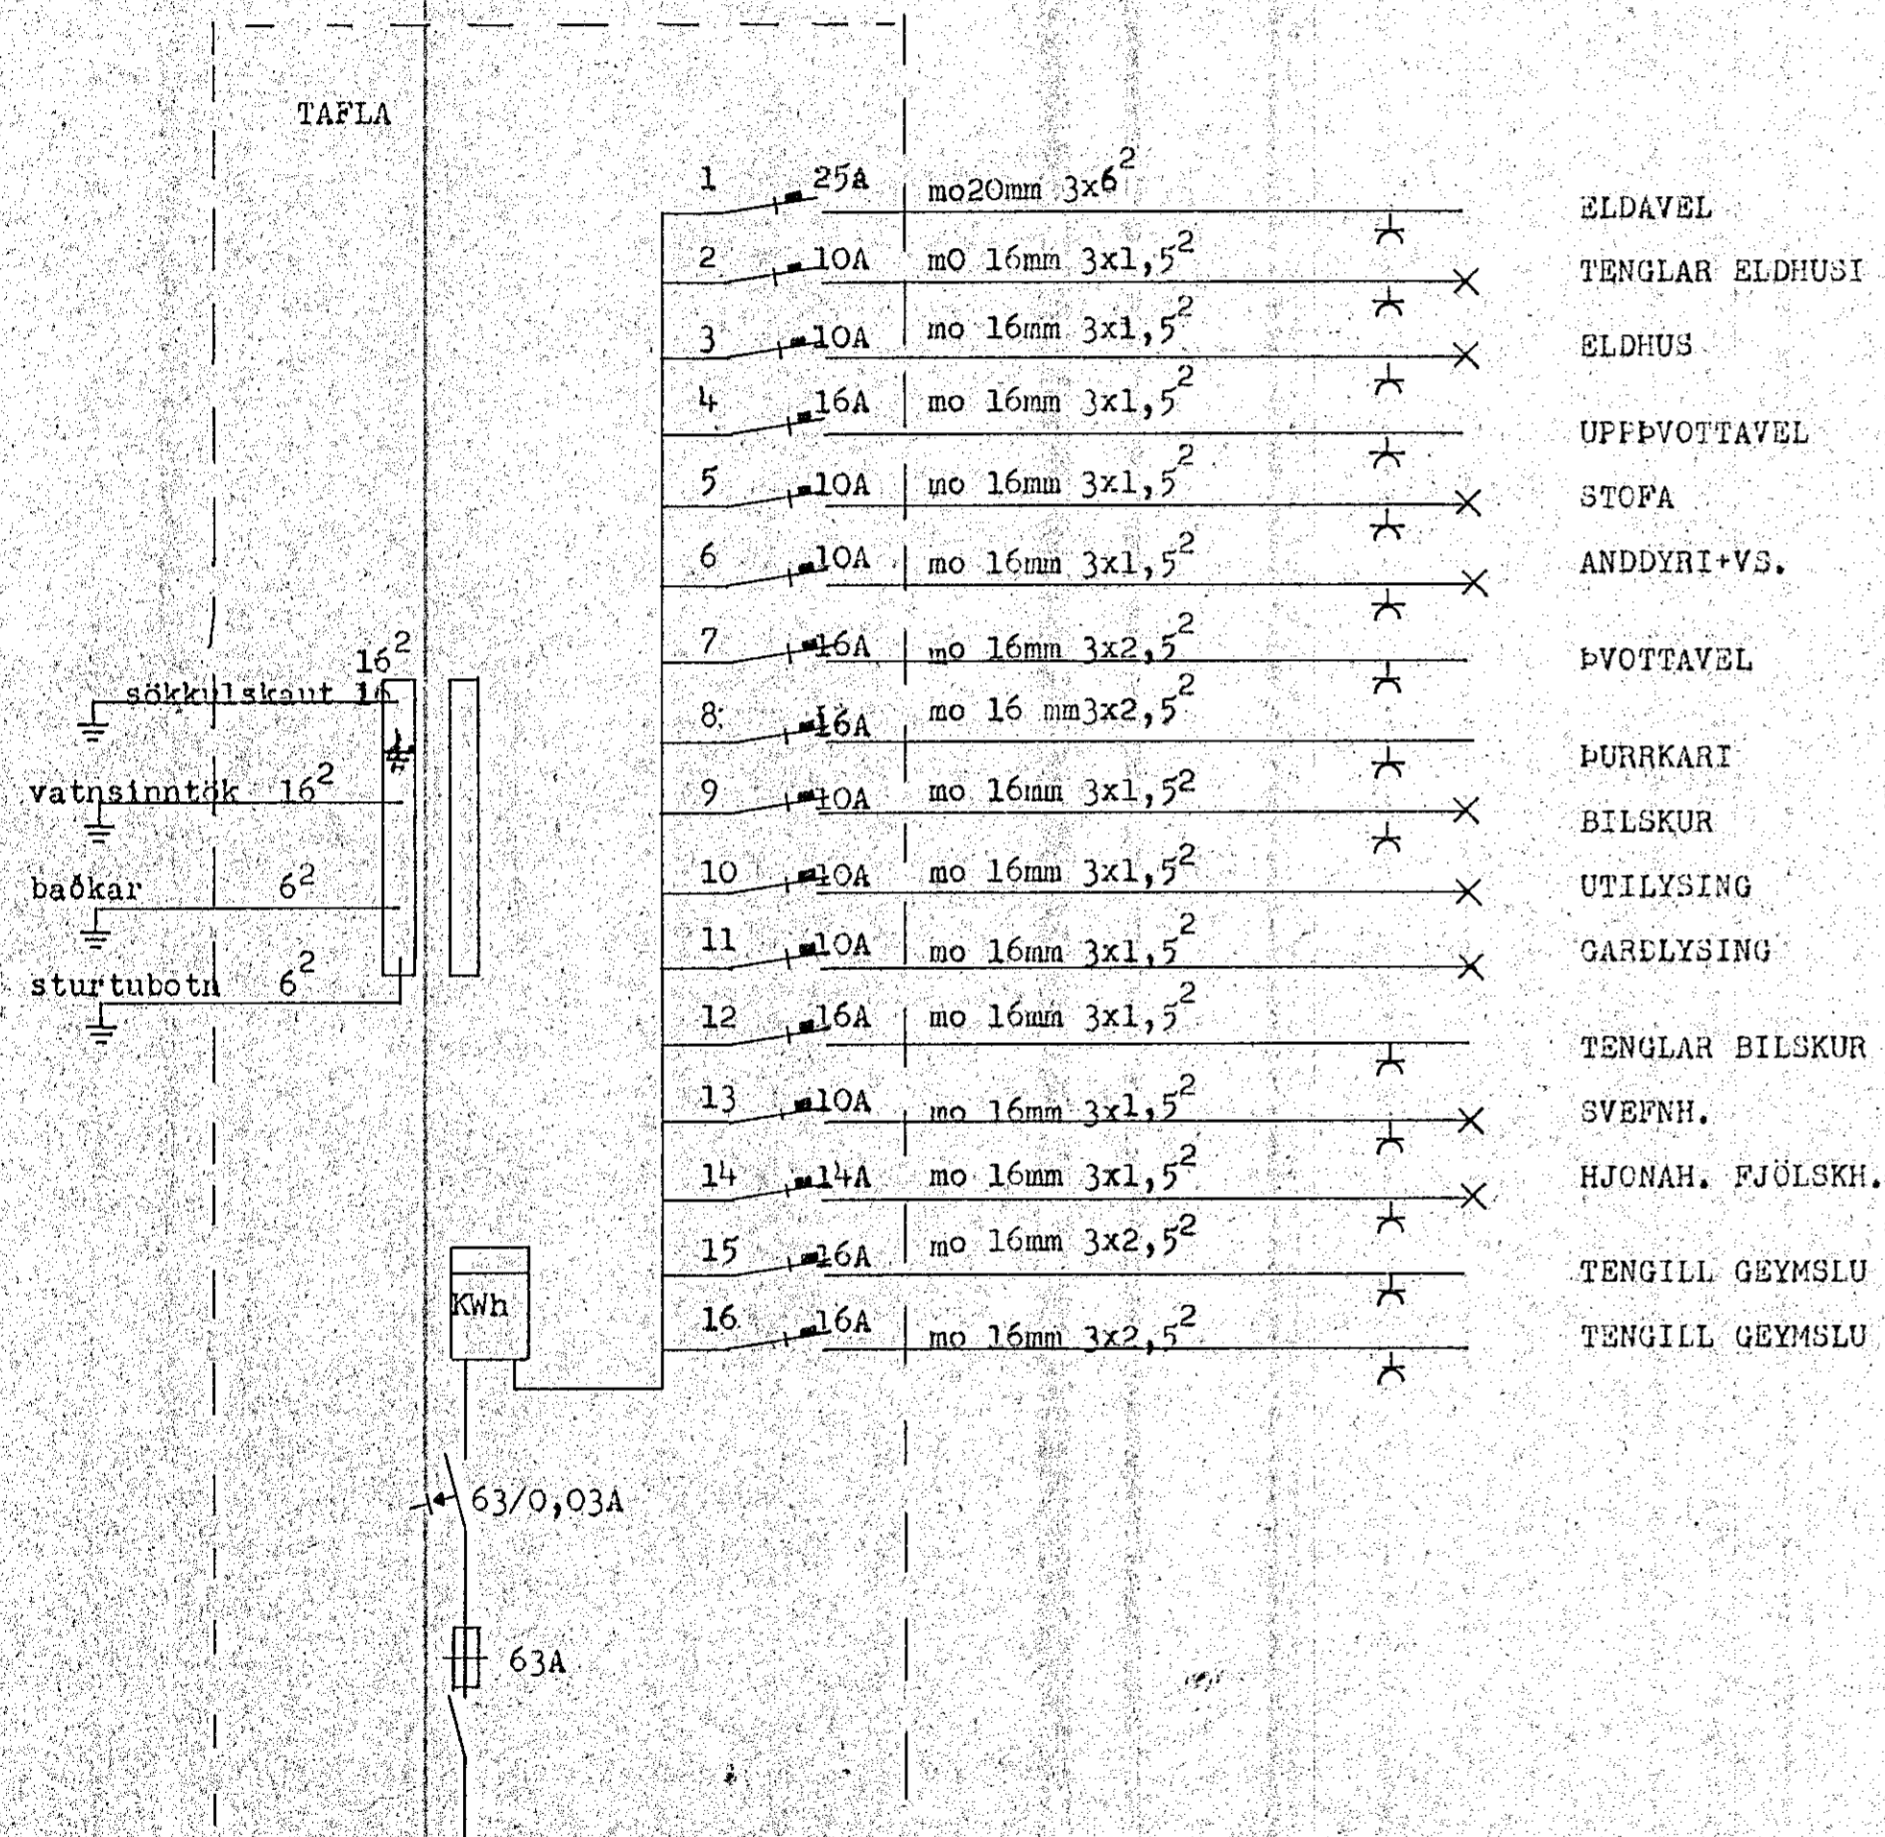

1:100

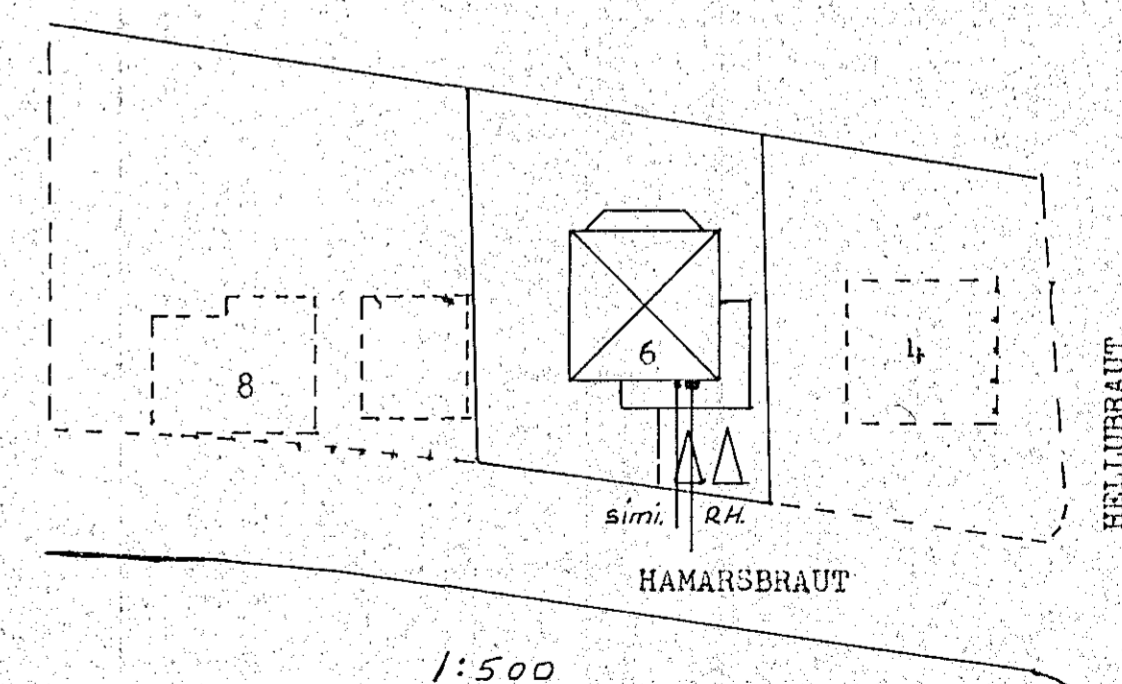

1:500

TEIKNING NR. 2618

SIGURDUR SIGURJONSSON SIMI 641756	
HAMARSBRAUT 6.	Blaf 2 af 2
RAFLAGNIR	<i>Sigurdur Sigurjonsson</i> Agúst '88