


INNÞAKSRÖR

R.H. 50mm

P.S. 50mm

ÄR NA LITFYRIR LÖÐARMÖRK

DYPT 70cm UNDIR YFIRBORÐI

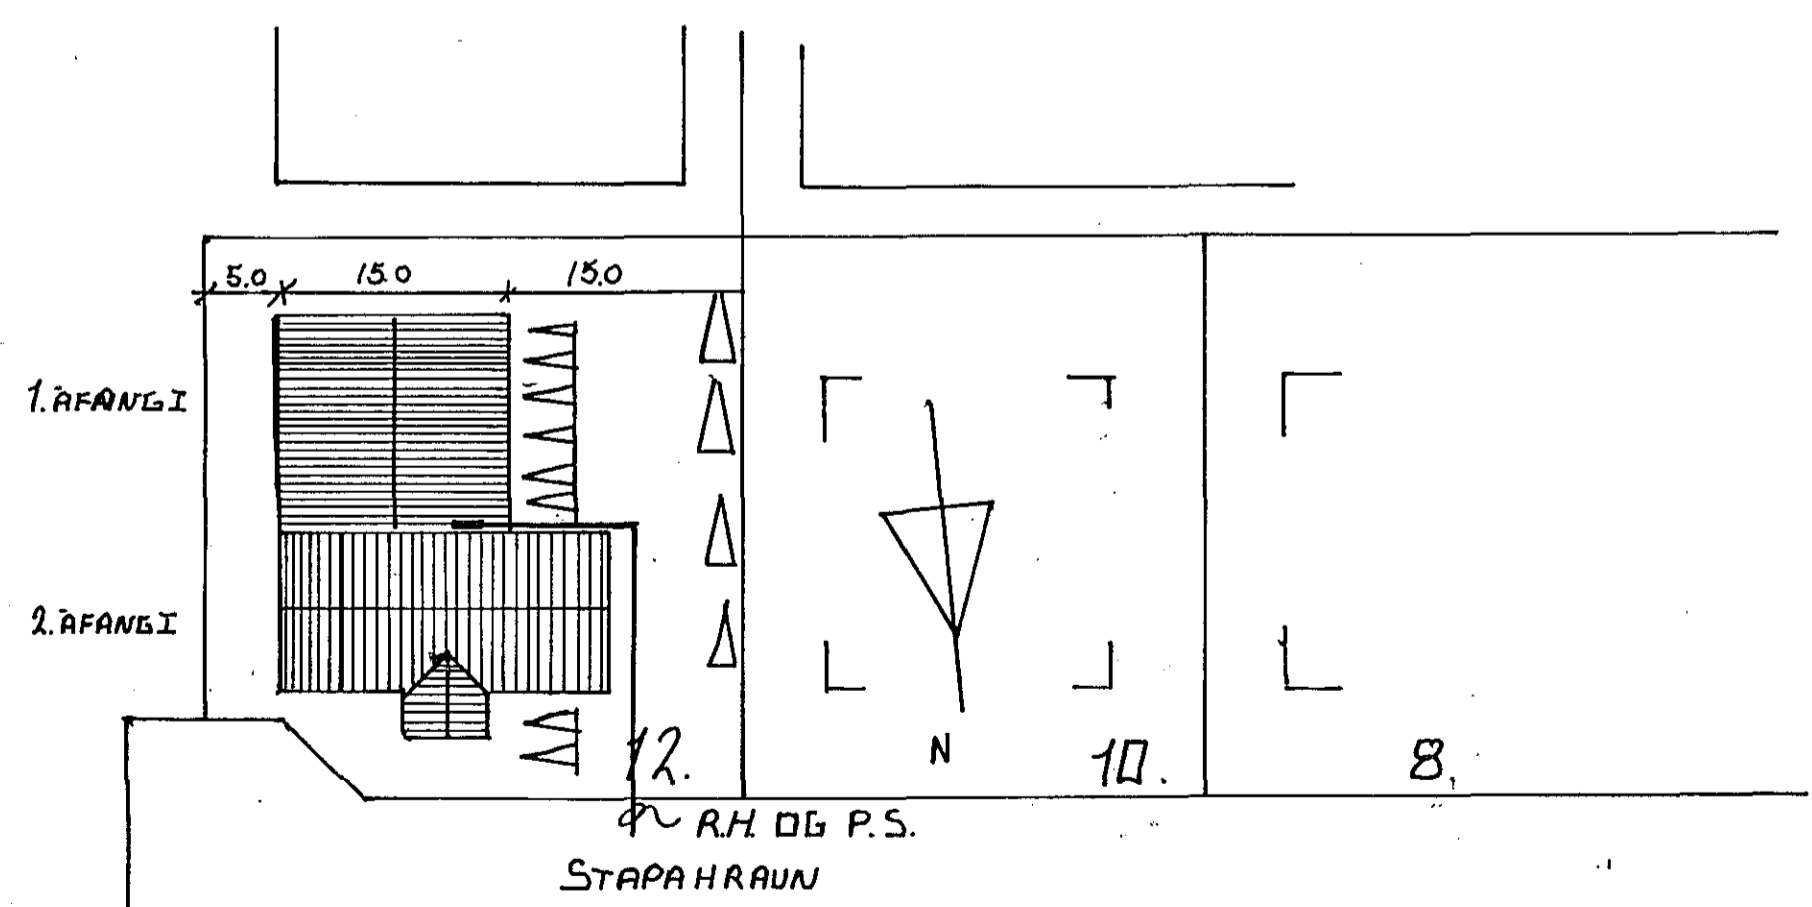

Inntök samþykkt 23.19. 1988
 l.h. RAFVEITU HAFNARFIARDAR
 Albert Adm. Stinson

Samþykkt 23-9 1988
 VEGNA HEIMTAUGAR
 Jónas Stefánsson
 l.h. Rafveitu Hálforsjóar

TEIKNING NR. 2616

STAPAHRUN 12. A.J. RAFVERKTAKAR

TEIKNAD Jónas Stefánsson

BRÁÐABIRLÐA TEIKNING