
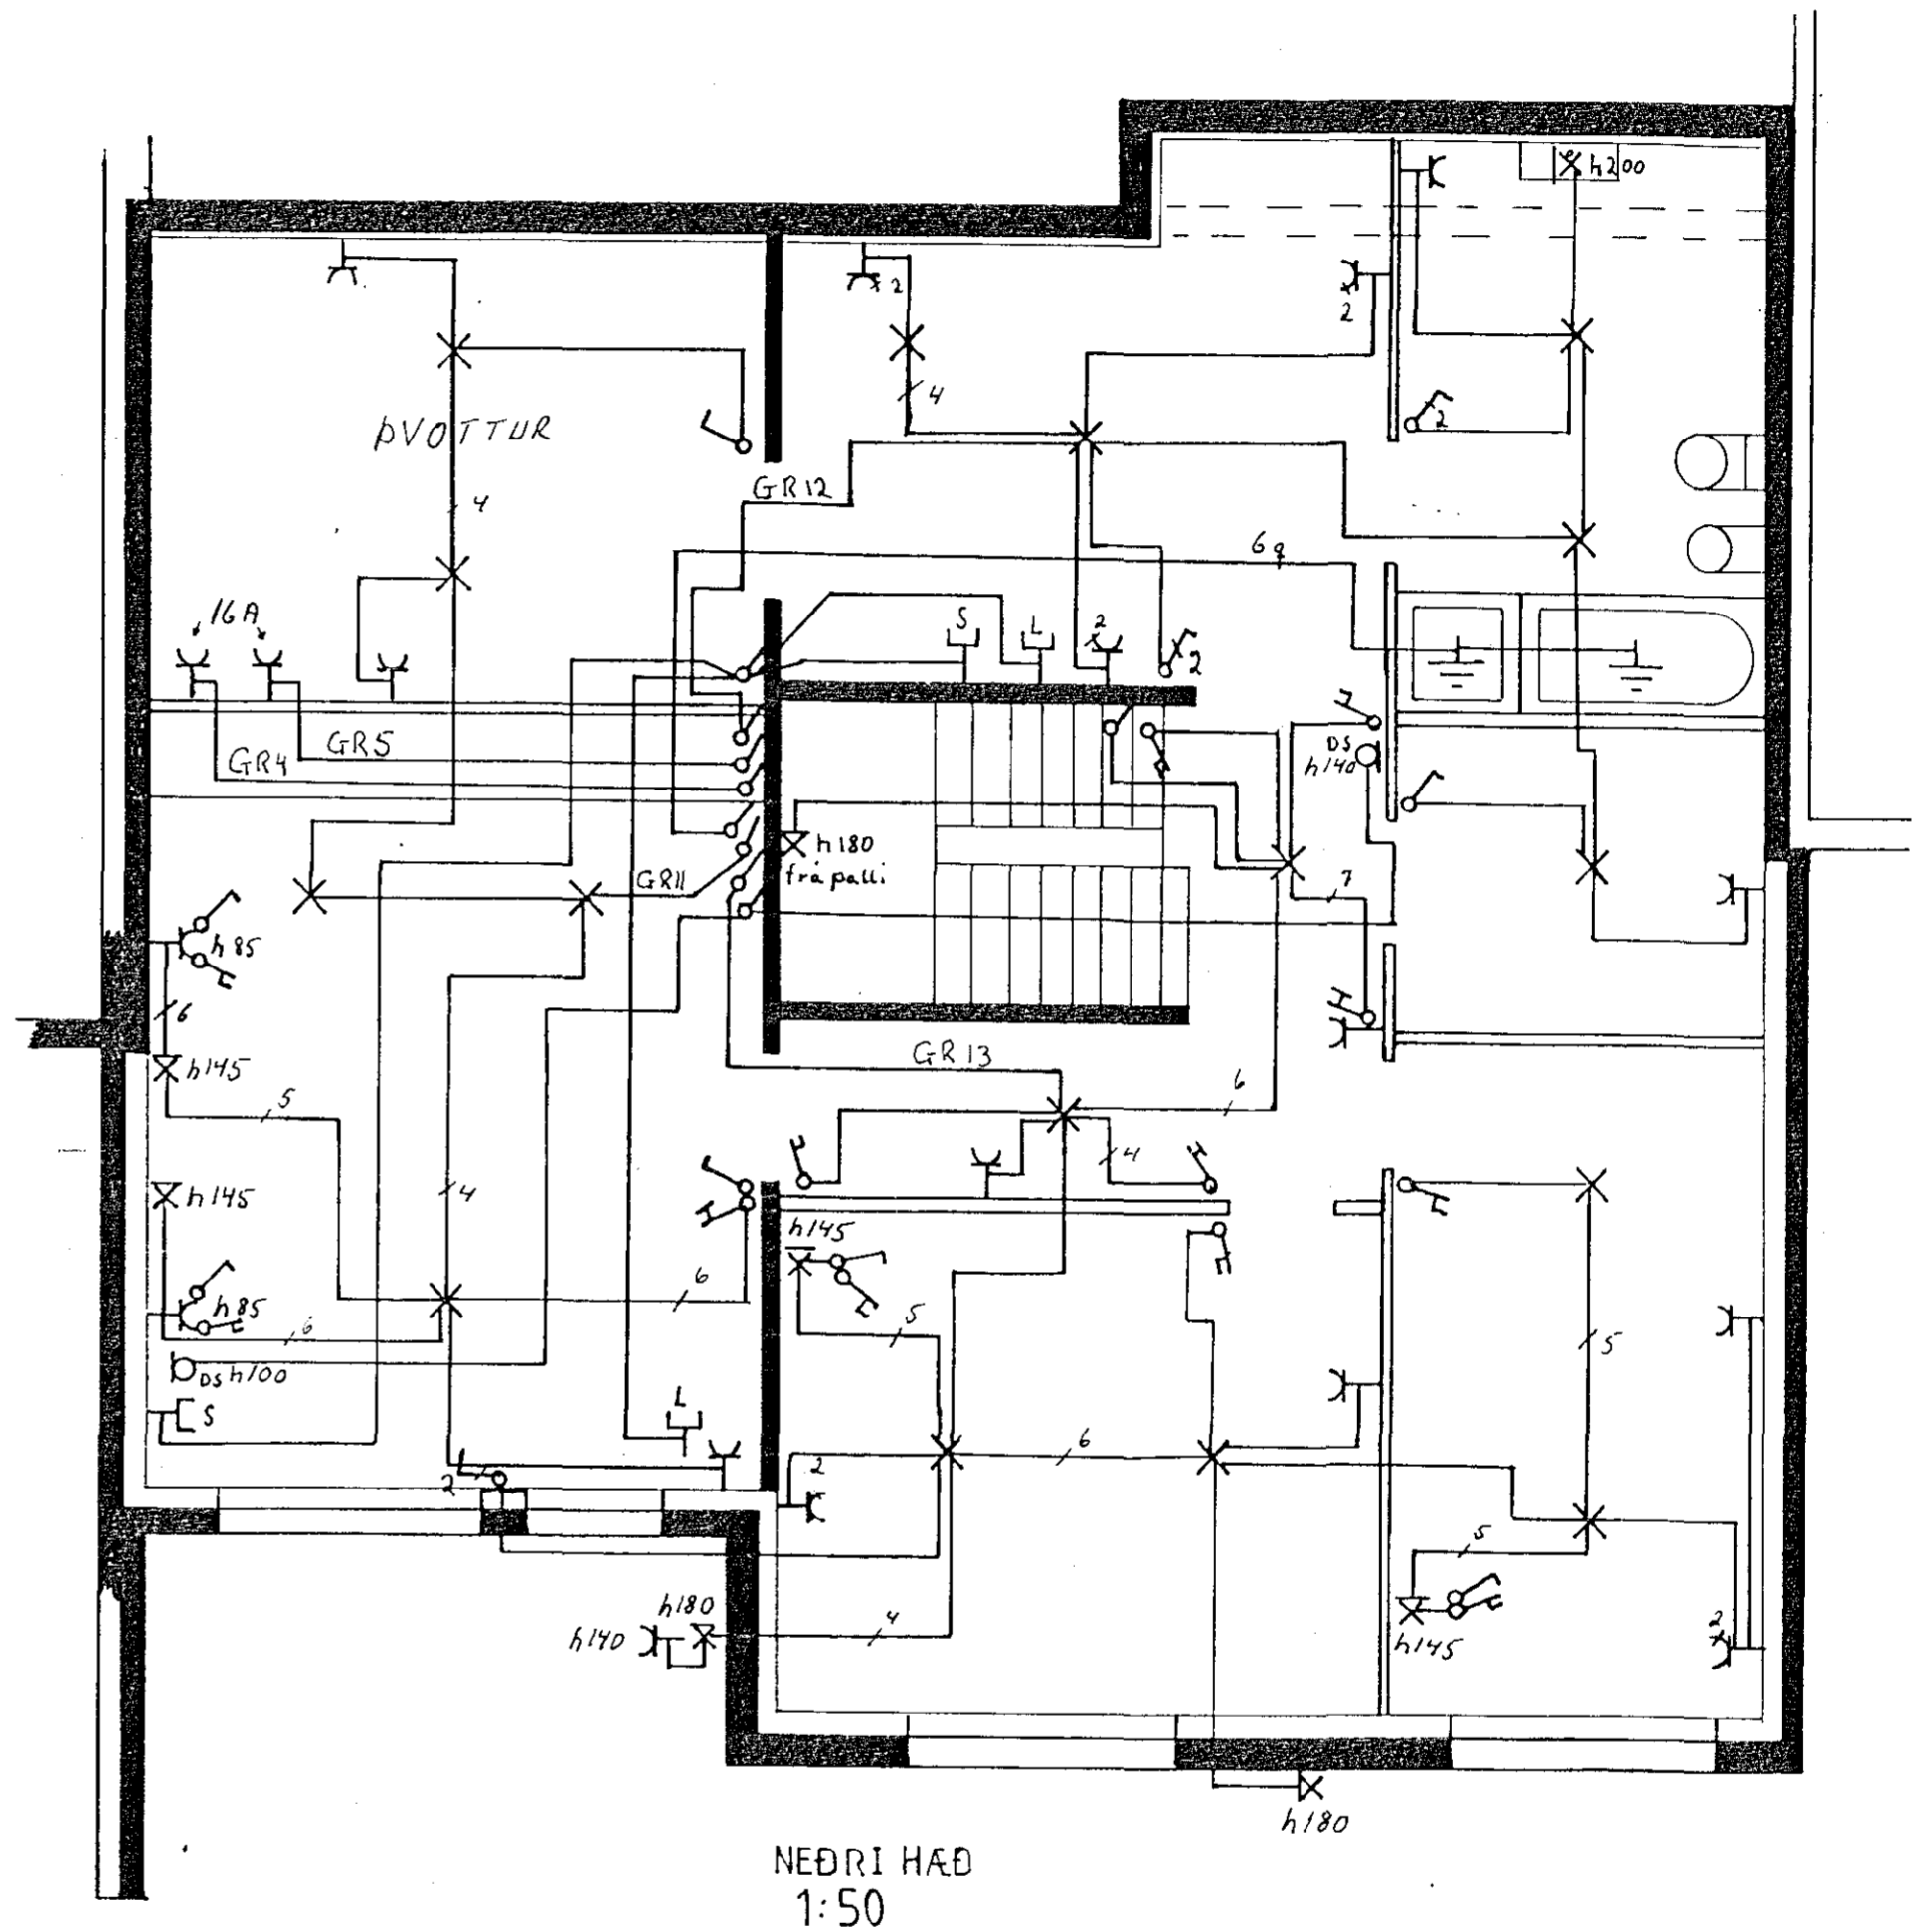


Inntök samþykkt 7.11.1990  
 L.h. RAUFVEITU HAFNAFJÁRDAR  
 Píbert Jónstíngsson  
 HJUSVEITA TENGIST Á H-FASA

Samþykkt 13.11.1990  
 VEGNA FULLNADARFRÁGANGS  
 Jón Gunnarsson  
 L.h. Raufveitu Hafnarfjarðar

RH Ø 50  
 Sími Ø 50  
 Loftu Ø 32  
 AUKA Ø 25

inntakspípur skulu ná  
 út fyrir lóðarmörk

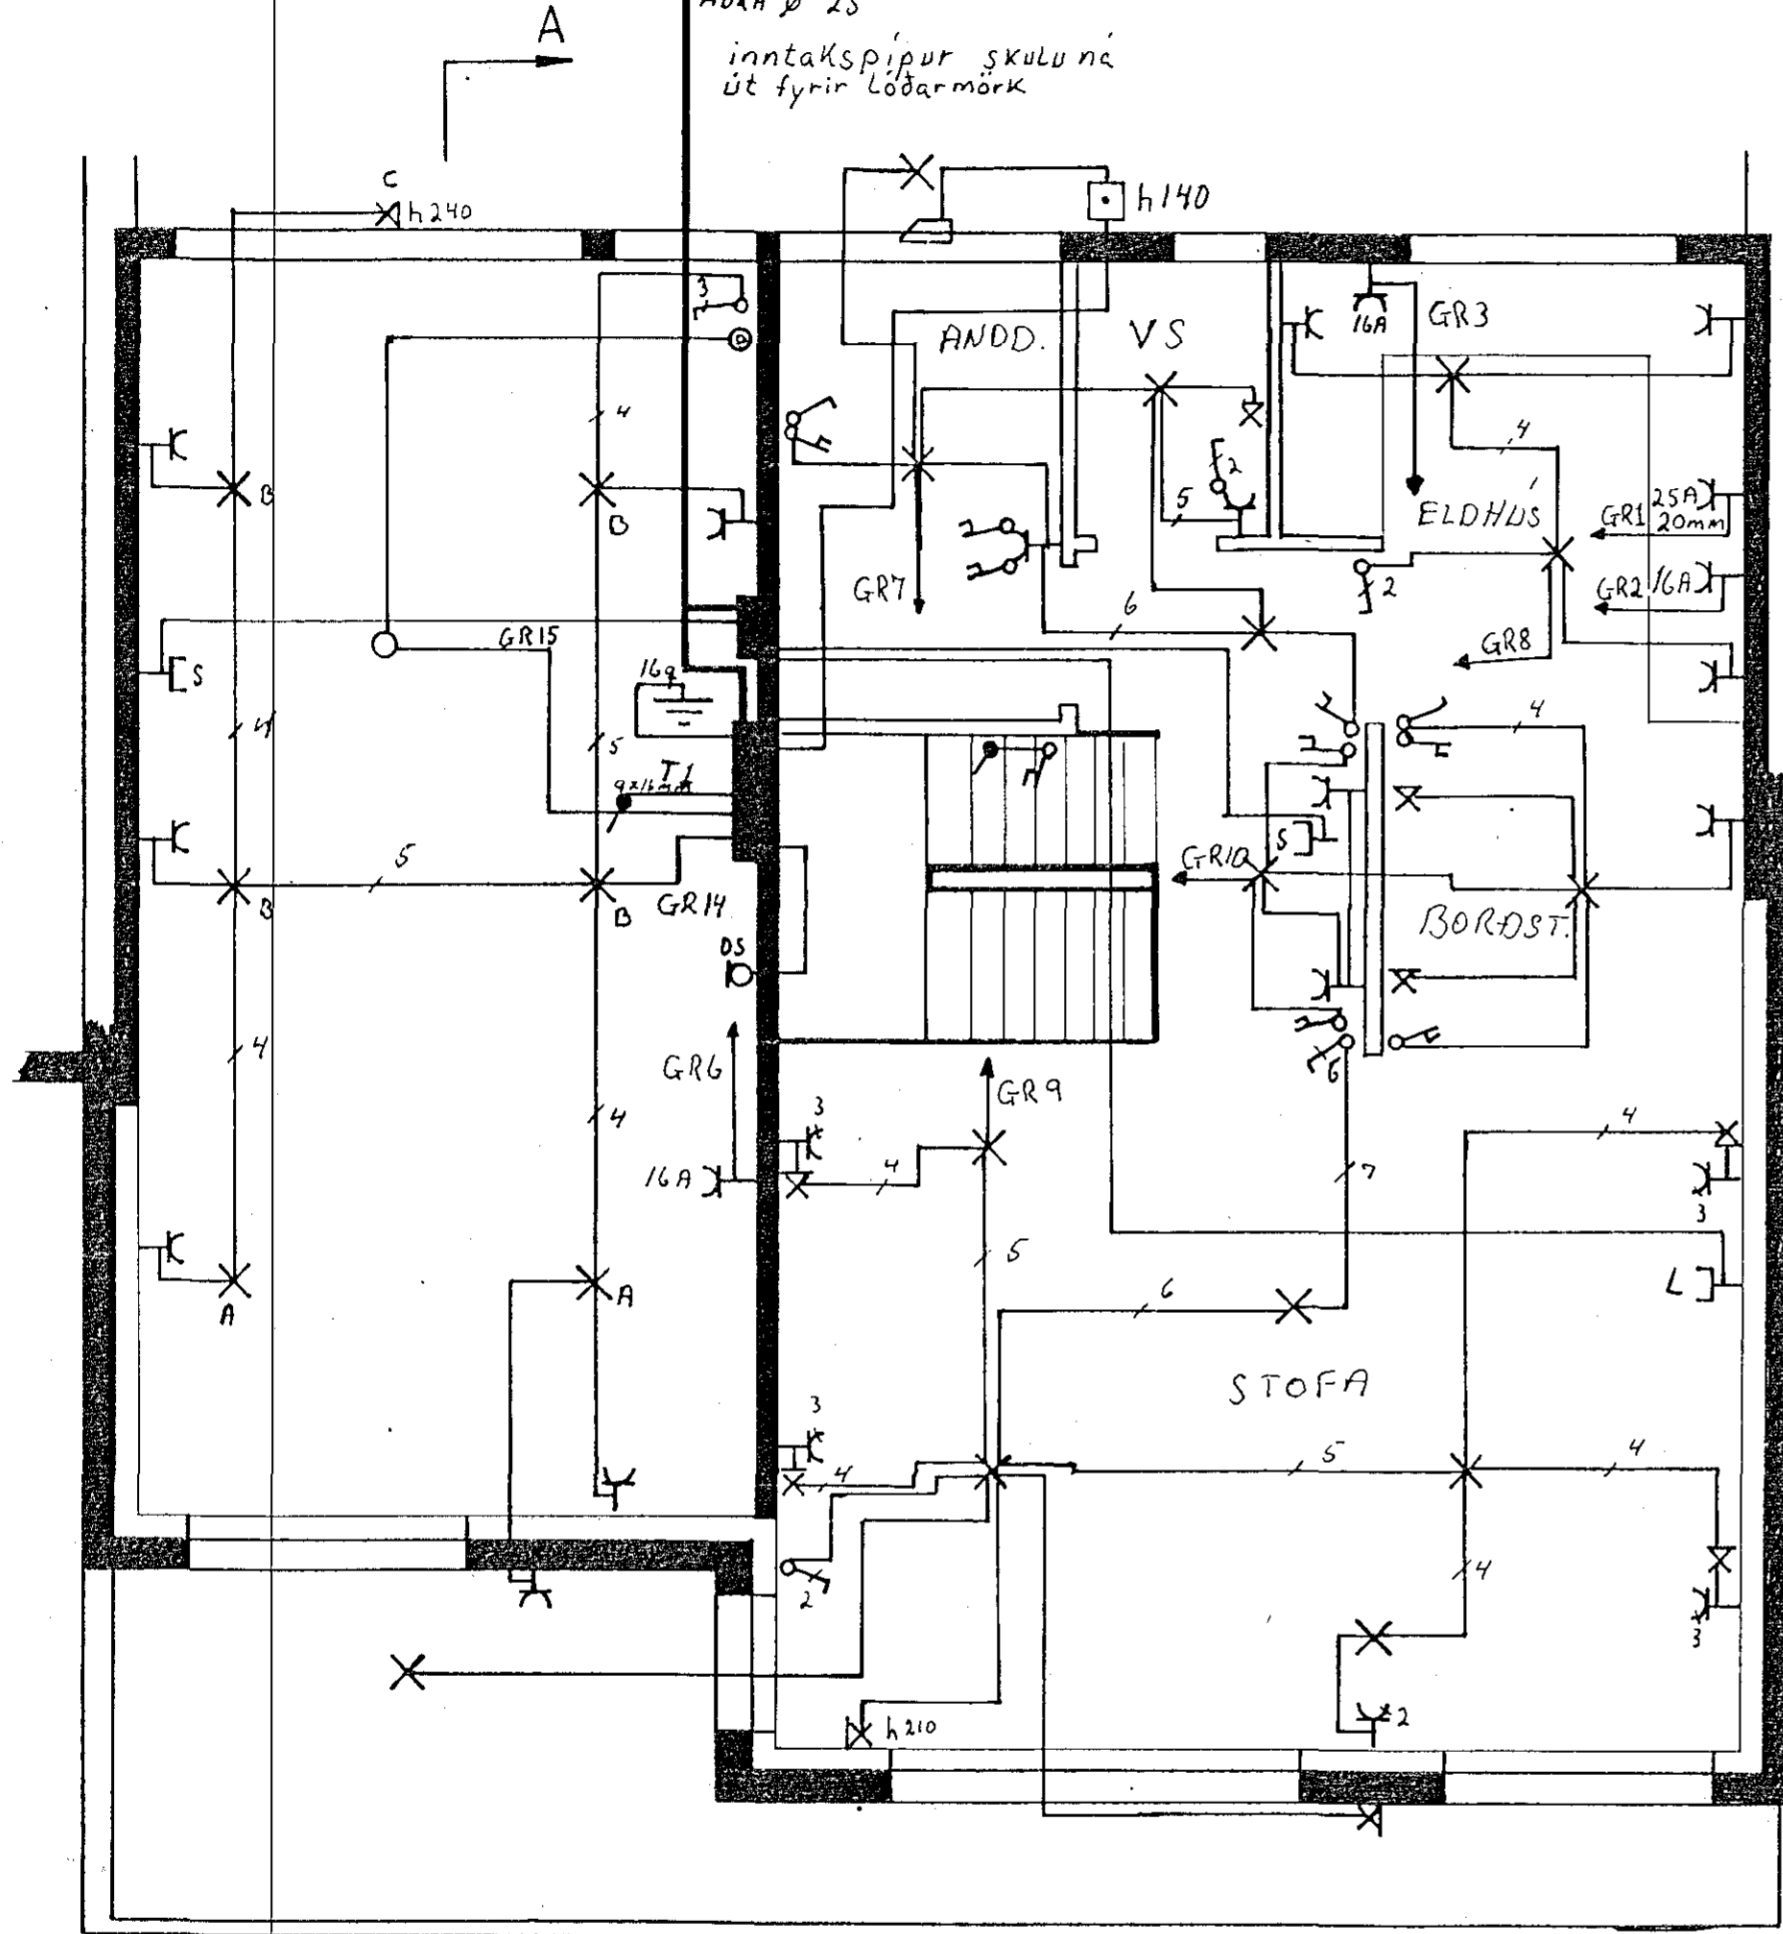

TEIKNING NR. 2878

NR.	BREYTING	DAGS	BR.
KLUKKUBERG 4 HAFNAFIRÐI			
RAFLÖGN			
	HANNAÐ	ff	
	TEIKNAD	ff	
	DAGS	26 maí '90	
	BLAÐ	I AF2	
	KVAFRDI	1:50	
	VERK NR.	40	
S: 28140			