



TAFLA

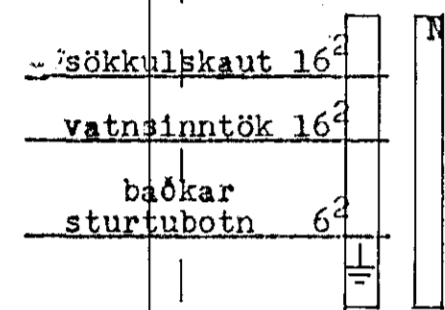


1	25A	m020mm 3x6²	
2	16A	m016mm 3x1,5²	
3	10A	m016mm 3x1,5²	X
4	10A	m016mm 3x1,5²	X
5	10A	m016mm 3x1,5²	X
6	10A	m016mm 3x1,5²	X
7	10A	m016mm 3x1,5²	X
8	10A	m016mm 3x1,5²	X
9	16A	m016mm 3x1,5²	
10	16A	m016mm 3x1,5²	
11	10A	m016mm 3x1,5²	X
12	10A	m016mm 3x1,5²	

- Eldavel
- Uppvottavel
- Tenglareldhusi
- Tenglareldhusi
- Eldhus og hol
- Þvottah. herb. anddyri
- Bað hjón + herb.
- Stofa
- Þvottavel
- Þurrkari
- Bilskur
- Tengillbilskur
- Til vara

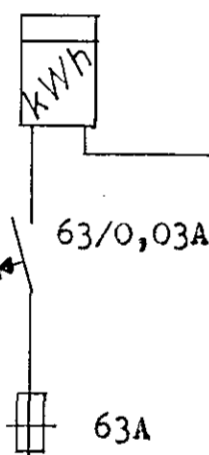


FASI: R

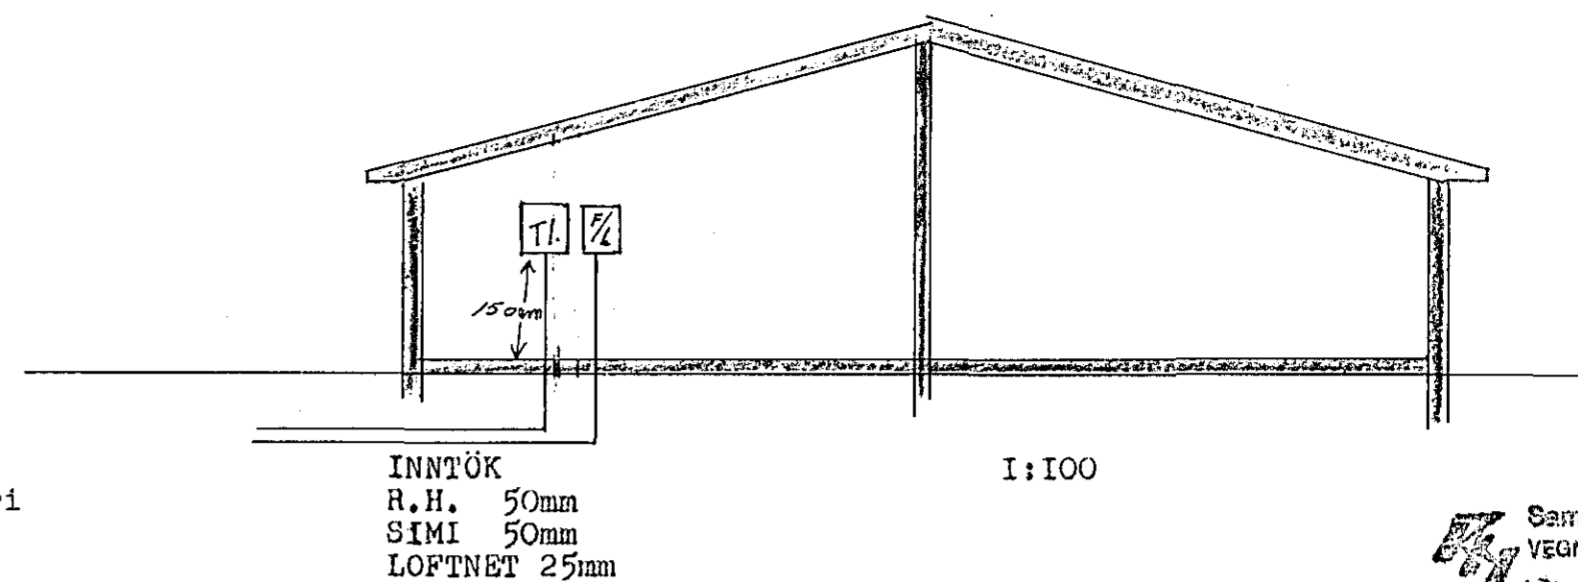

Samþykkt 22-1 1991  
VEGNA FULLNADARFRÁGANGS  
Jens Kusner  
f.h. Rafveitu Hafnarfiardar

Inntök samþykkt 16.11. 1991  
f.h. RAFVEITU HAFNARFIARDAR  
Albert Hvistingsson

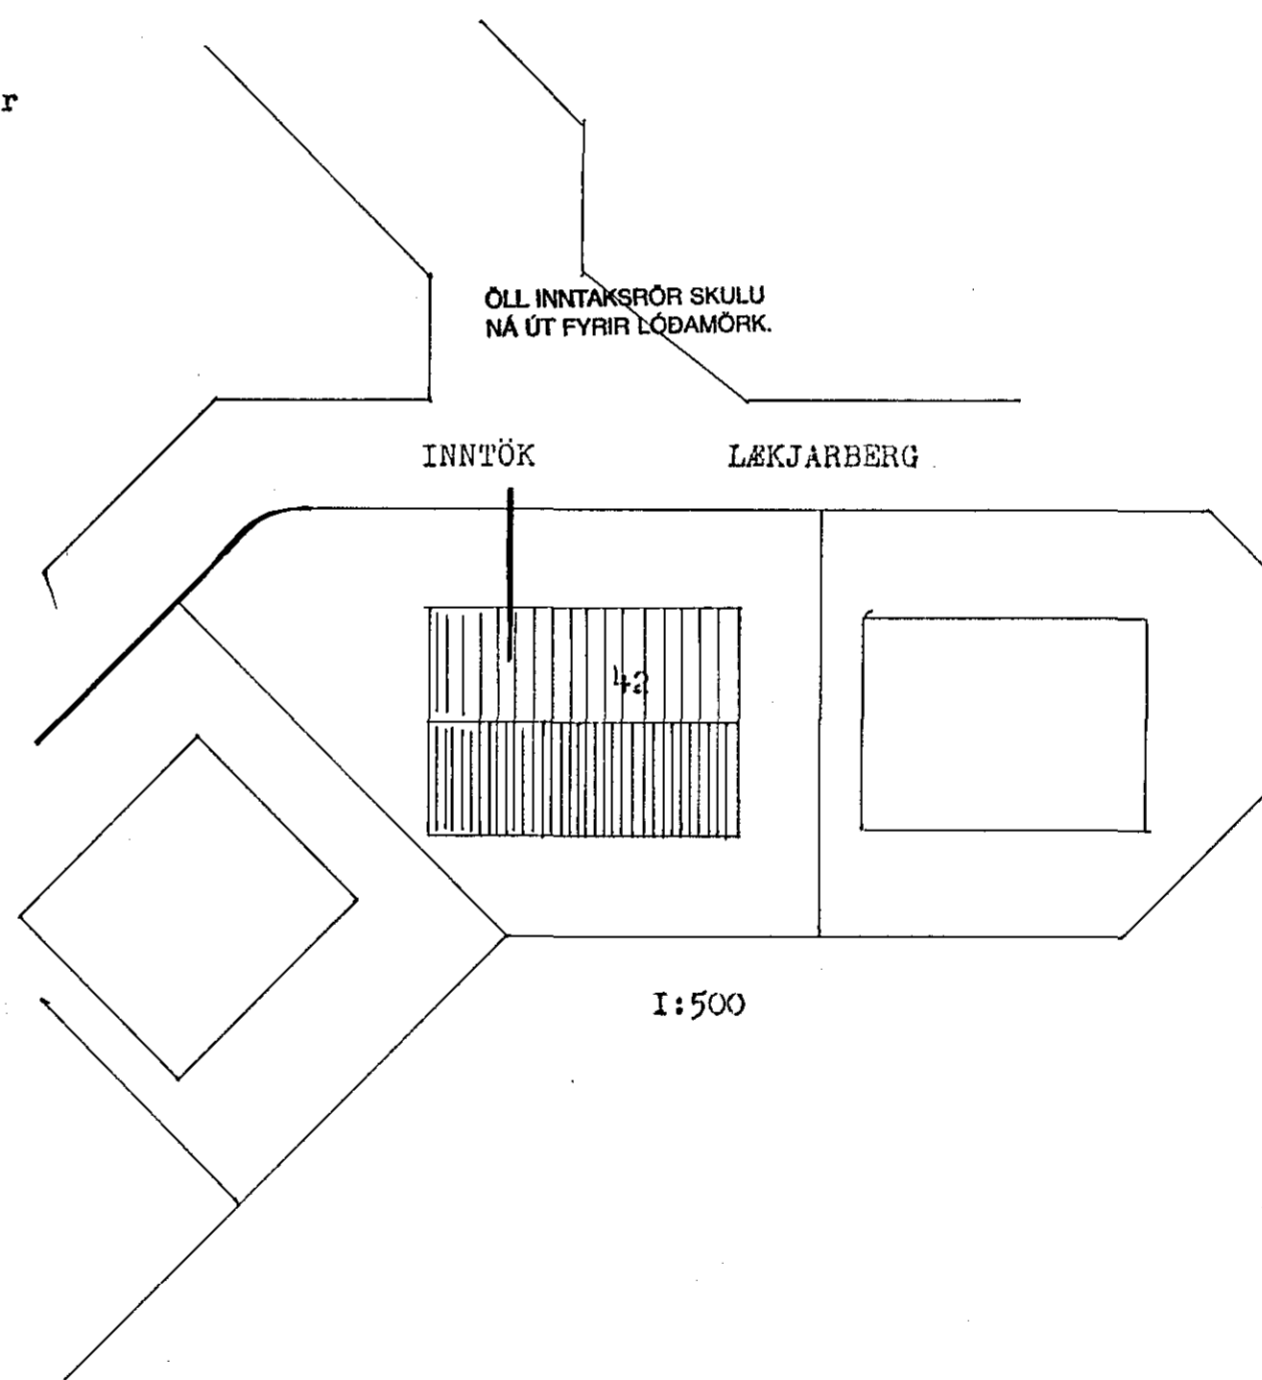

TEKNING NR. 2897.

SIGURDUR SIGURJONSSON SIMI 641756	
LÆKJARBERG 42	B1. 2 af 2
RAFLOGN	1:100 1:500
	Sigurdur Sigurjonsson
	Des '90