



Inntök samþykkt 18.10.1991  
 t.h. RAFVEITU HAFNARFJARDAR  

inntakspípur skulu na  
 útflyvir lóðar verk

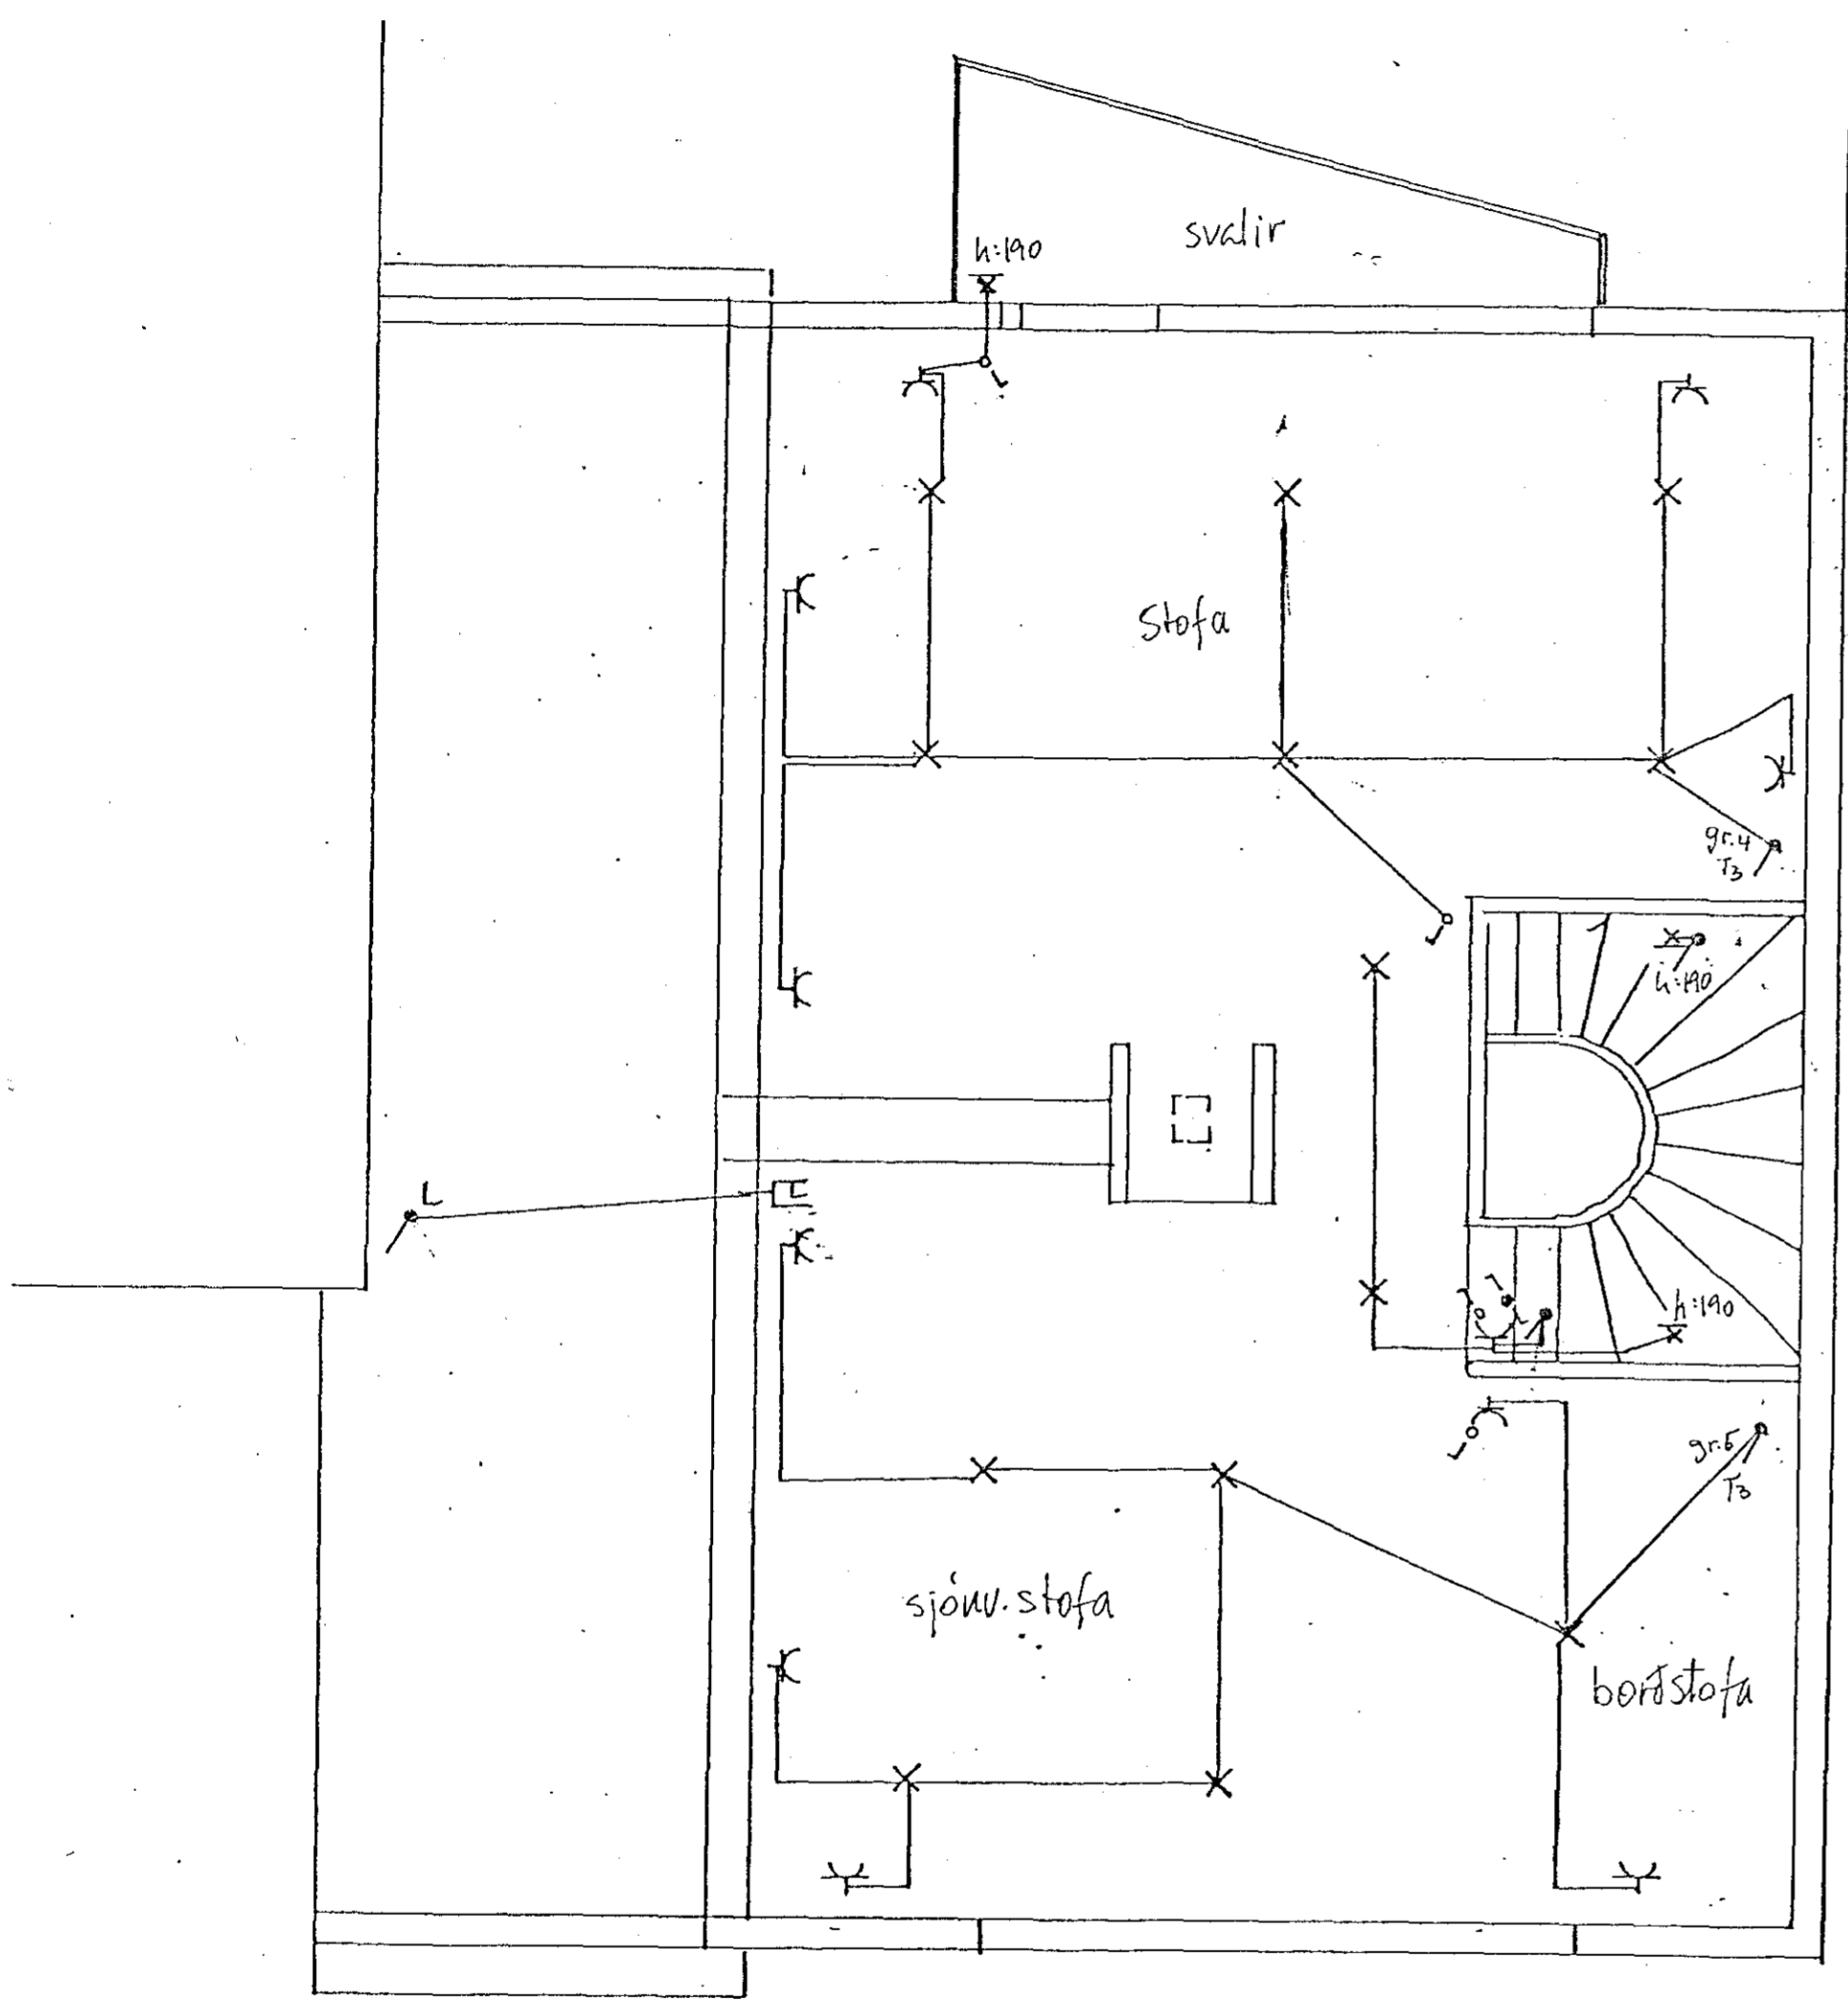

Ris

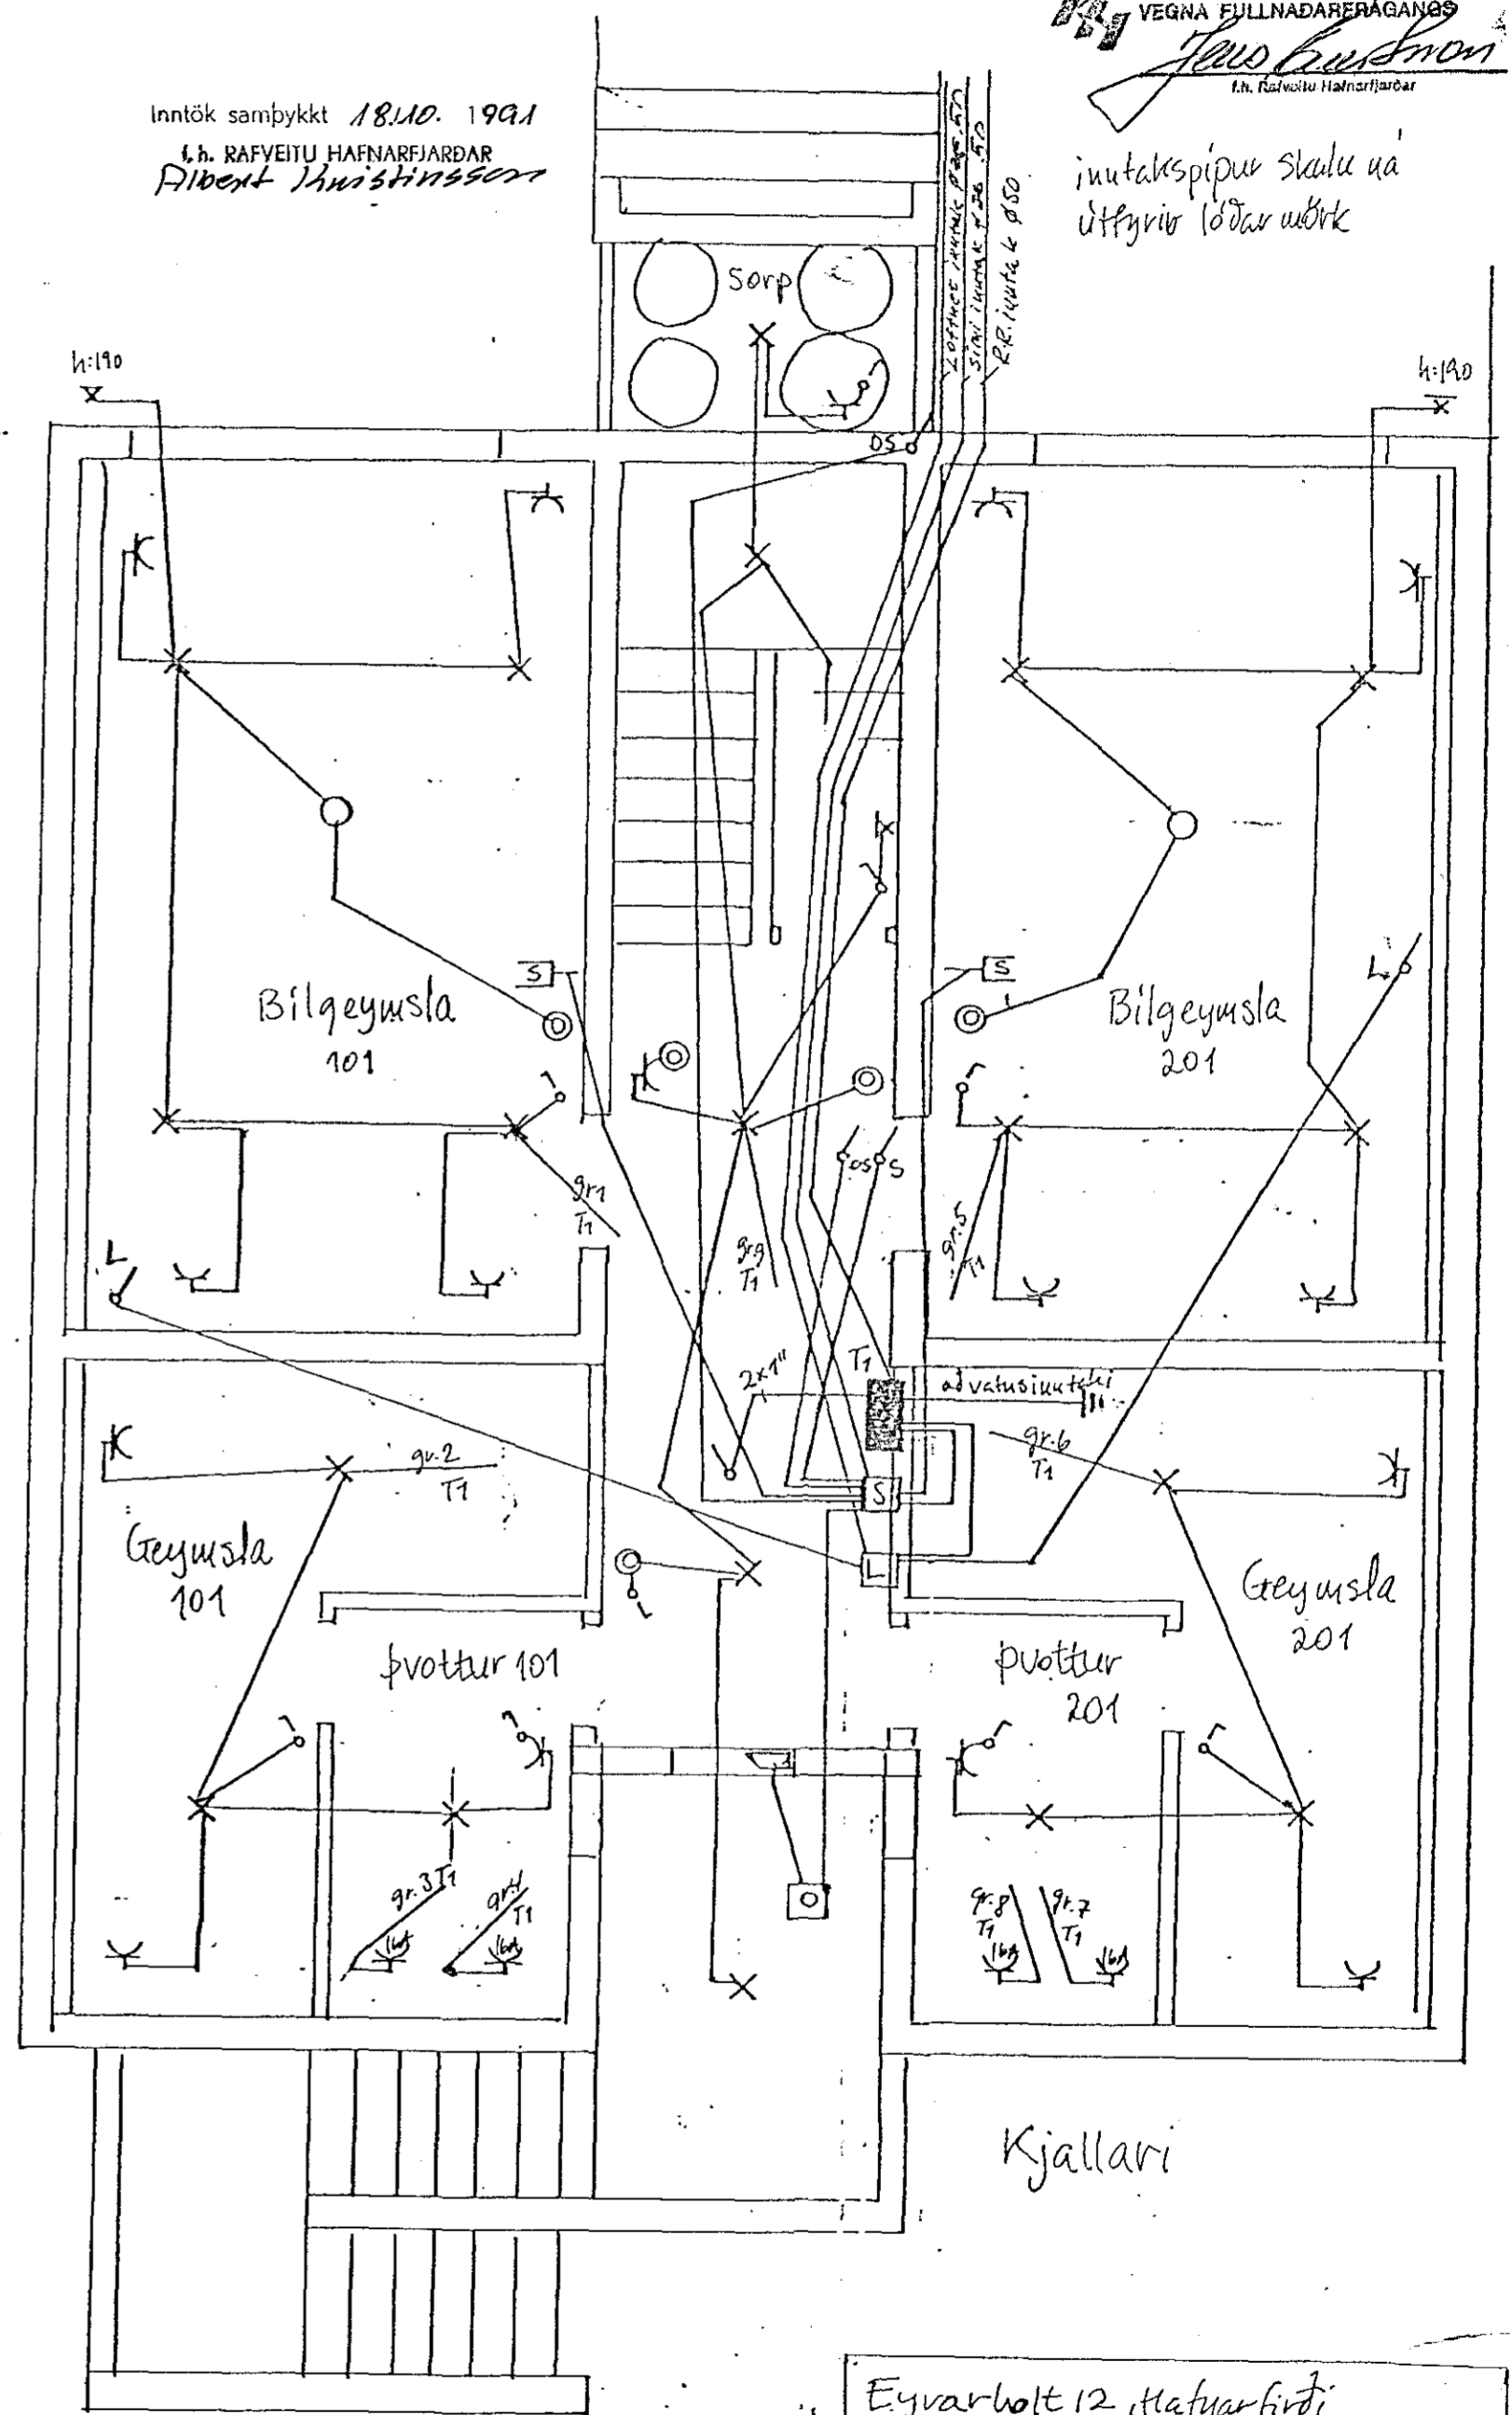

Kjallari

Eyvarholt 12, Hlafnarfirdi		
tekið 18/9/91	Rafveitu Ris og Kjallari	
	Rásin s/f. 656750	Kvardi
Bla. 14/3	Erlendur Þorsteinsson	1:50