


RAFM. Ø50 mm.  
SÍMI Ø50 mm.  
DÝPT 60cm.

ÖLL INNTAKSRÖR SKULU  
NÁ ÚT FYRIR LÖDAMÖRK.

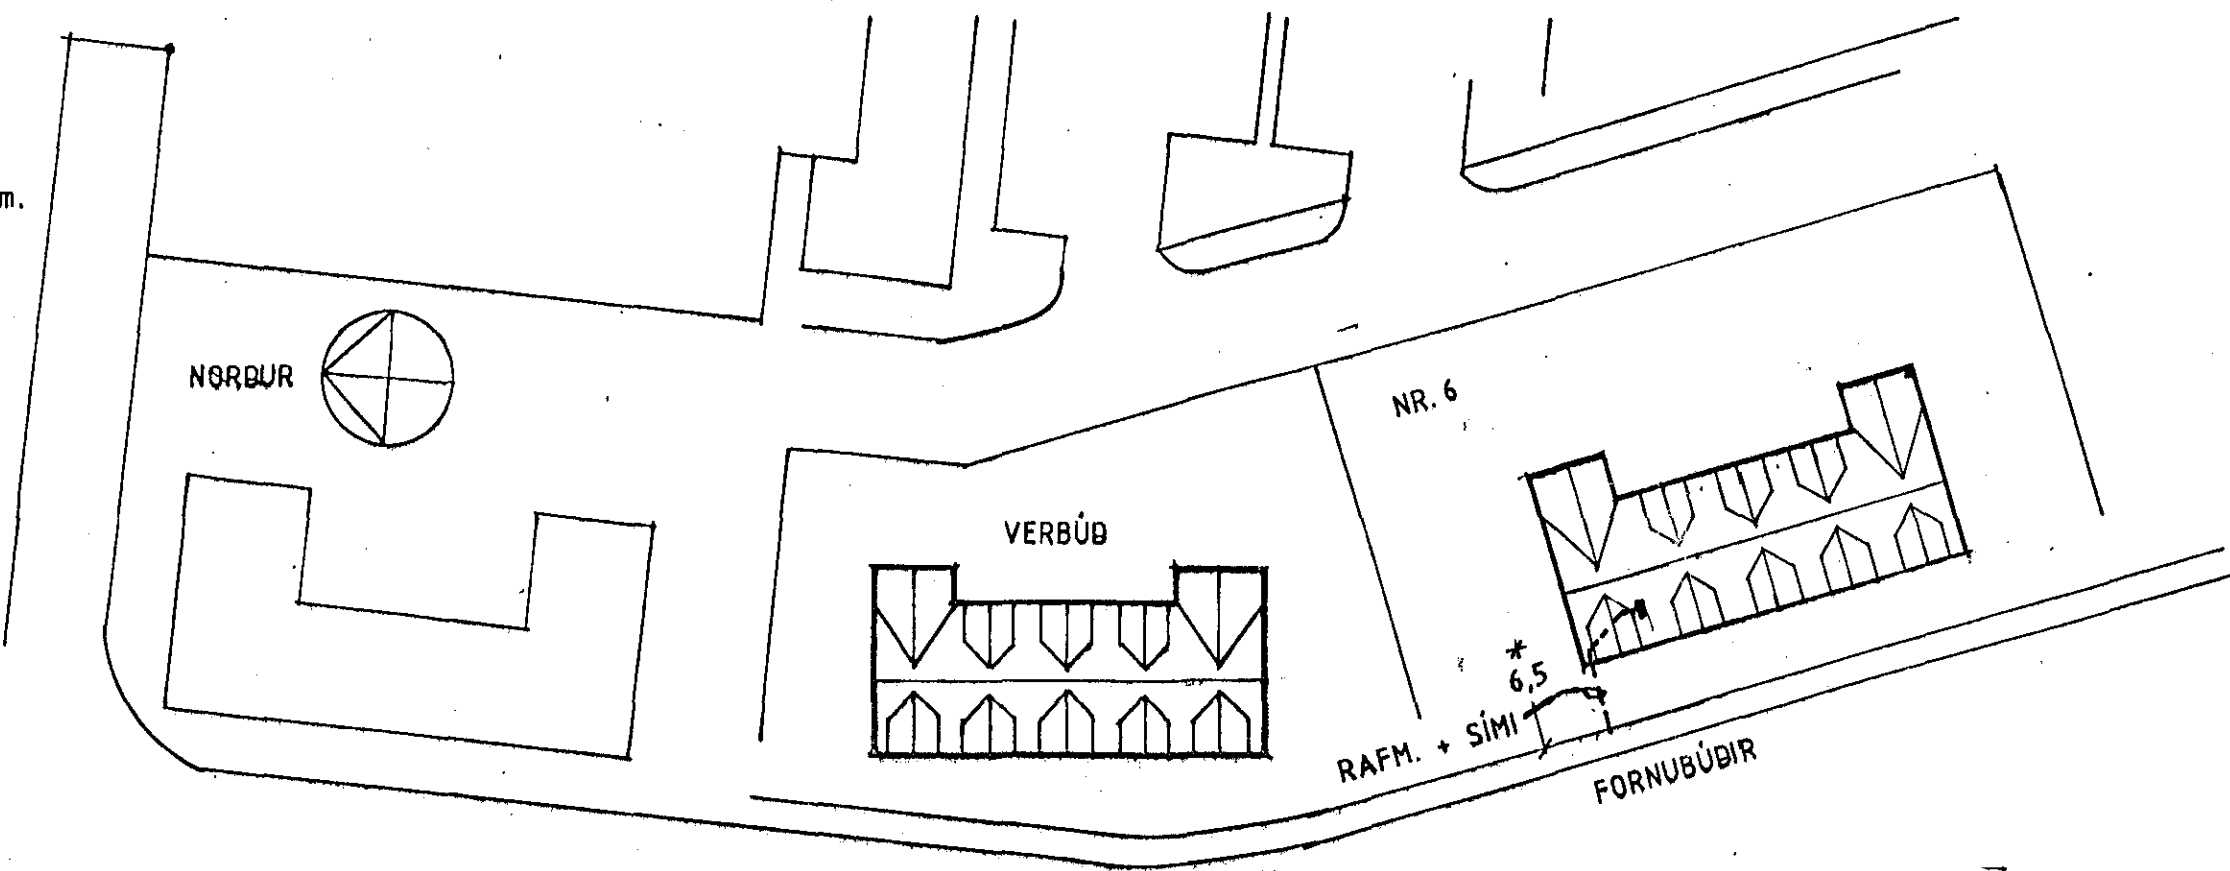

Samþykkt 14-5 1991  
VEGNA FULLNADARFRÁGANGS  
*Alfred Sveinsson*  
Lh. Rafveitu Háfnarfjardar

Innlök samþykkt 22.14. 1991  
Lh. RAFVEITU HAFNARFJARDAR  
*Albert Kristjánsson*

TEIKNING NR. 2922

<b>LJÓSTÆKNI</b> <small>Teiknistofa Skúlagötu 83 Reykjavík, sími 14041 Magnús Sigurðsson teknifræðingur tlf</small>	FORNÚBÚÐIR 6	VERK NR.
	VERBÚÐIR VIÐ FLENSBORGARHÖFN. HAFNARFIRÐI	<b>RAFLÖGN</b>
	GRUNNMYND HÆÐAR MKV. 1:50	BLAD 1 AF 3
	AFSTÖBUMYND MKV. 1:500	90.12. <i>ABsig</i>