

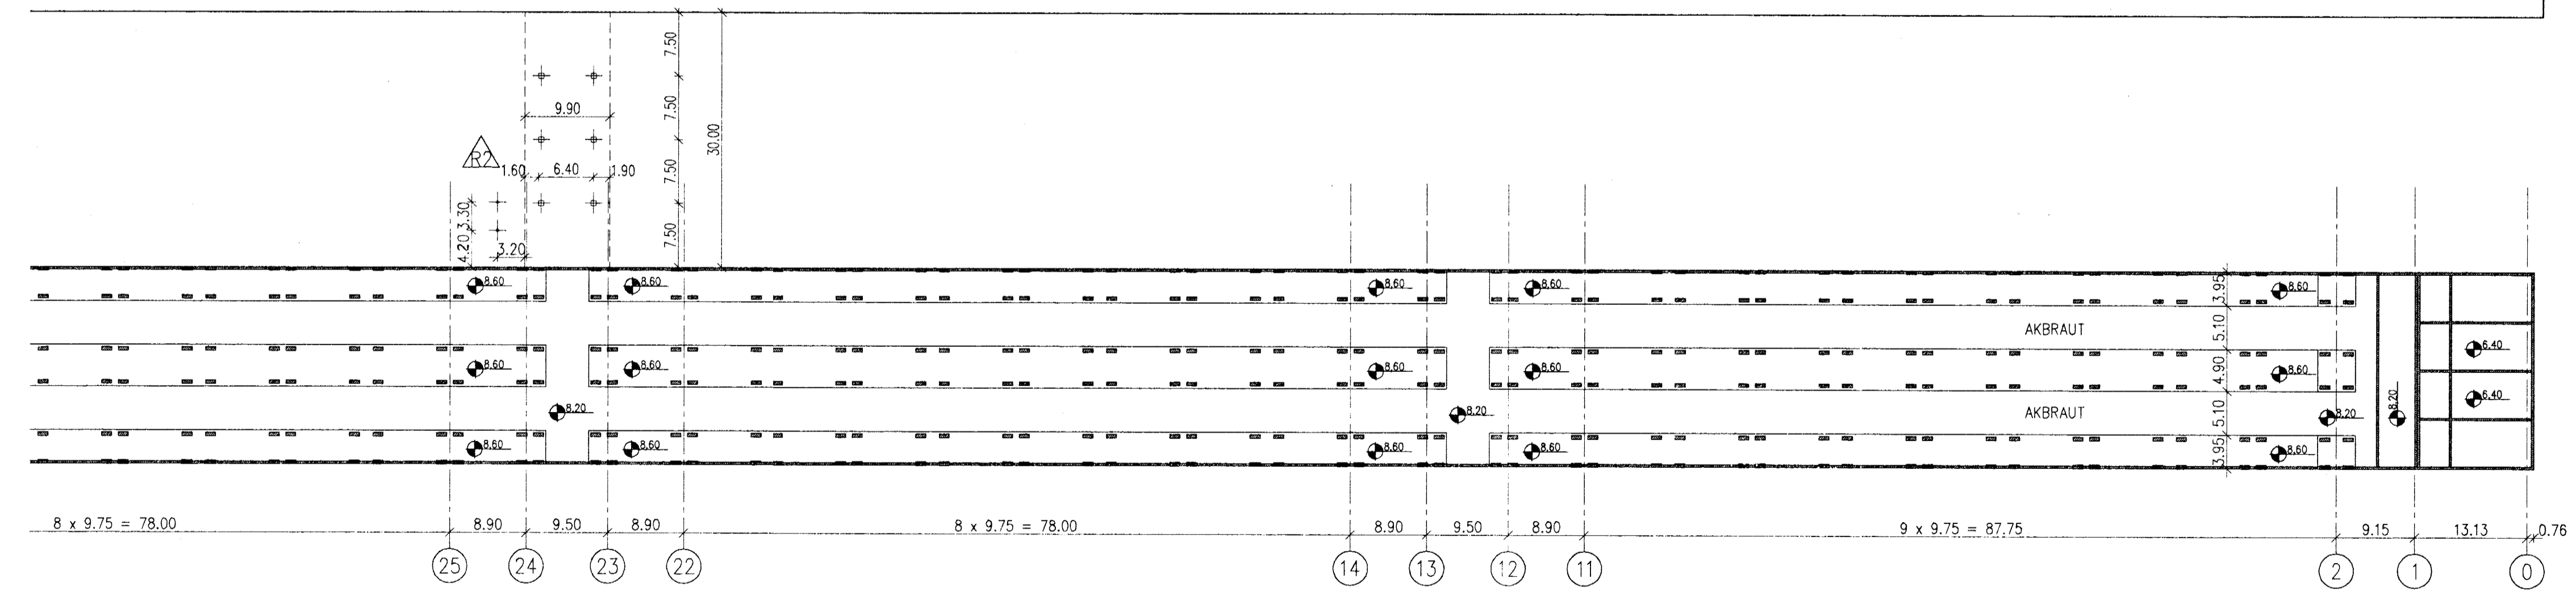


GRUNNMYND JARHAEDAR

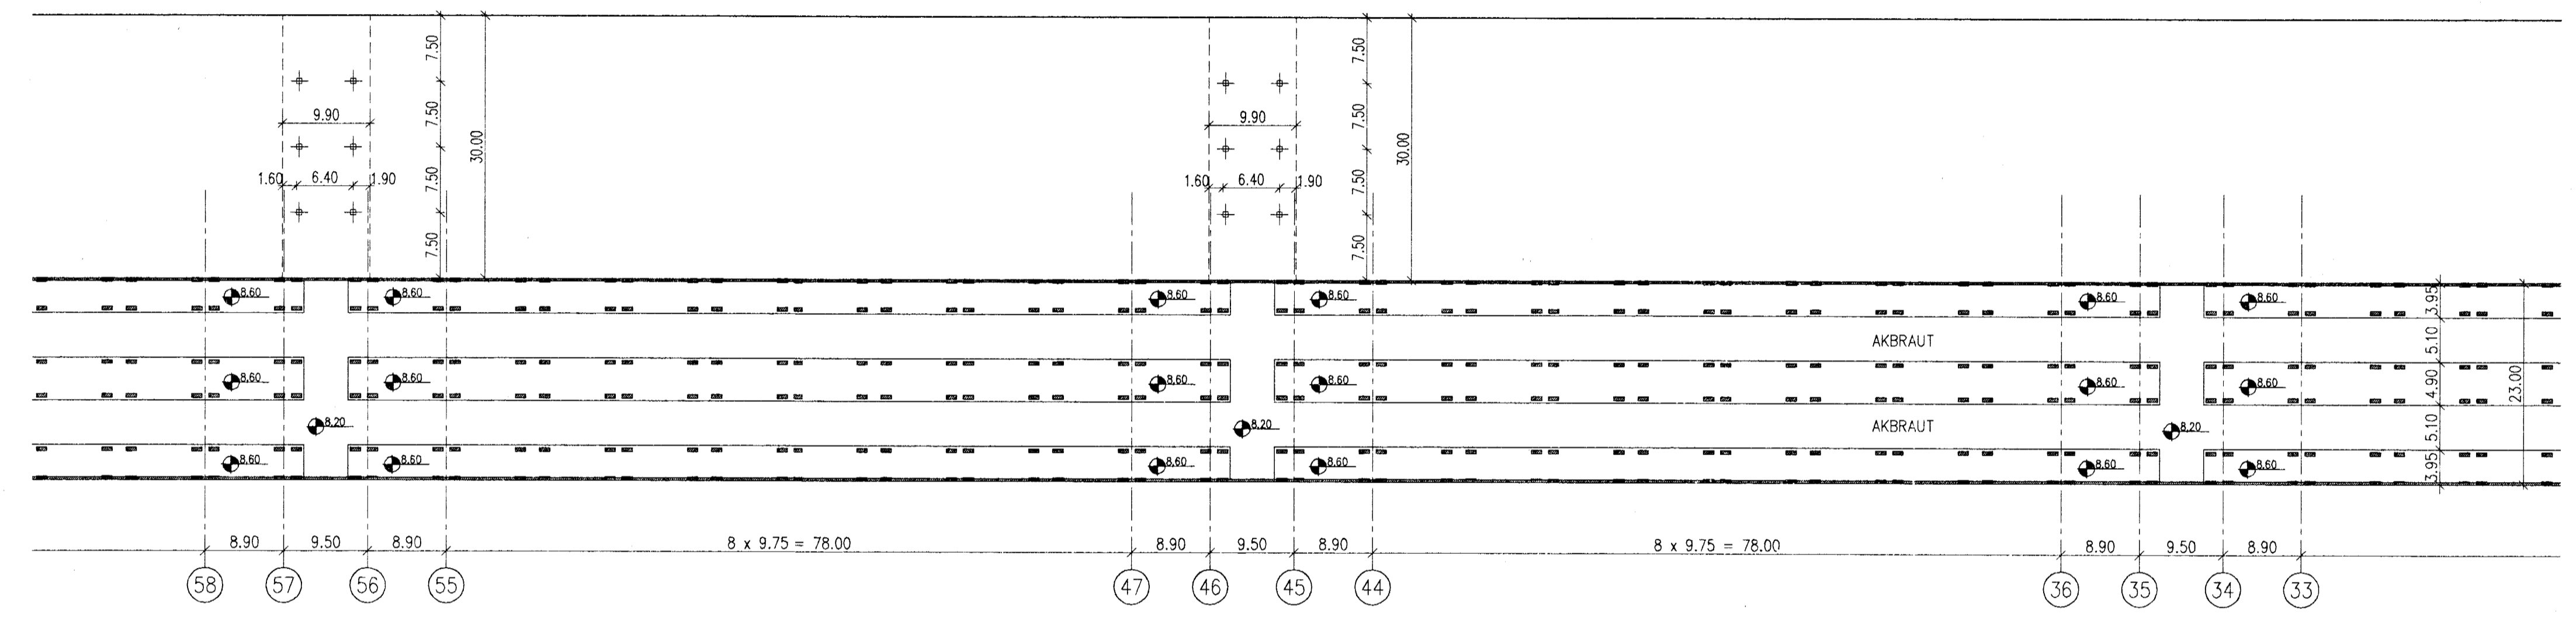

L total = 867.34

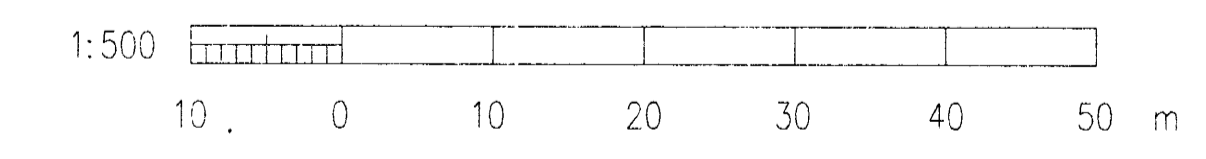

Brunamálastofnun ríkisins
 SAMPYKKT
 13 FEB. 1996
 Arnir Arnason

Nils Halvarsson

REV. NO.	DATE	REVISION	BY	APP.	REV. NO.	DATE	REVISION	BY	APP.	NOTES	REFERENCE DRAWING	DRAWING NUMBER
2	10/2 1996	MINOR REVISION	NI	N.I.								
1	20/1 1996	TENGINGANGAR	KS	N.I.								

VST CONSULTING ENGINEERS Ltd. Armula 4 108 Reykjavik Iceland Tel: +354 569 5000 Fax: +354 569 5010	DRAWN NOV. 1995 THS APPROVED 6. NOV. 95 NI PROCESS 6. NOV. 95 NI PROJECT 6. NOV. 95 NI SCALE 1:500	POTROOM NO. 3 ARCHITECTURAL WORK GROUND FLOOR JARHAED PLAN GRUNNMYND	95.120 - 13.196
	ALESA ALUSUISSE ENGINEERING LTD. ZURICH SWITZERLAND	79000-32696	186.596
ICELANDIC ALUMINIUM COMPANY LTD.	ISAL	ICELANDIC ALUMINIUM CO. LTD	