


PLÖNTULISTI

1	GRÁREYNIR	A STADNUM
2	"	FLUTTUR
3	BIRKI	A STADNUM
4	RAUDBLADARÓS	VÍÐBÓT
5	GLIACÍDIR	A STADNUM
6	LEGGUR	
7	GLIAMISPILL	
8	RAUÐTOPPUR	
9	YLLIR	
10	ÞOKKARÓS	
11	BLATOPPUR	
12	SKRÍDMISPILL	
13	GRÁVÍDIR	
14	SITKAGRENI	A STADNUM

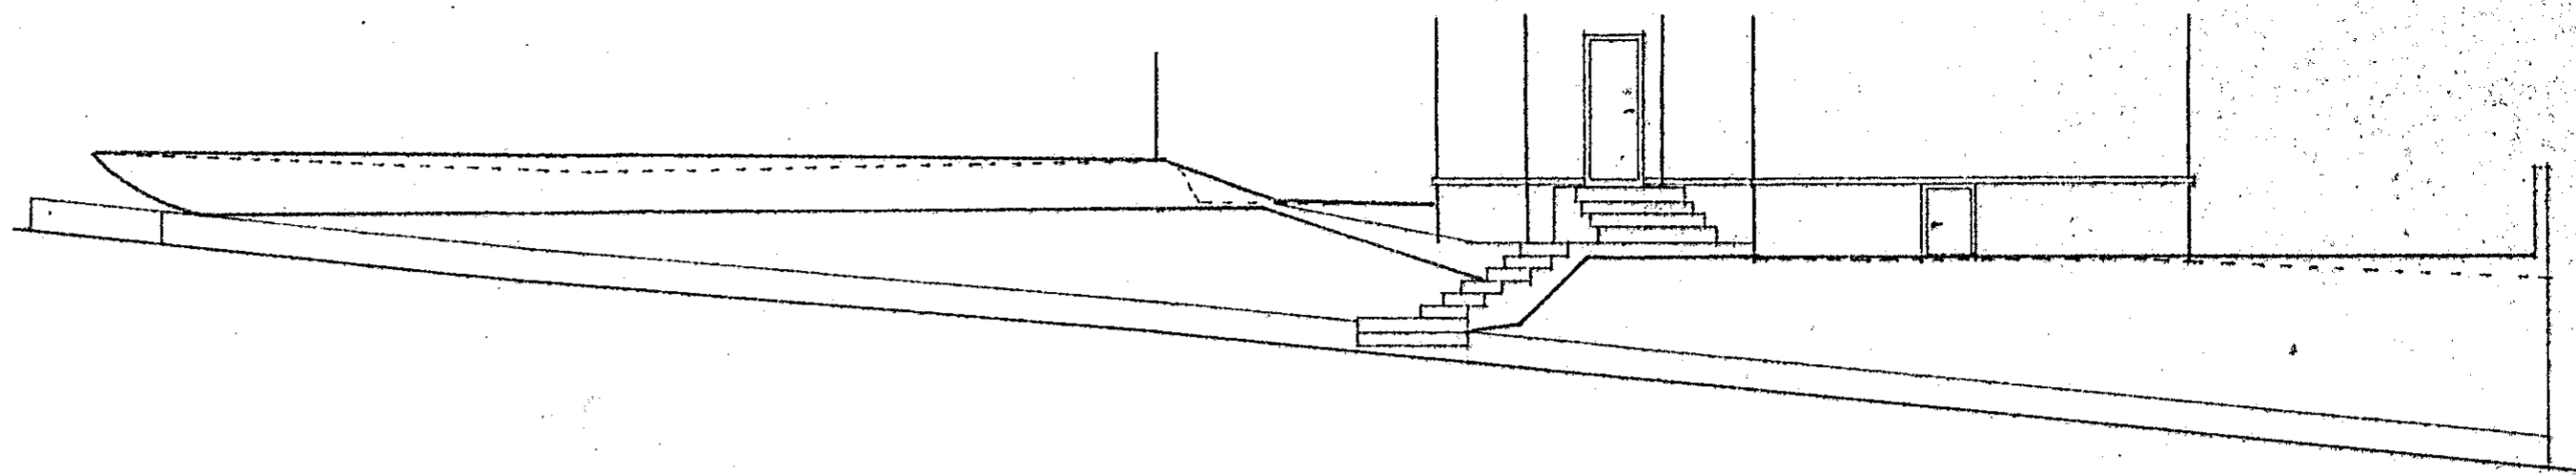


SNID A-A

$$\begin{aligned}
 10,80 \times 11,44 &= 123,55 \text{ m}^2 \\
 \frac{2590 \times 1420}{2} &= 185,19 \text{ " } \\
 \frac{2590 \times 1070}{2} &= 138,57 \text{ " } \\
 \frac{2470 \times 0,60}{2} &= 7,47 \text{ " } \\
 \frac{350 \times 316}{2} &= 11,06 \text{ " } \\
 \hline
 &= 454,78 \text{ m}^2 \\
 &= 443,72 \text{ m}^2 \approx 444 \text{ m}^2 \\
 &\text{@ } 4-1,332,-
 \end{aligned}$$

SNID B-B

SNID C-C

SNID D-D

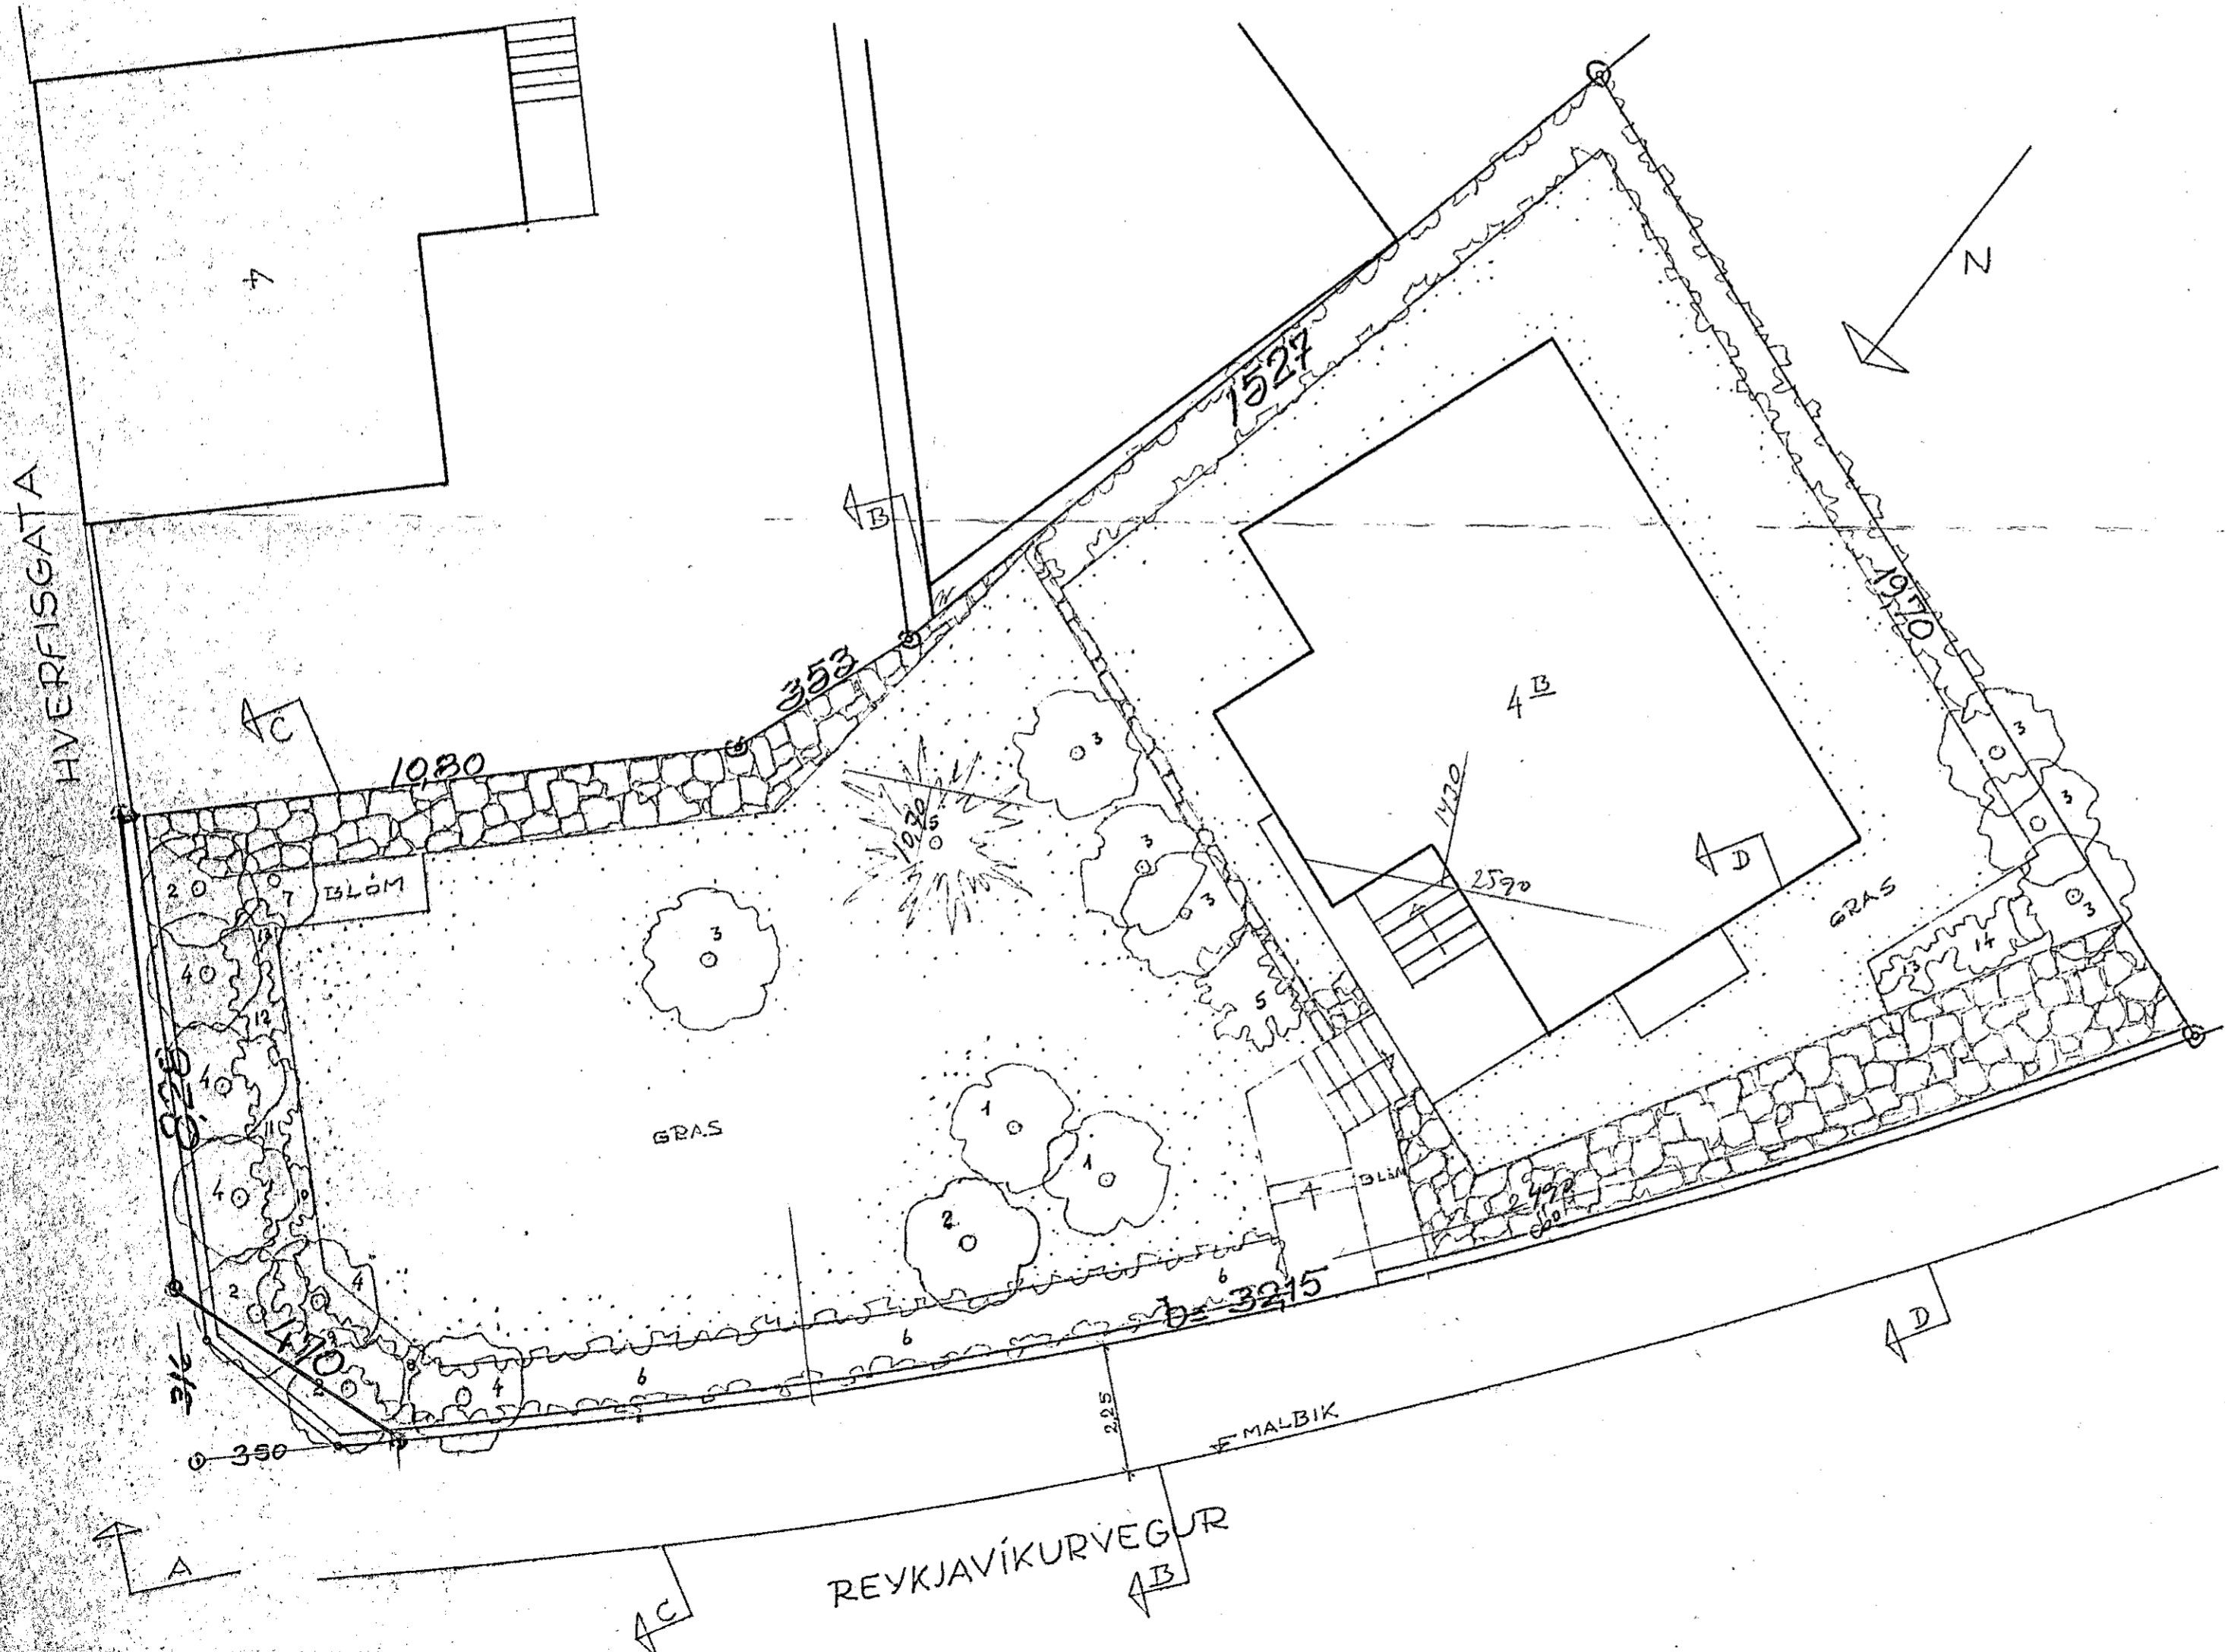

BÆJARVERKFRÆÐINGURINN HAFNARFIRÐI					
MÁLICKI	REYKJAVÍKURV. 4B				
1:100	ÞREYTING Á SKRÚÐGARÐI VEGNA MARKASKILPA Á LÖBUM				
BLAD	MALT	REIKNING	TÖKNAD	SAMP.	GREYTT
FSIG.	BSM.Þ.J.		TS.M.		NR.
					DAGS
					FEBR. 1967