

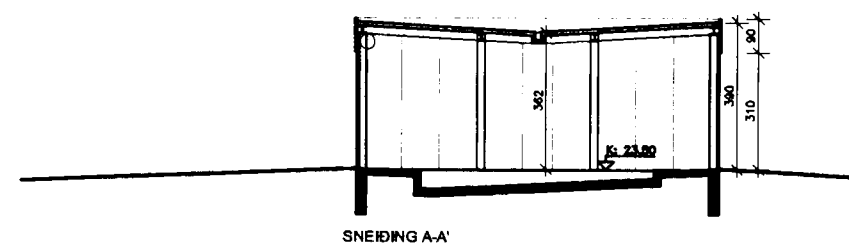
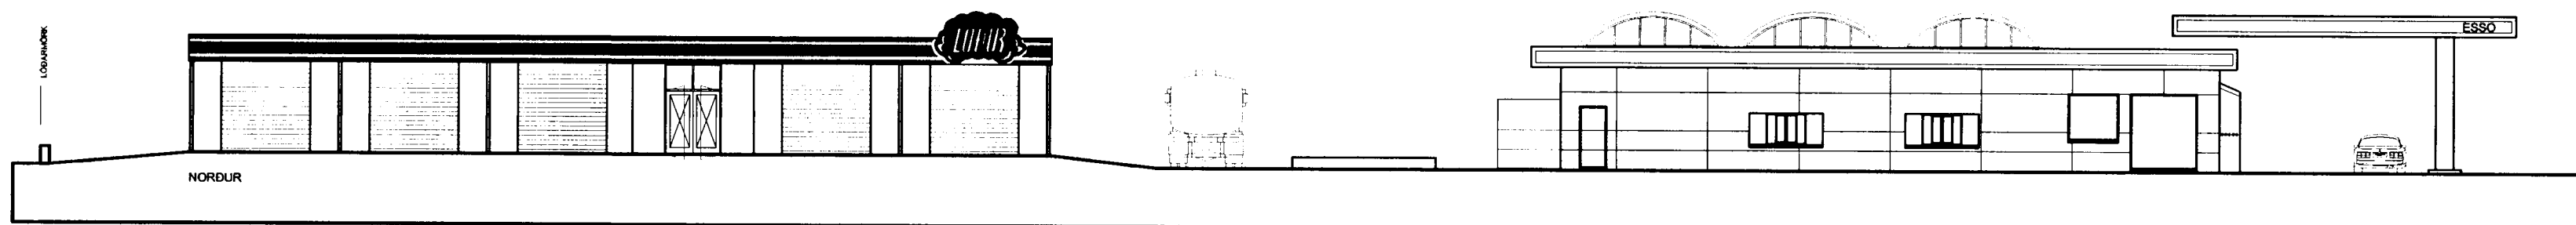
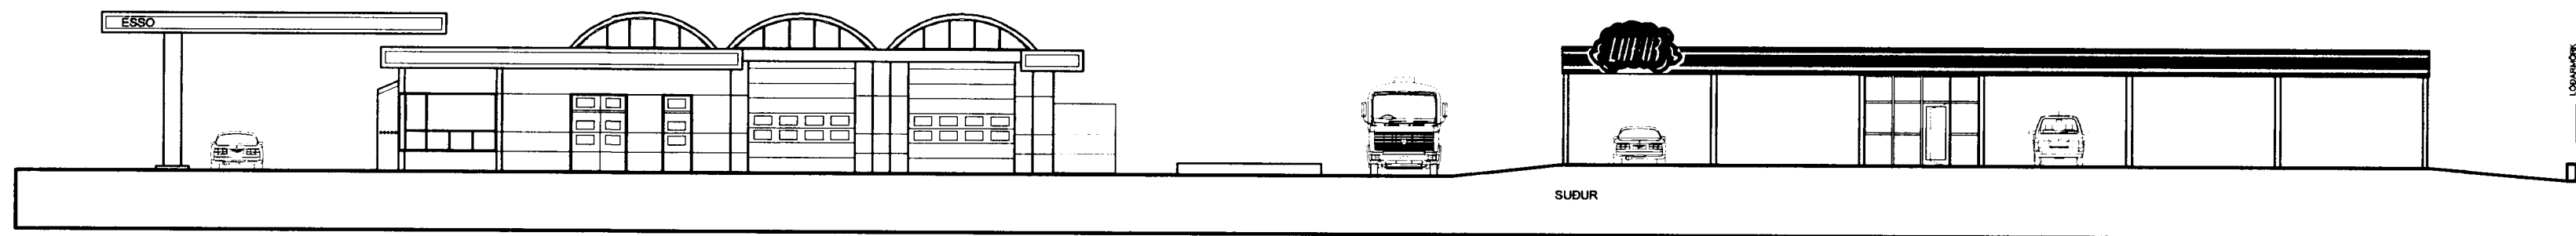
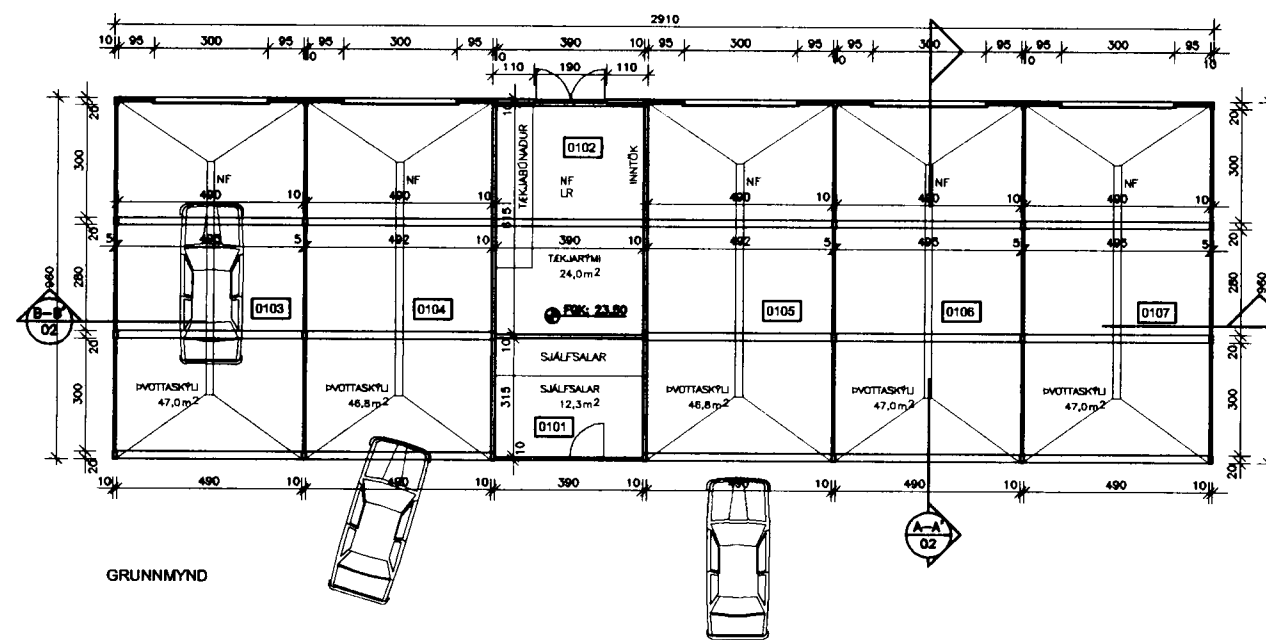



Sambúkk á fundi
 Skipulags- og byggingarráðs
 n 3 DES. 2002
 Erlendur Hjálmarsson

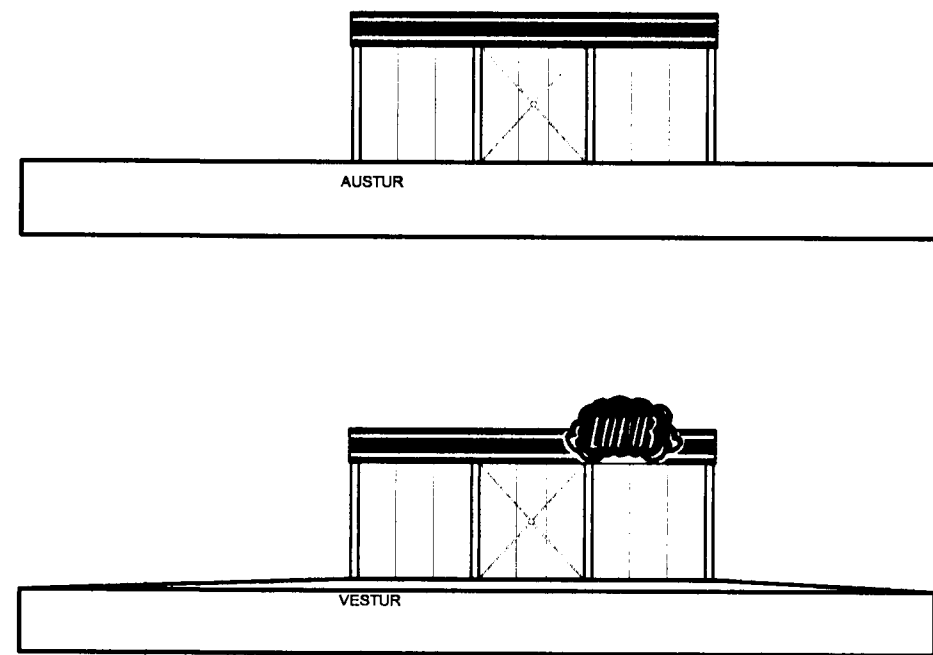

SNEIÐING A-A

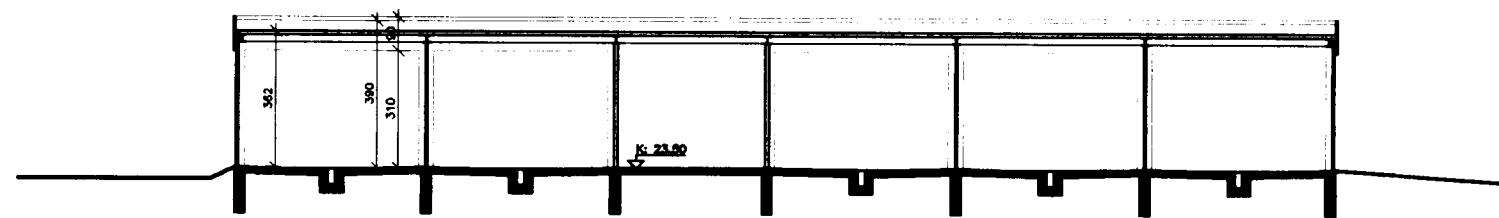

SNEIÐING B-B

BREYTT			
REYKJAVÍKURVEGUR 54			
ÞVOTTASTÖÐ			
GRUNNMYND, ÚTLIT		KVARDI: 1:200	
DAGS.: 27.11.2002		STADF. BURDARÞÓL	
HANNAD: JL/KÁ	TEIKNAD: TH	YFIRF.: KÁ	
ALARK arkitektur sf.			HAMBORG 7 200 KOPAVOGI SMAR 564 1137 OG 564 5244 FAX: 564 4433 alark@arkitekt.com KT: 501193-2409 www.alark.com
			03 AF 3