


20.29-

Ahl's kota

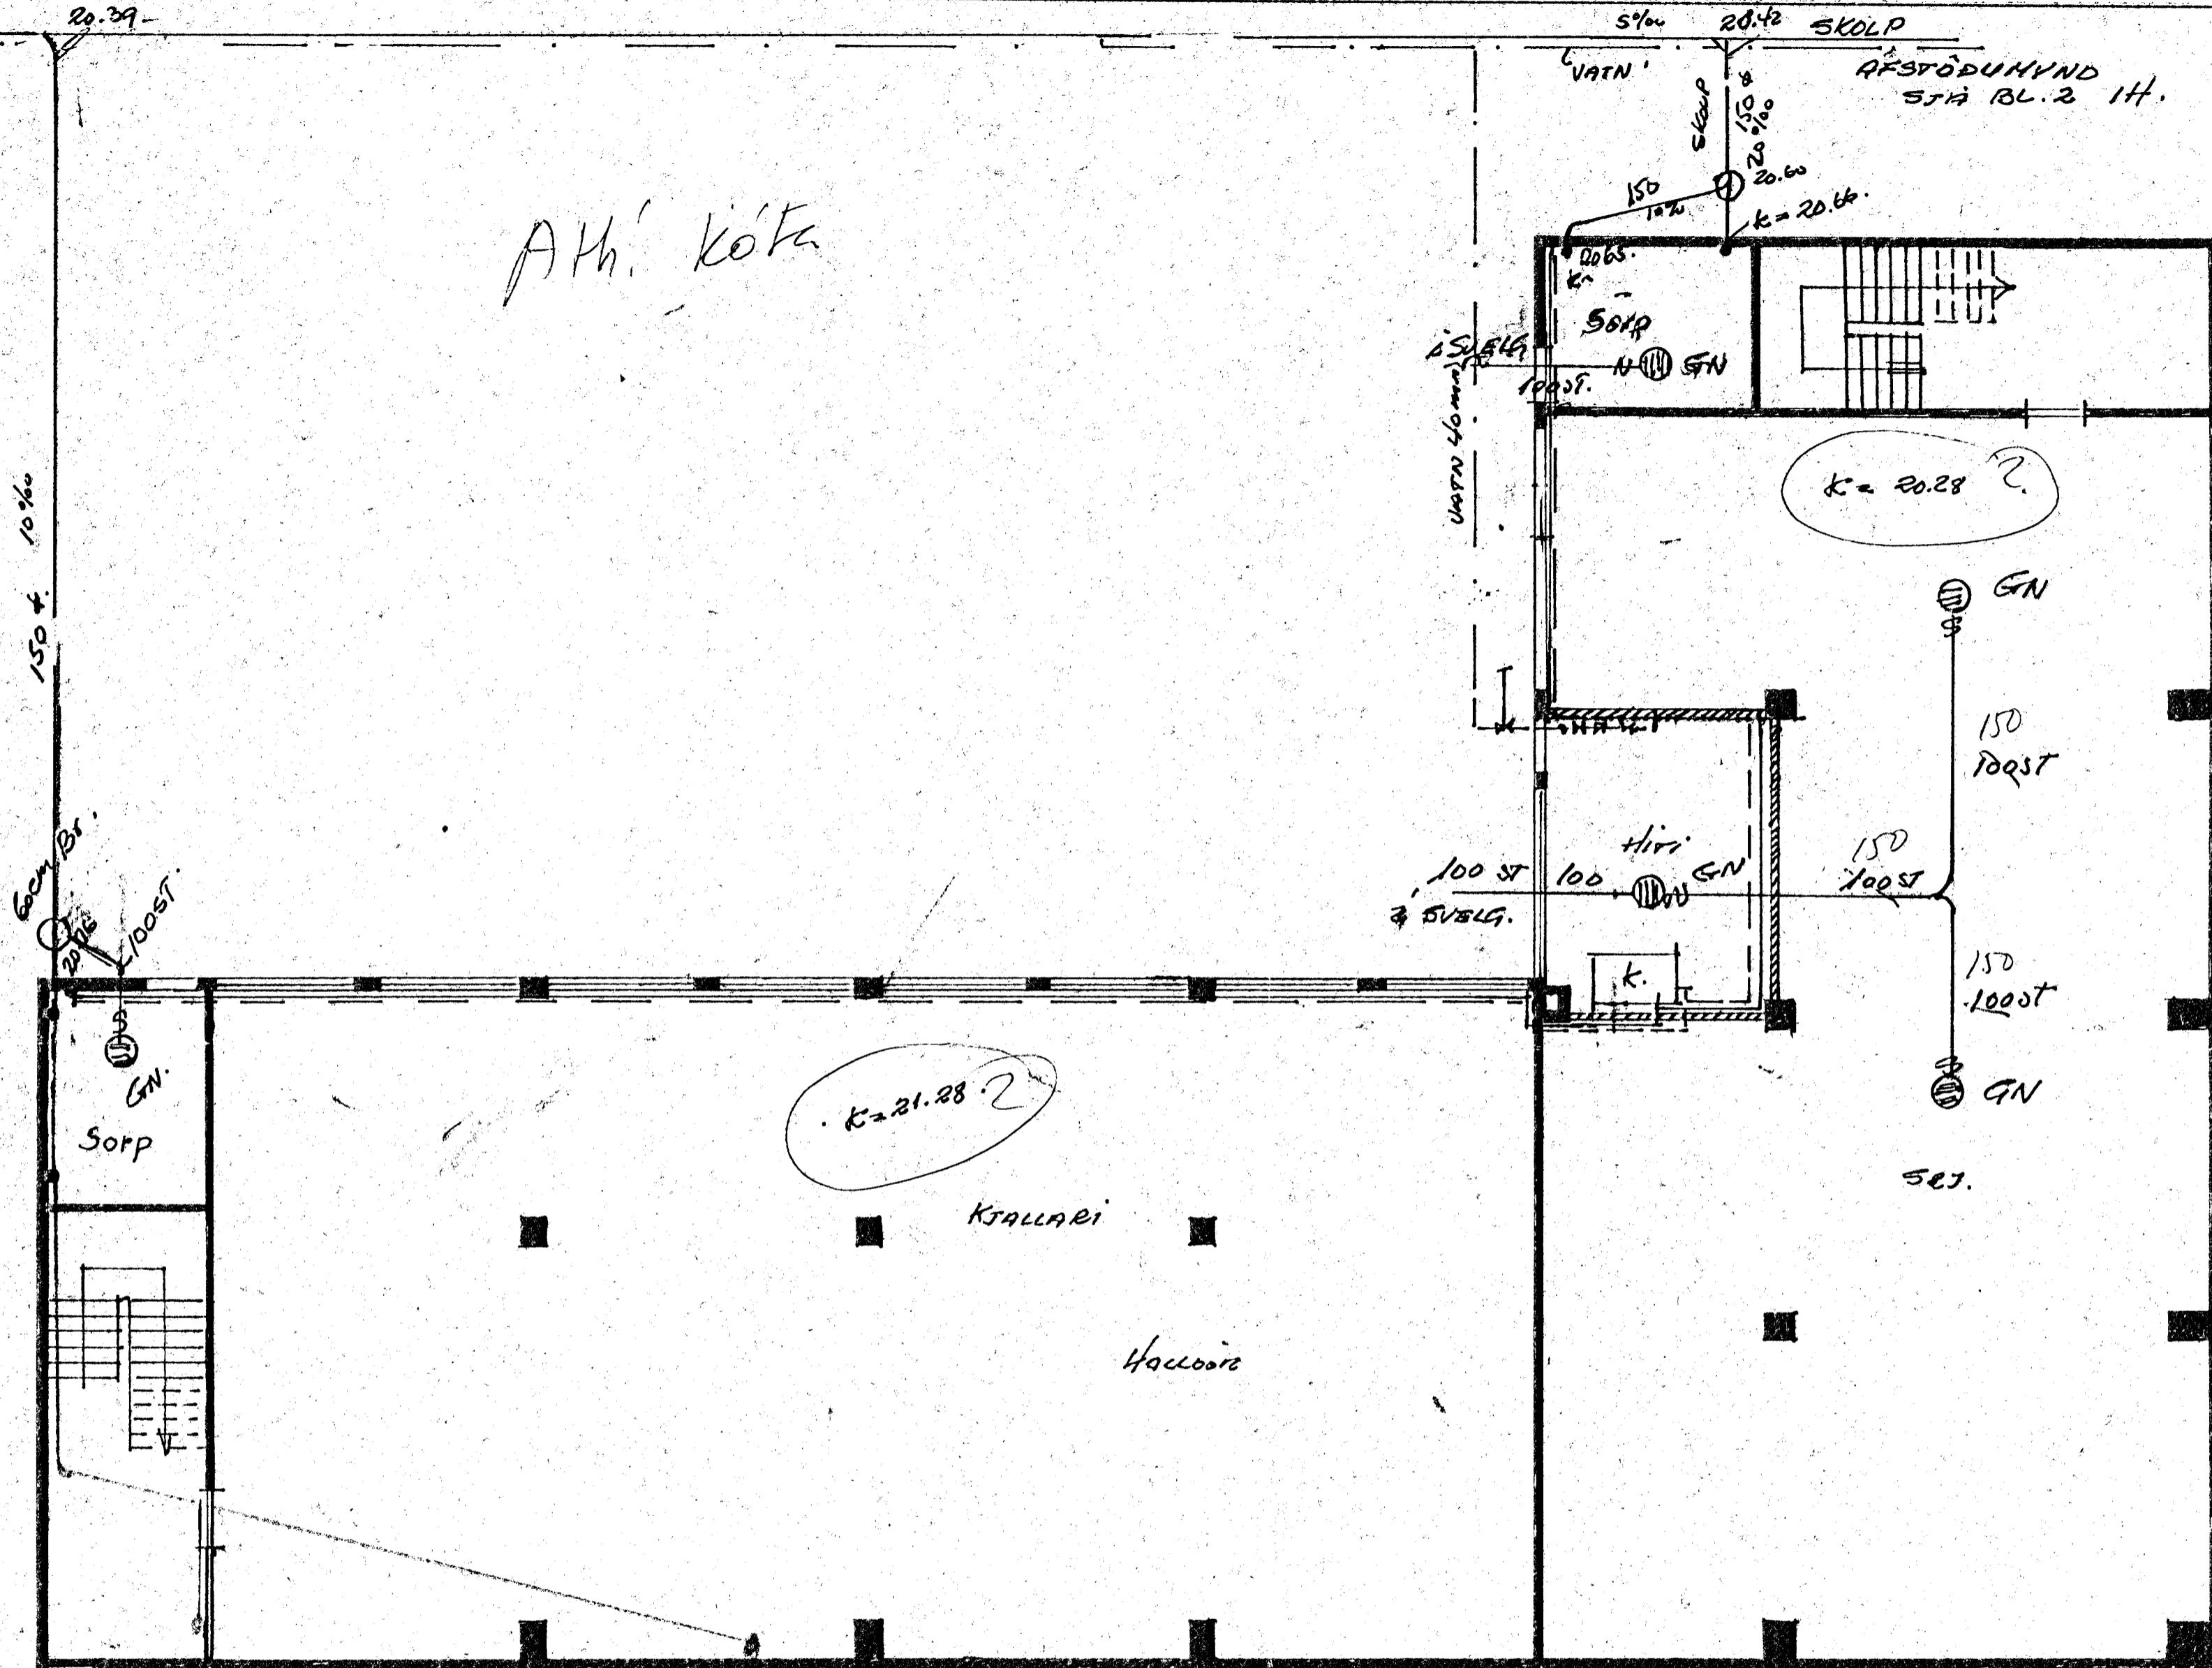

Ahl's
Hitaveitiparameyli
i höfðuvecklu

KJALLARI.

REVKJA VIKUR VEG. 60
SKOLP & VATN

TEIKN.	Teikn.
DAGI.	4.6.74

Kolbeinn Þ. G. Jónasson.
Leitvæg. 5. 10963.

TEIKN. NR.	7400
BL.	1