


REYKJAVÍKURVEGUR.

RFSTODU MYND
1:500

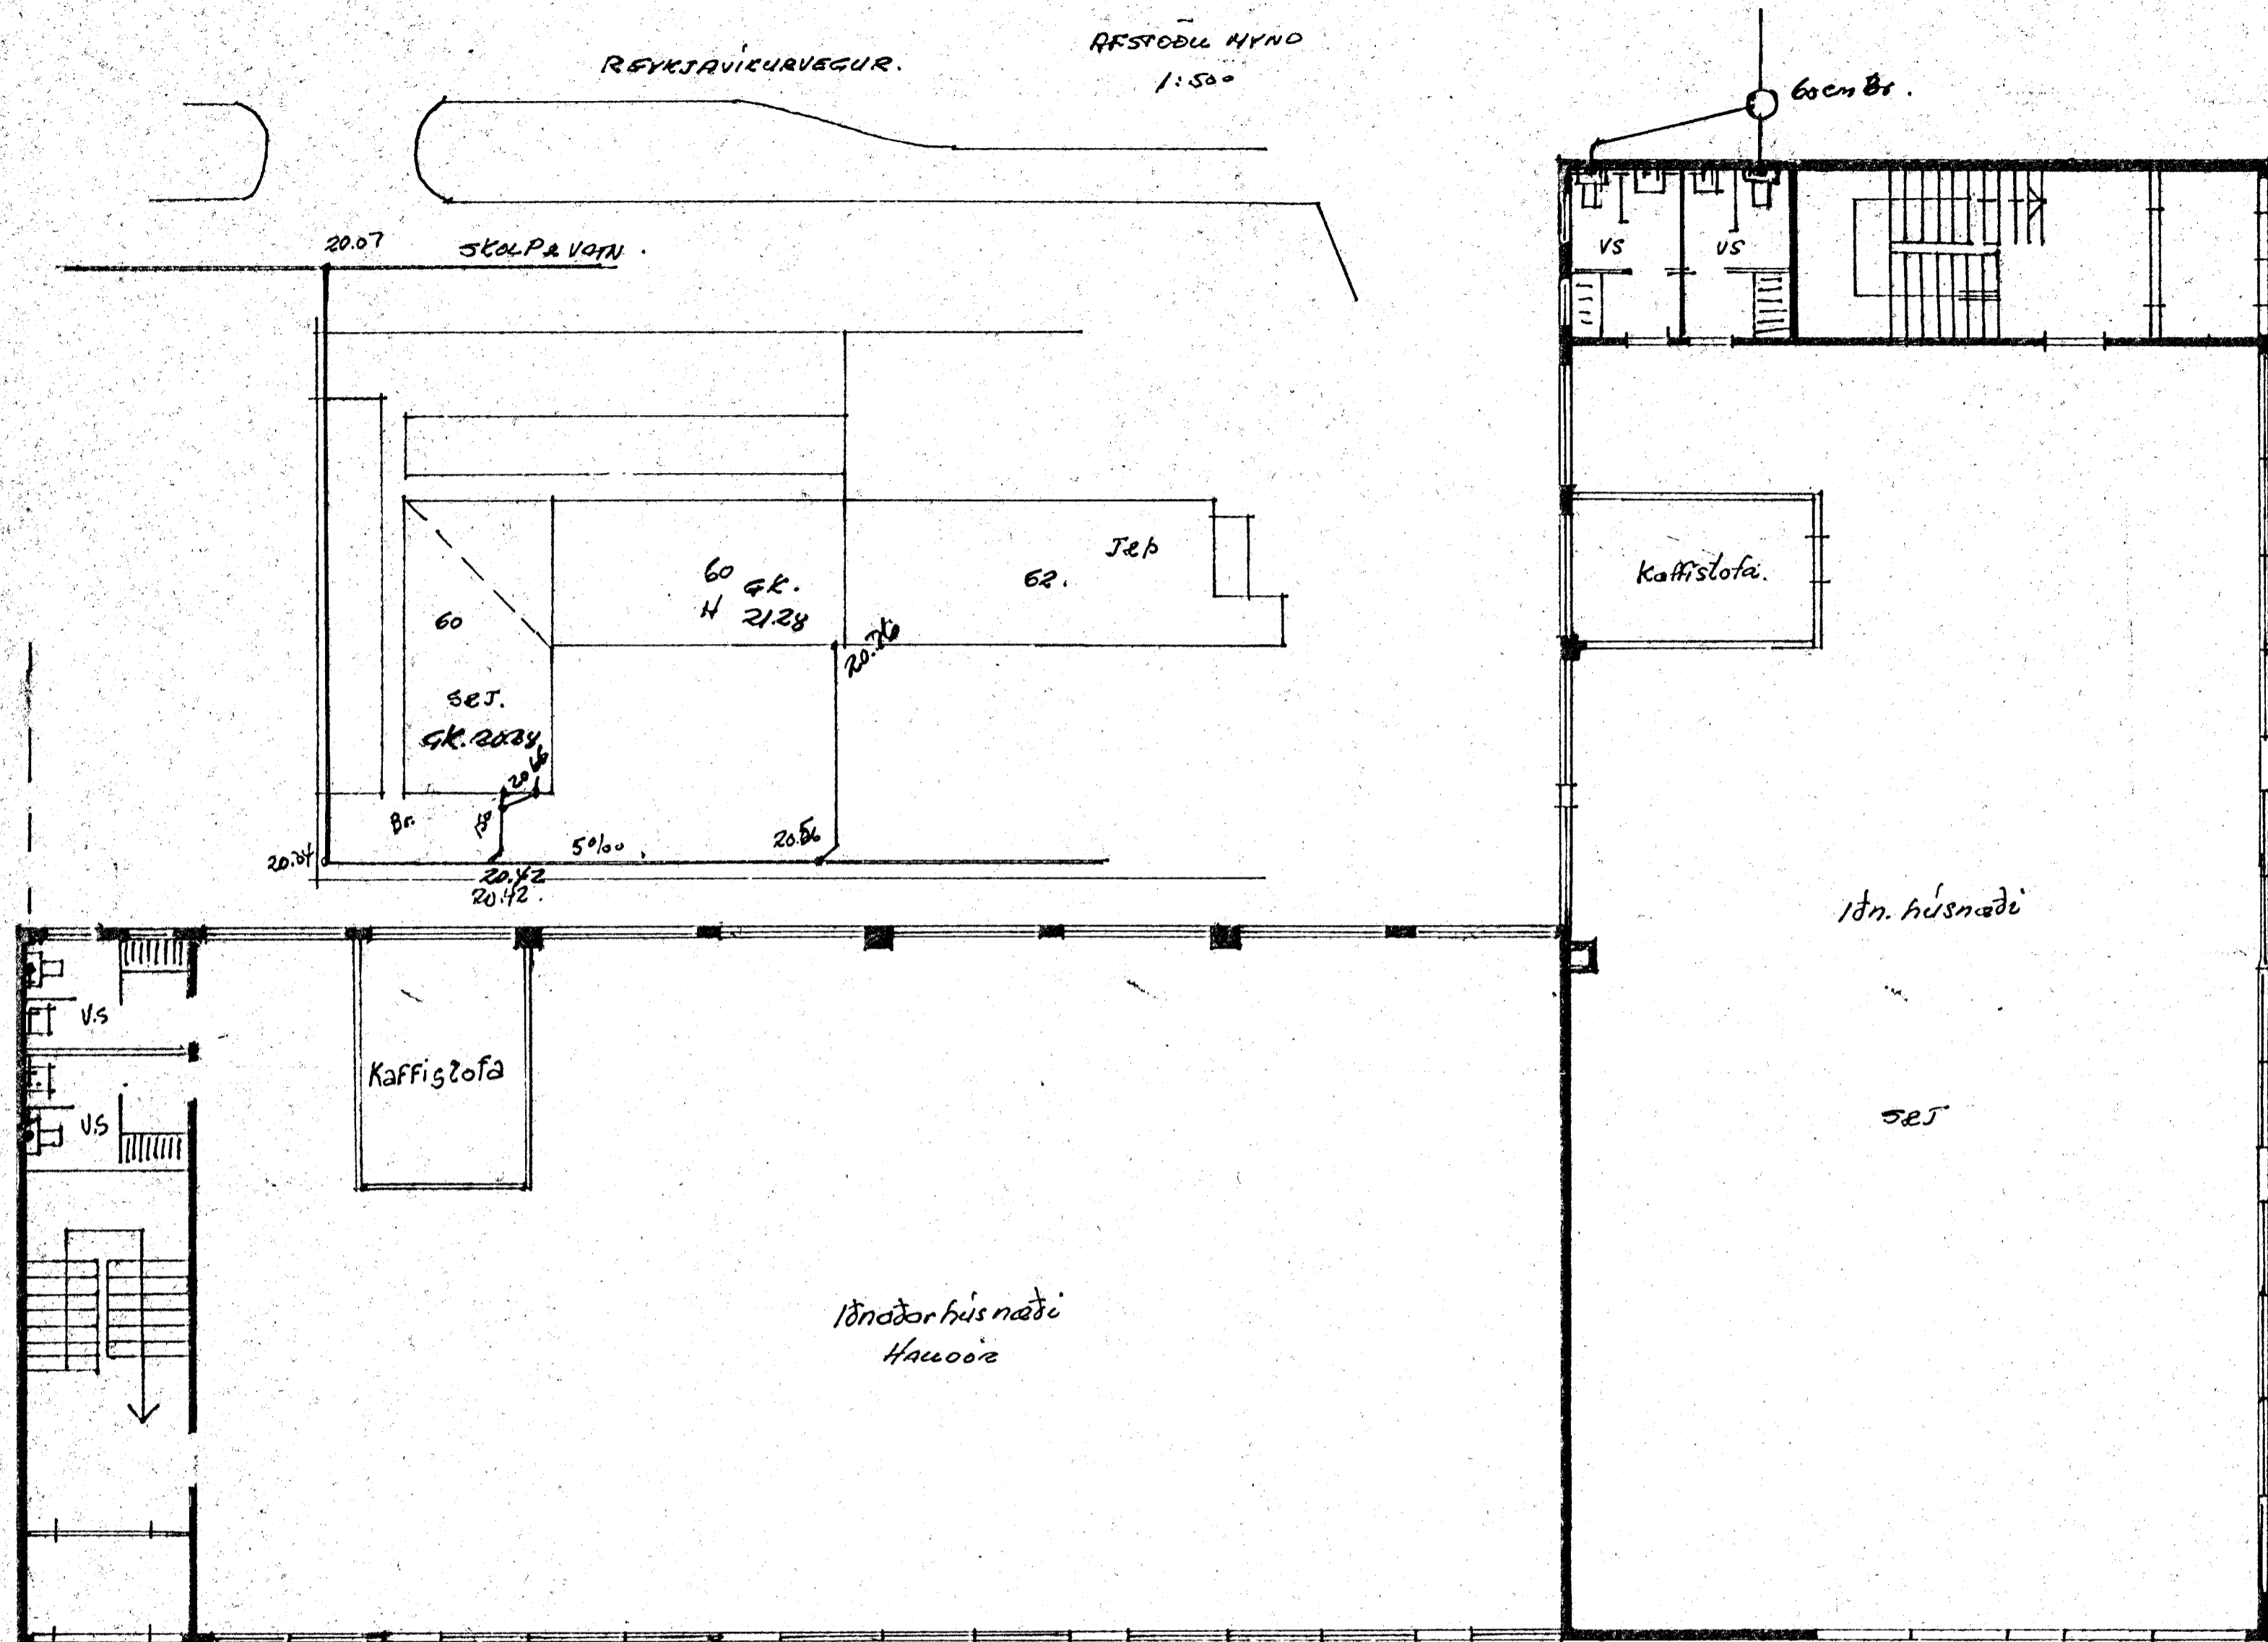

REYKJAVÍKUR VEG. 60 SKOL & VATN T-III Höð.	1:100	TEIKN.	DK
Stalheimi E. Jóns febrúar 1963	TEIKN. NR. 1326	7400	