


Panel - Stalotnar.

Nr.	Gerð	Teng.	Nr.	Gerð	Teng.
101	P ₂ 440 - 3600	AD	116	P 740 - 1600	CD
102	P ₂ 440 - 3600	CB	117	P 740 - 3600	AD
103	P ₂ 440 - 3600	AD	118	P 740 - 3600	CB
104	P ₂ 440 - 3600	CB	119	P 740 - 3600	AD
105	P ₂ 740 - 1600	AB	120	P ₂ 440 - 3600	CB
106	P ₃ 440 - 4000	AD	121	P ₂ 440 - 3600	AD
107	P ₂ 740 - 1520	CD	103 ^{fr.}	P 440 - 1200	CB
108	P ₂ 740 - 1520	CD			
109	P ₂ 740 - 1440	AB			
110	P ₂ 740 - 1440	AB			
111	P ₂ 740 - 1440	CD			
112	P 740 - 3600	CB			
113	P 740 - 3600	AD			
114	P 740 - 3600	CB			
115	P 740 - 1600	AB			

4stk.

Sleppt.
nouv. 78.

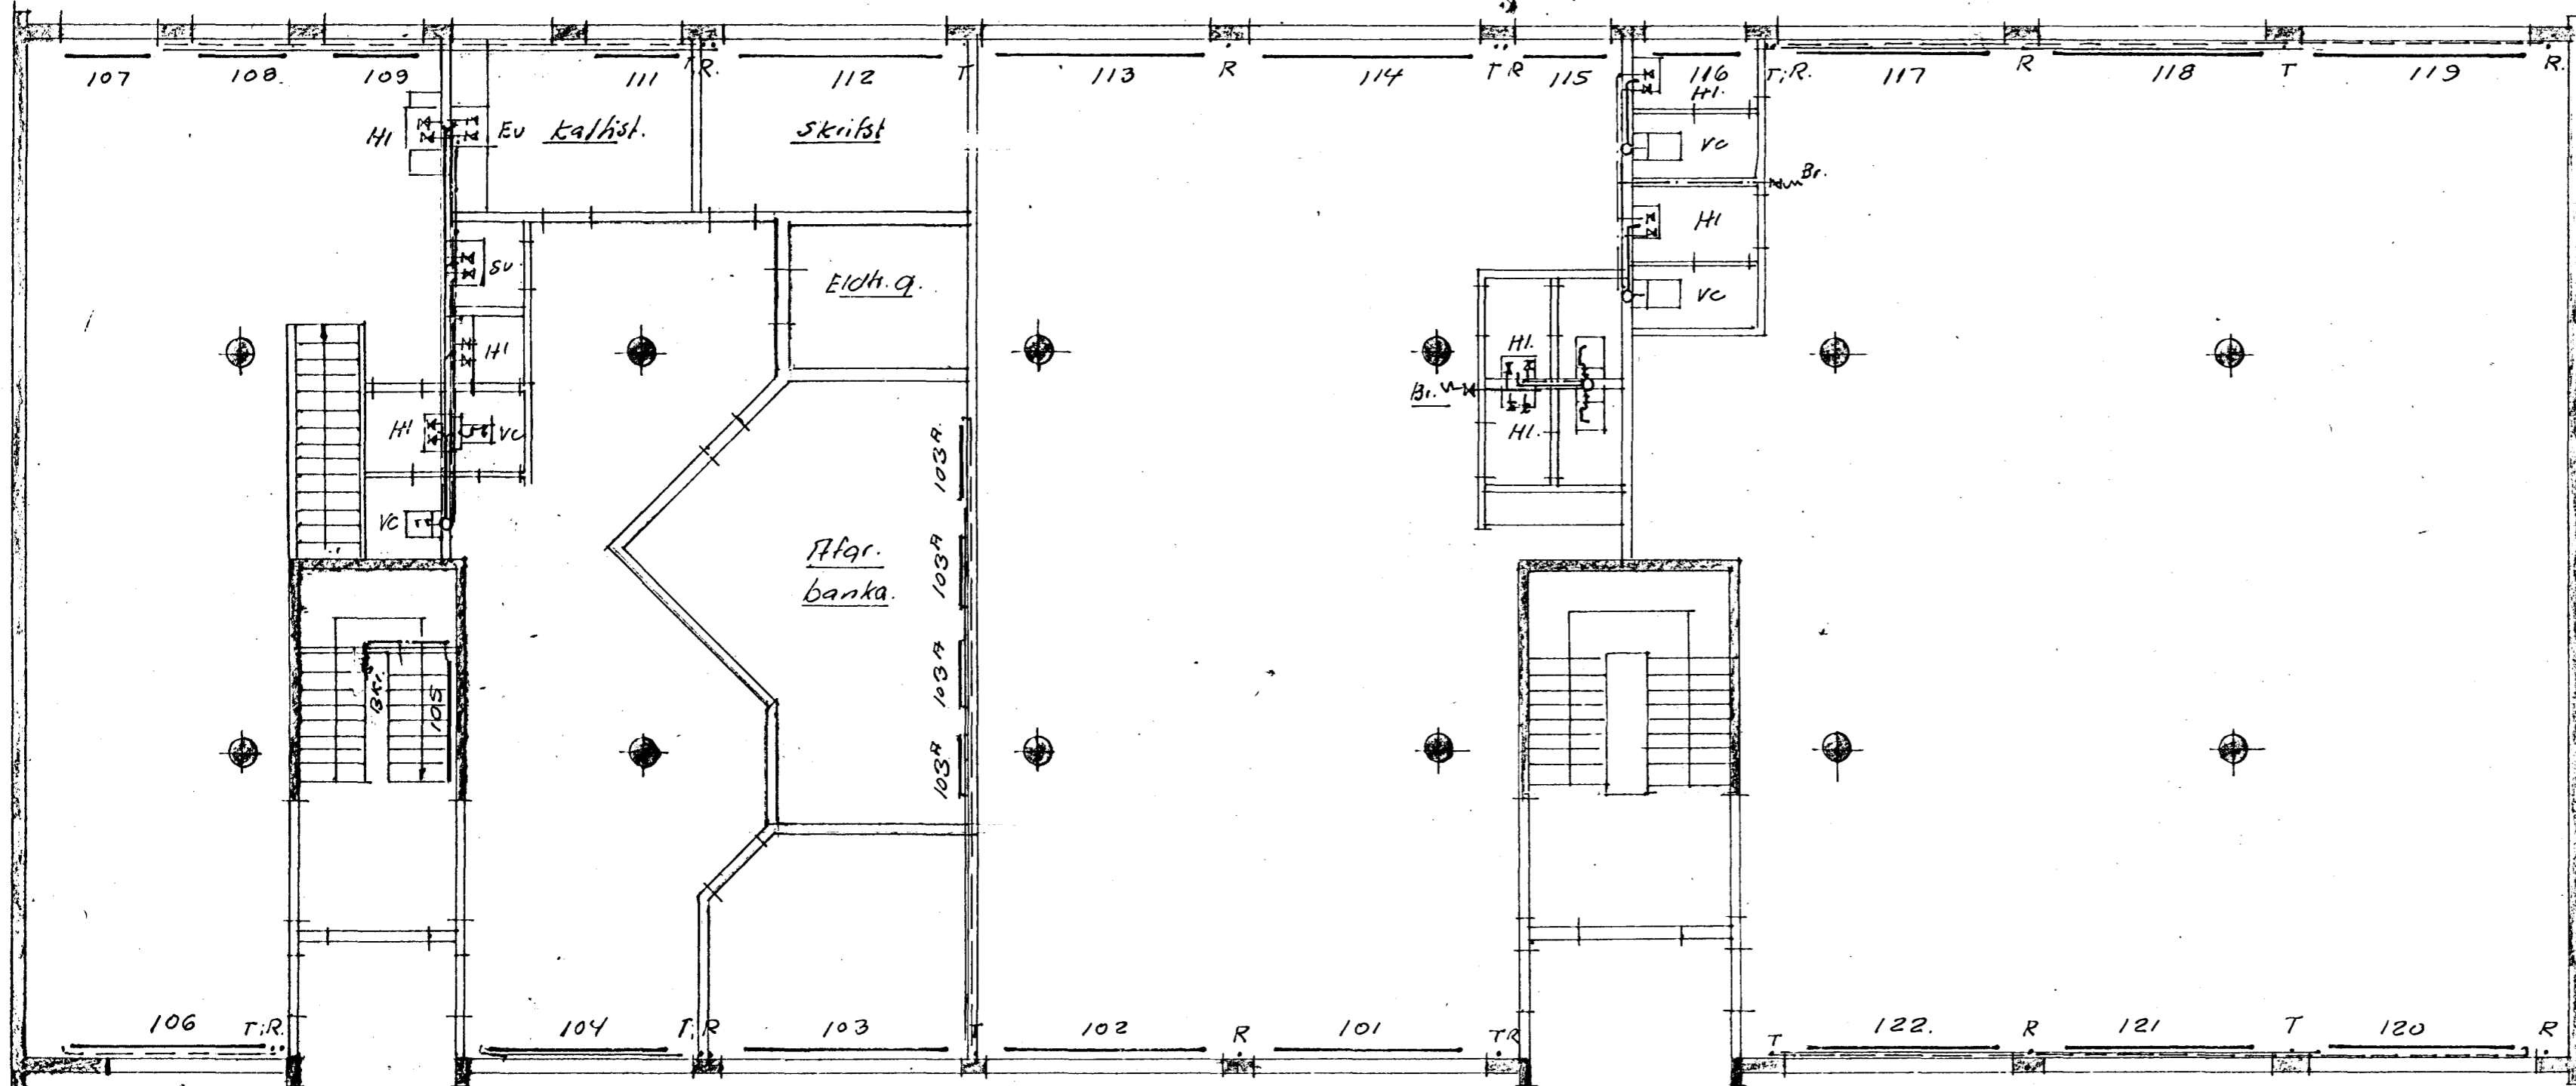

Breyting nov 78.
Otrunum 103^A bætt við.
Ofni nr. 110 sleppt.
Bætt við og breytt vöskum
og salernum.

Benedikt B. Sigrúðsson vefdr.		
Reykjavíkuvægur 66, Hf.		
M.	1/100	Hita-vöms-skulplögn
D.	mai 78	Staðs. teikja í hæðar.
Nr.	2. bl.	Otraskrá.
Bun. B. Sigrúðsson vefdr.		