

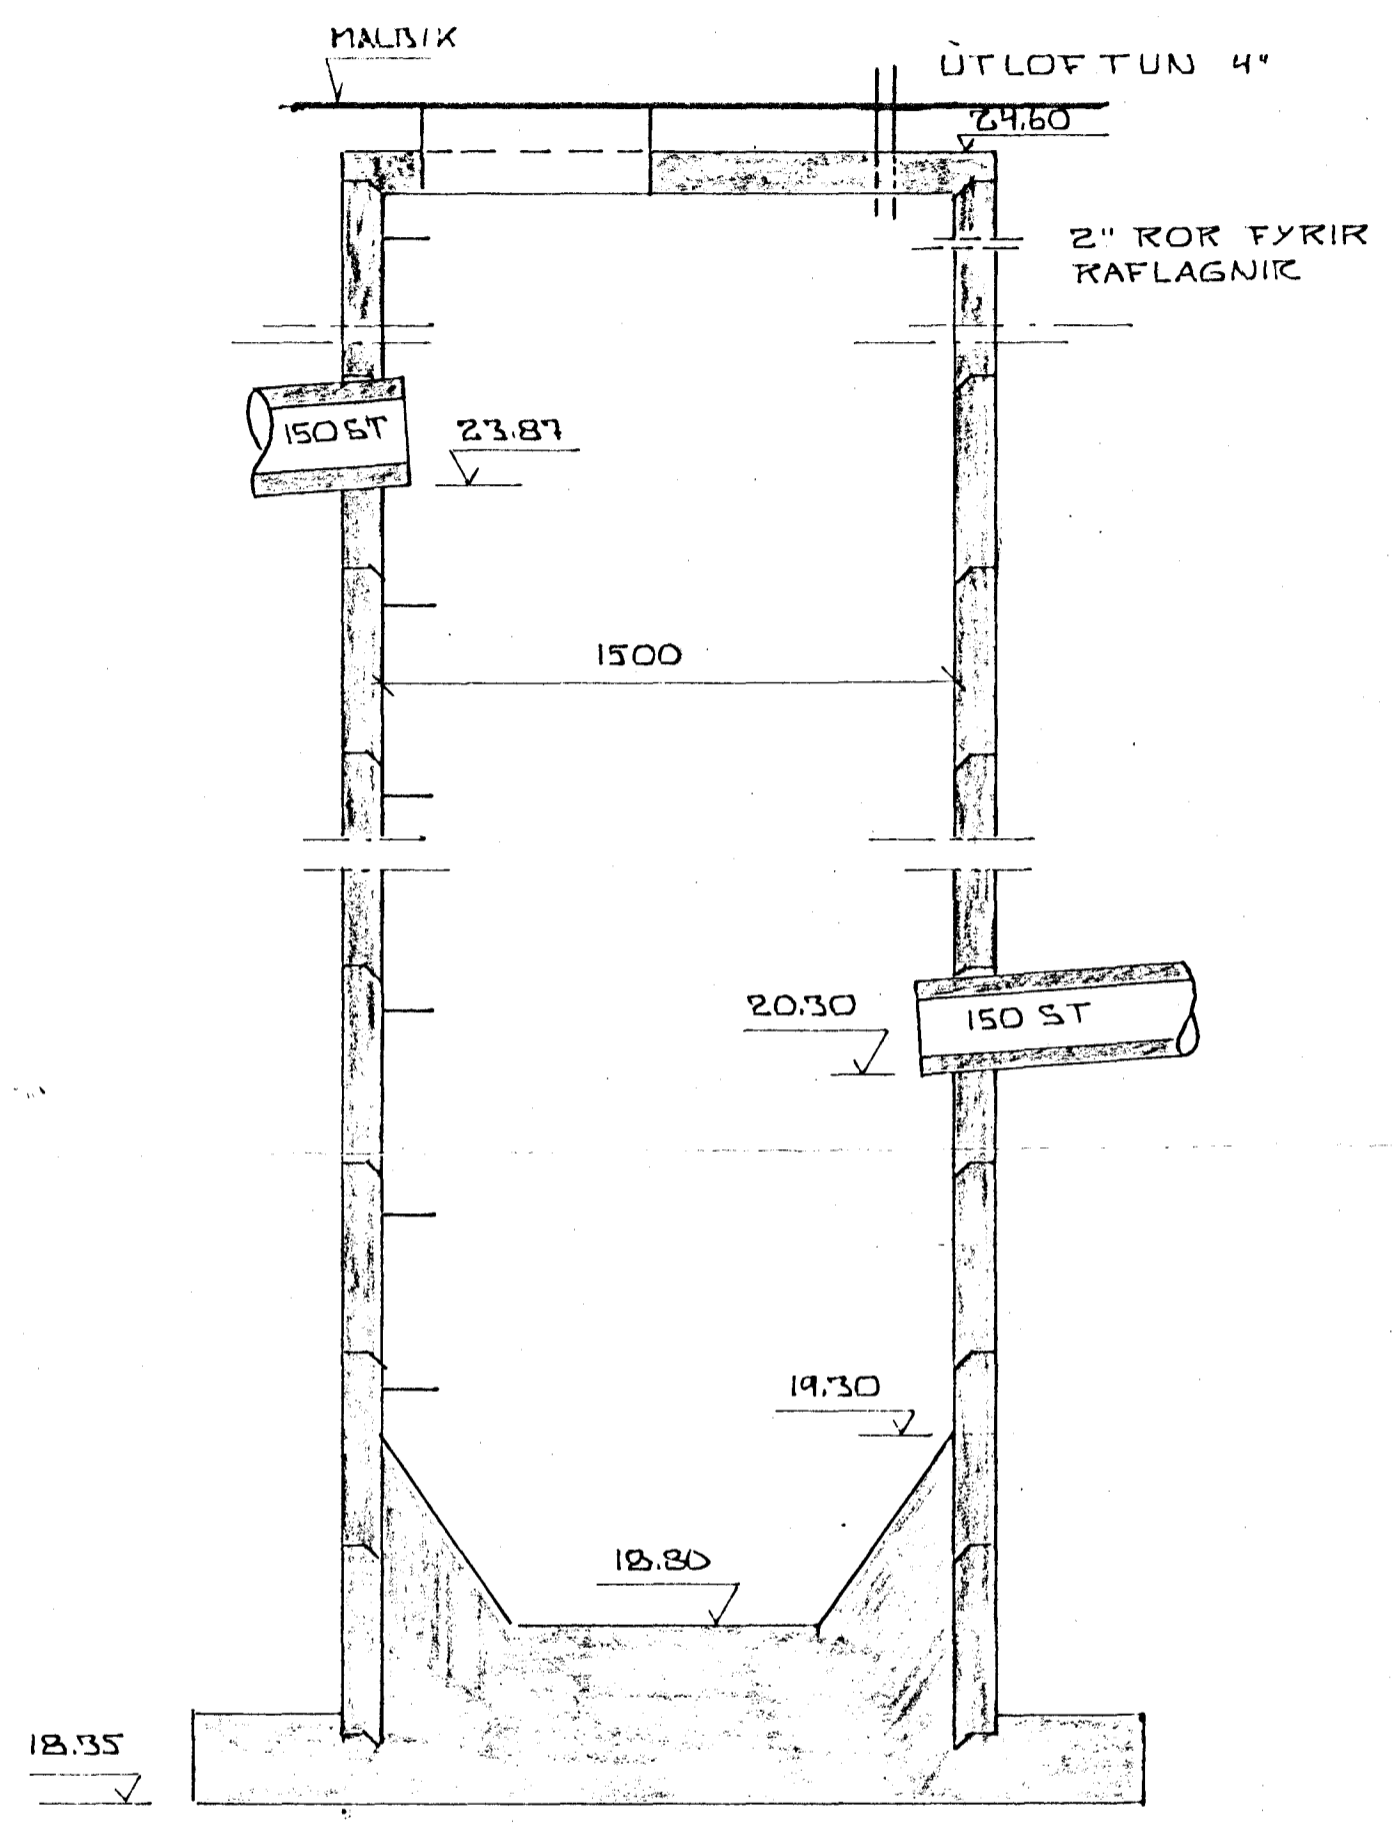



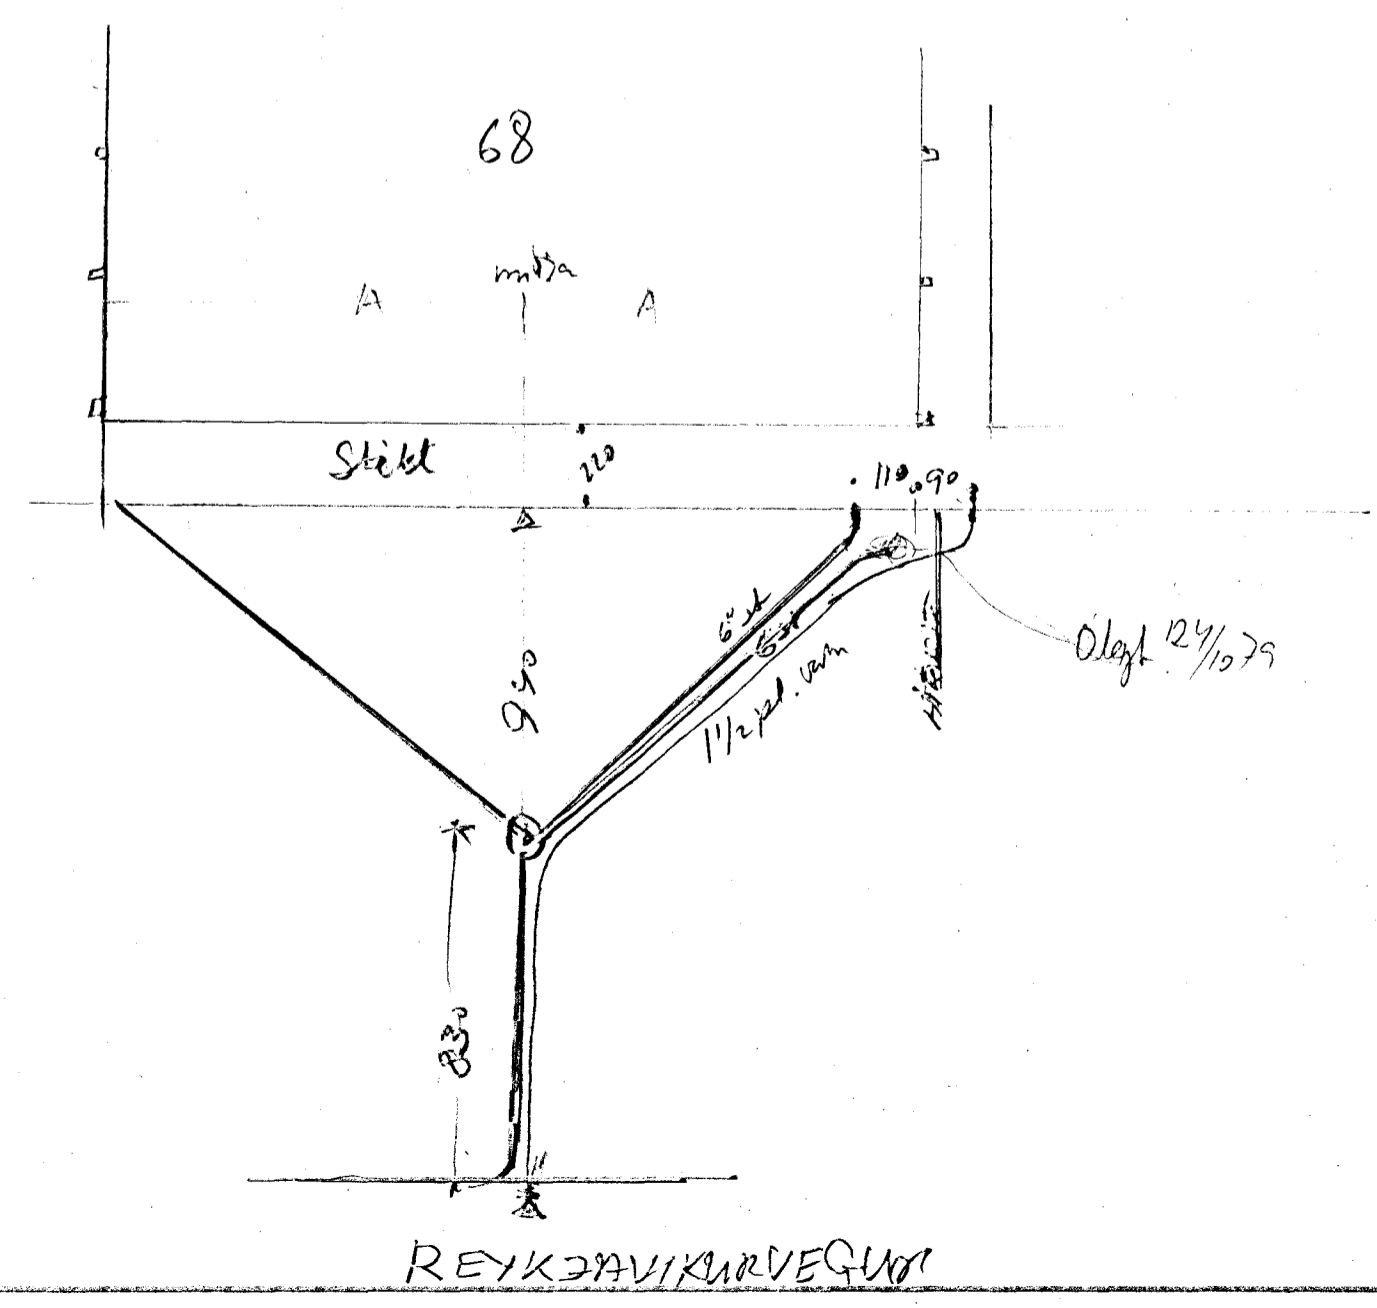


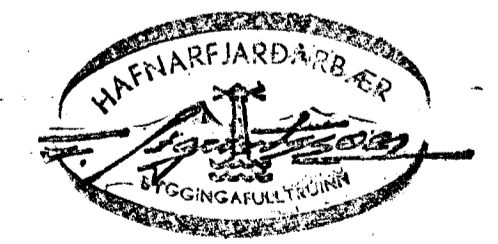

REYKJAVÍKURVEGUR 68	MÆLIKVARDI	VERK	TEIKN NR
AFSTÖÐUMYND OG SERMYND AF DÆLUSTR	Hanna <i>Sp</i> Teikna <i>Sp</i>	Yfirfari <i>Sp</i> Samb:	DAGS 79.09.10
JÓHANN GUNNAR BERGPÓRSSON VERKFR MVFI STRANDGÖTU 11 - HAFNARFIRÐI - Sími 53315	BREYTT		