
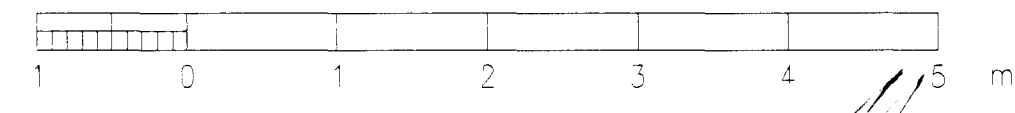
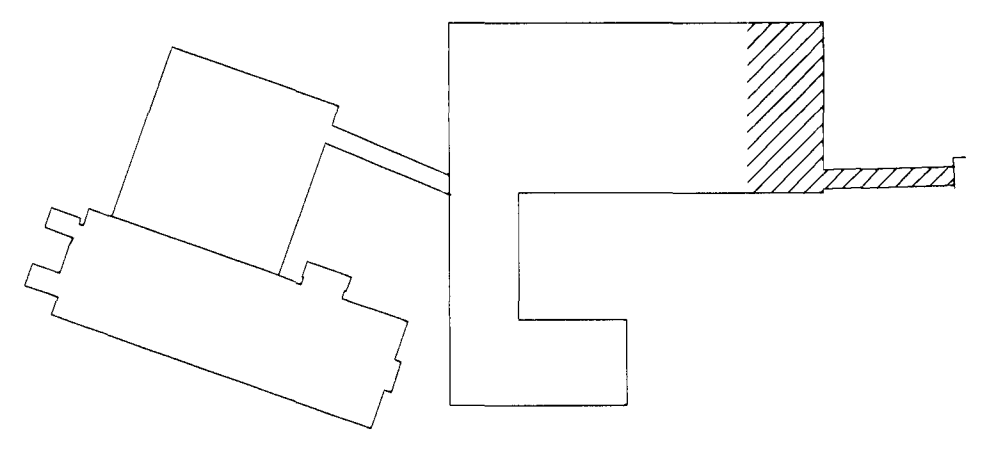
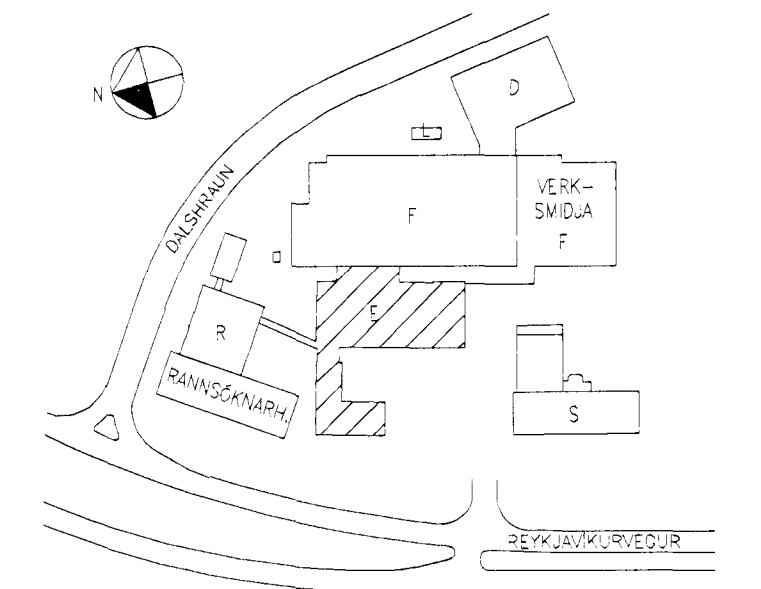


1 2 3 4 5 6 7 8 9 10 11 12

Mottaef 11.01.11

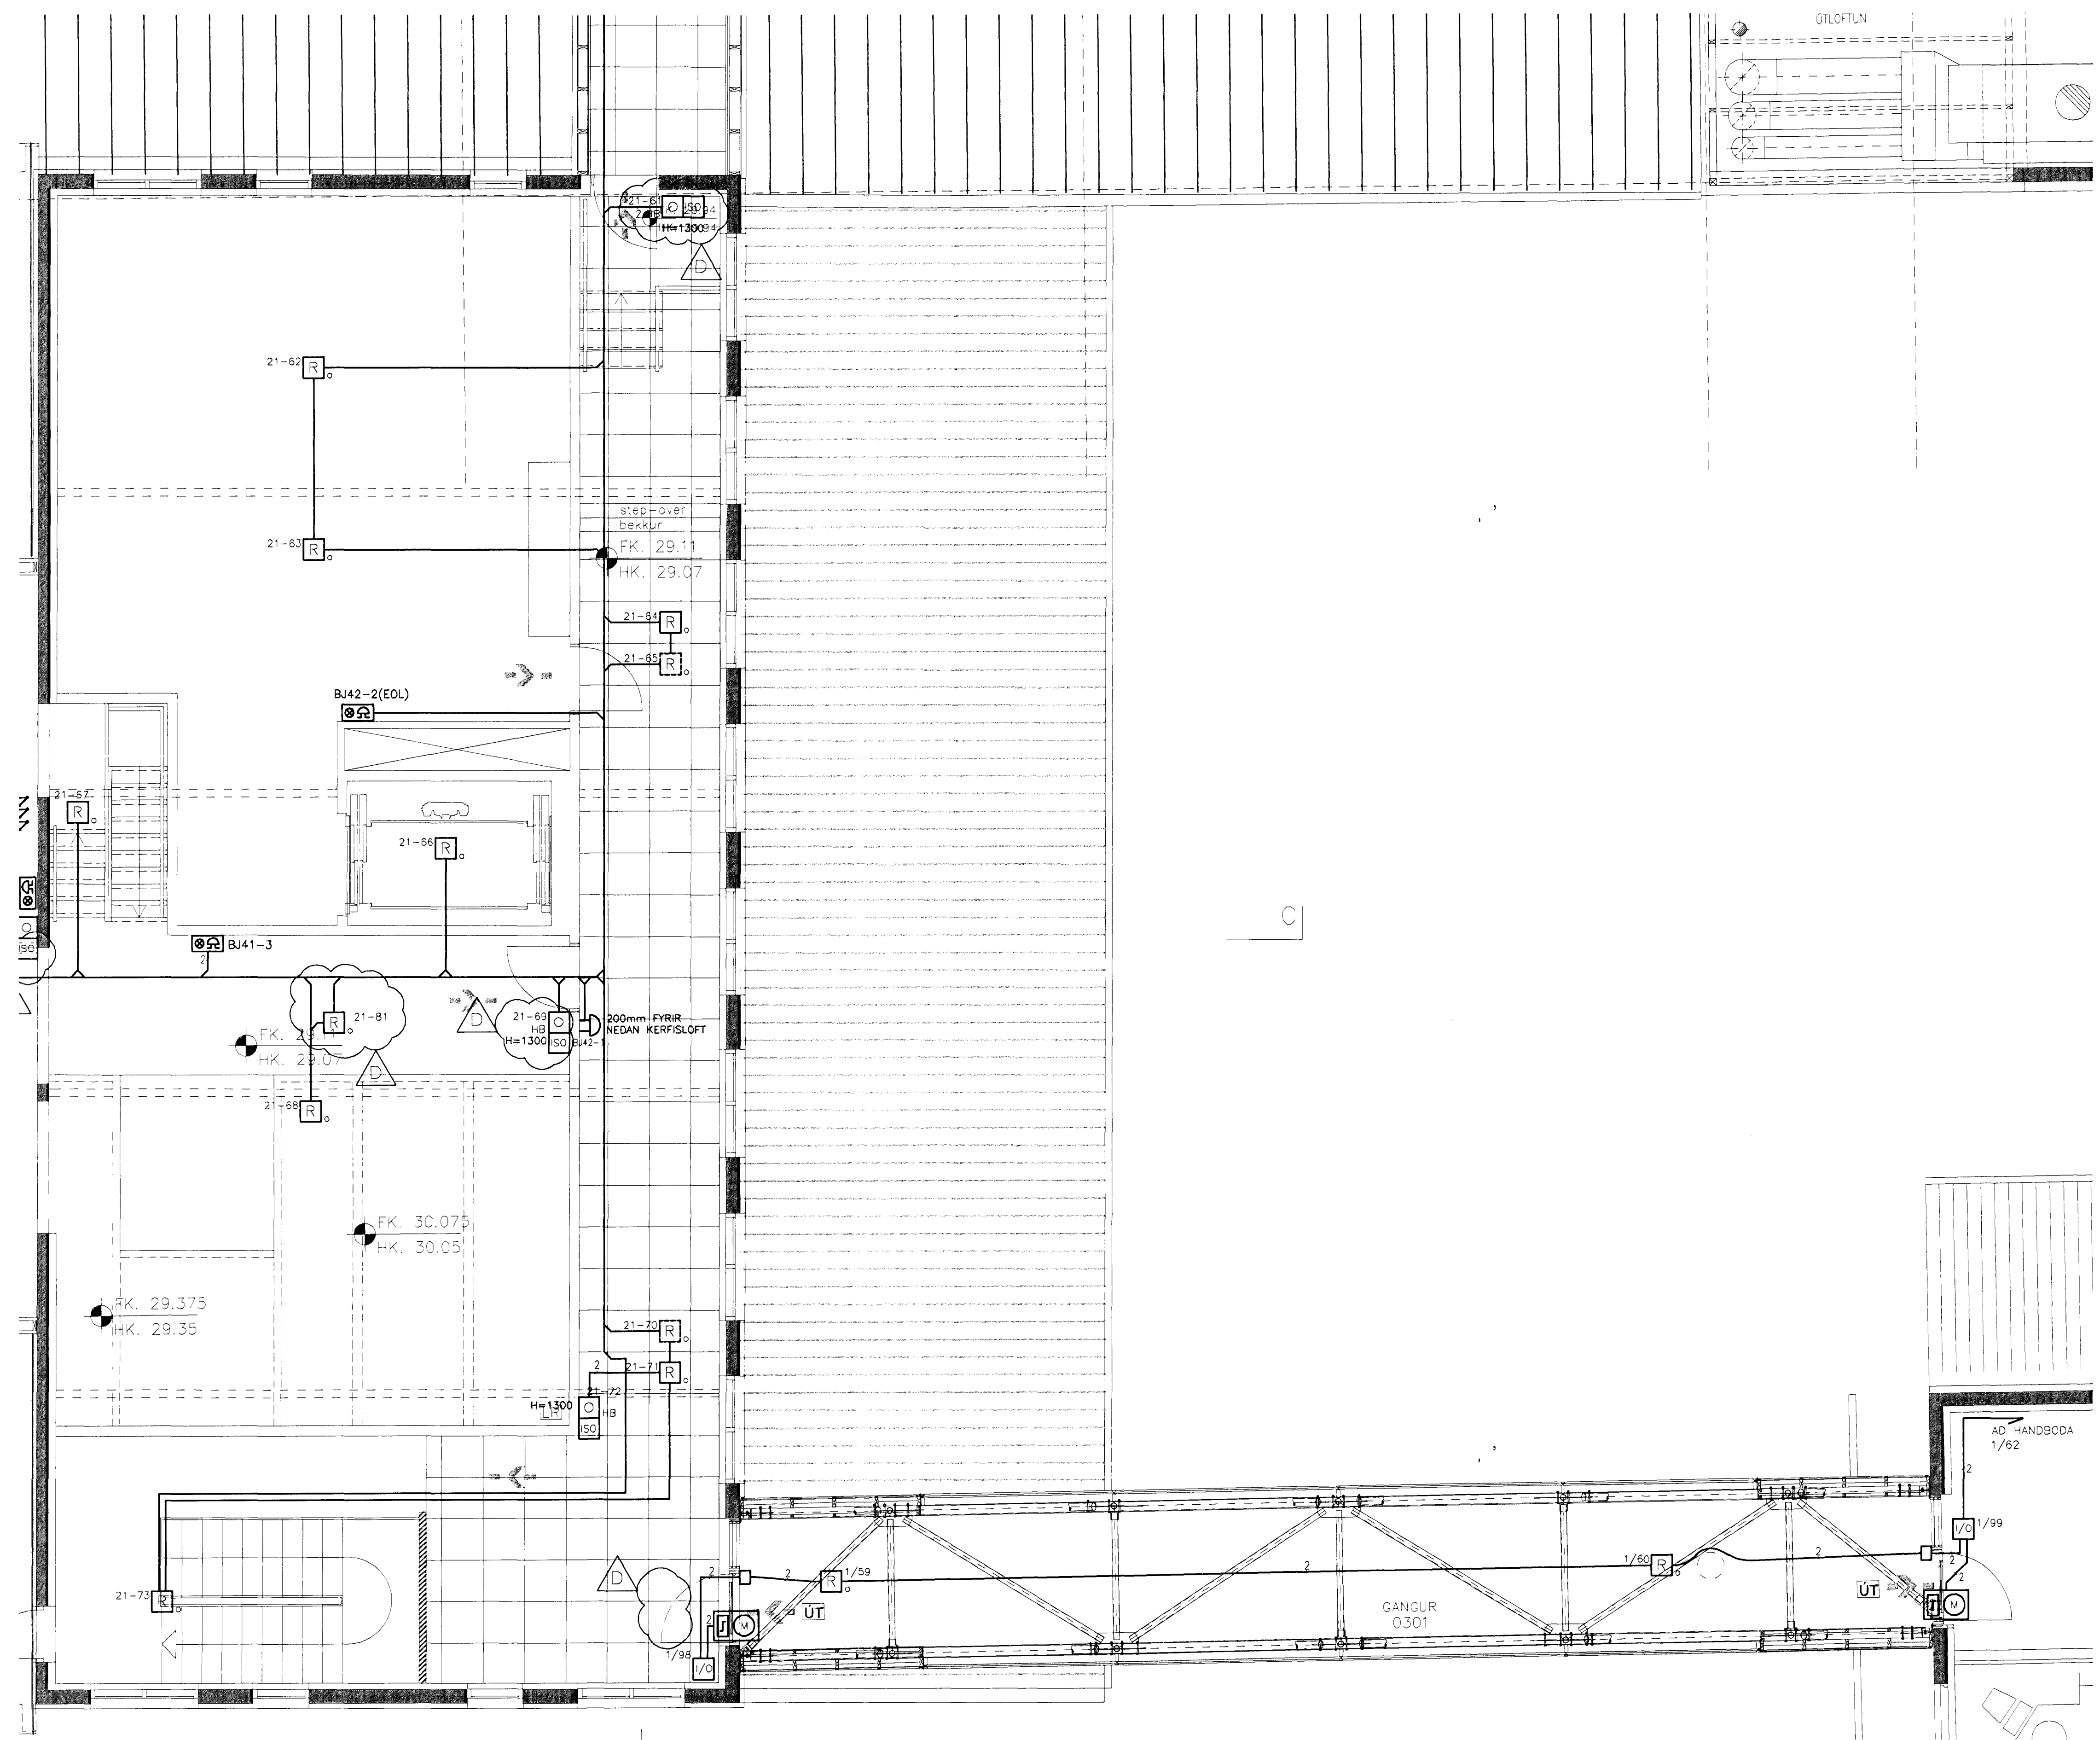

		SAMÞYKKT: <i>Þorgerður Þorsteinsdóttir</i> D 2010-12-20 SKAMMHLAUPSEIN. LMO BIS TH EKP C 2010-09-29 NÚMERING KERFIS RÓJ BIS TH EKP	REYKJAVÍKURVEGUR 78, HFJ. 2. HÆÐ, E-HÚS BRUNAVIÐVÖRUNARKERFI GRUNNTEIKNING =64
		06.04.10 VERKTEIKNING RÓJ BIS KEG HG	FLOKKUN BLAD
REFERENCE IS1E-E64-02.01D	www.verkis.is - sími: +354 422 8000	ÚTG DAGS SKÝRINGAR TEIK HANN RÝNT SAMÞ	VERKFANG 97001 TEIKNING 64.5.E201 D

© Öll rétt og afritun teikningar, að hluta eða í heild er höfð skriflegu leyfi höfundar