

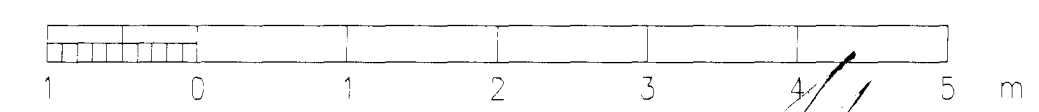
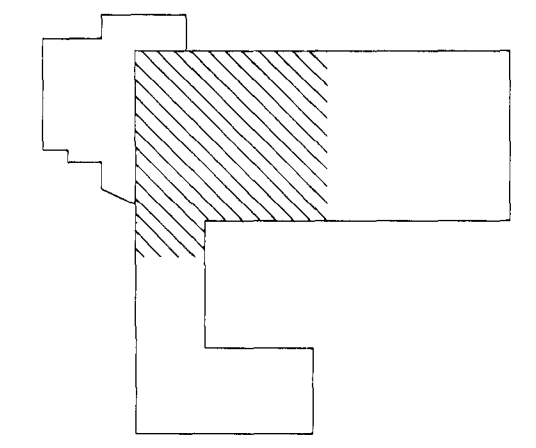


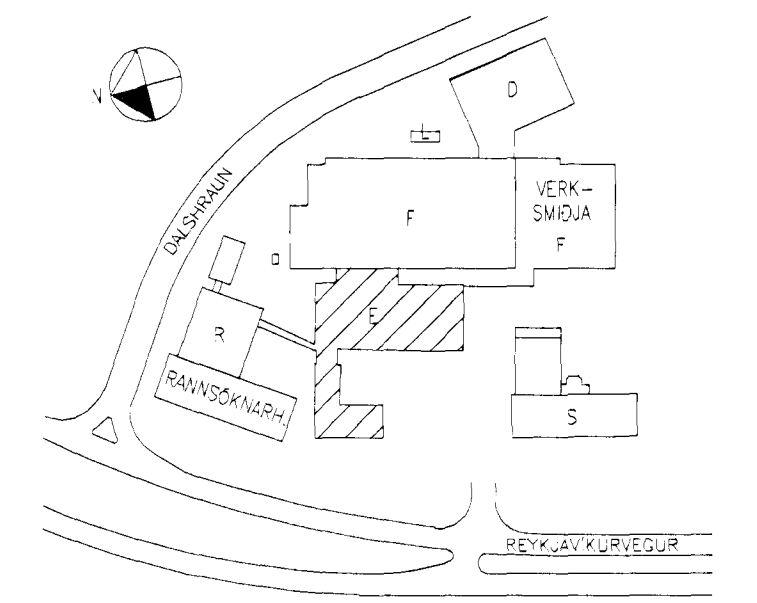

Mottaed 11.01.11

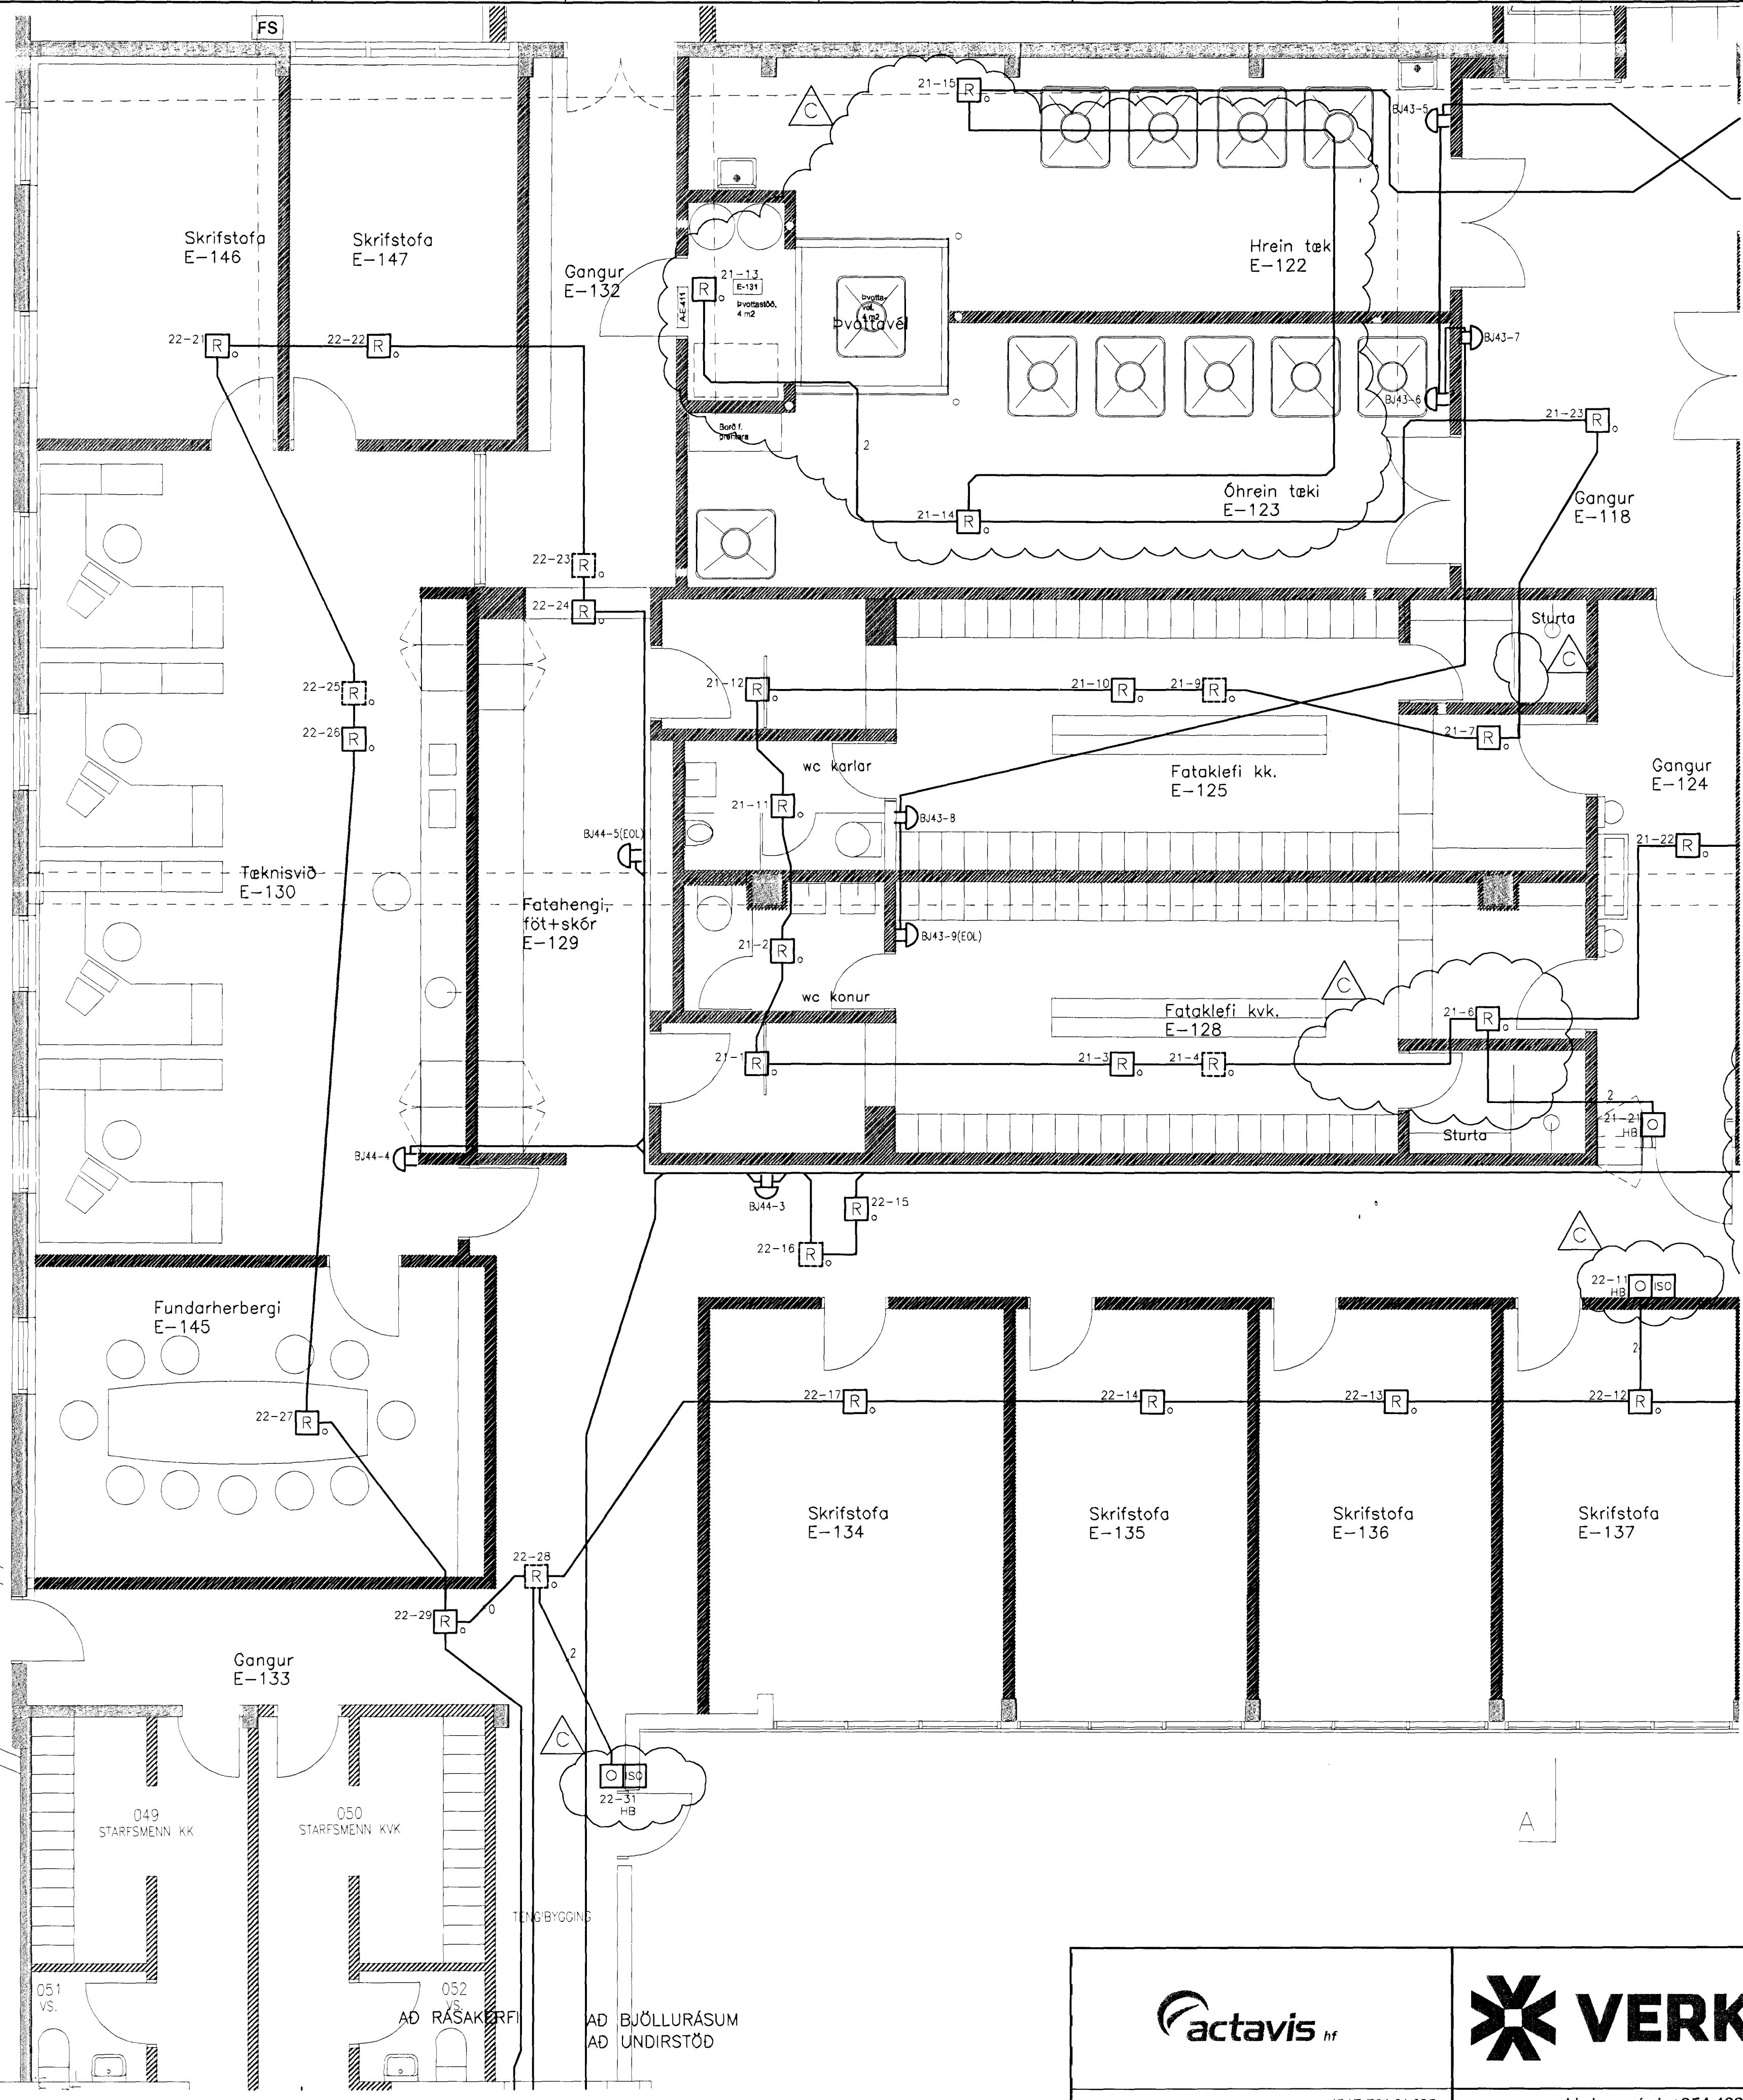

		SAMÞYKKT: <i>Þórunn Þórunn 130607-5895</i>	REYKJAVÍKURVEGUR 78, HFJ. 1. HÆÐ, E-HÚS BRUNAVIÐVÖRUNARKERFI GRUNNTEIKNING =64
		B 2010-09-29 NÚMÉRING KERFIS RÓJ BIS TH EKP C 2010-12-20 SKAMMHLAUPSEIN, LMO BIS TH EKP 2010-06-18 VERKTEIKNING RÓJ BIS ÞGH EKP	FLOKKUN BLAD
REFERENCE IS1E-E64-01.02C	www.verkis.is - sími: +354 422 8000	ÚTG DAGS SKÝRINGAR TEIK HANN RÝNT SAMÞ	VERKFANG 97001 TEIKNING 64.5.E102 C

© Öf strot og ofritun teikninga; að hluta eða í heild er hæð skilfraga leyfi höfundar