

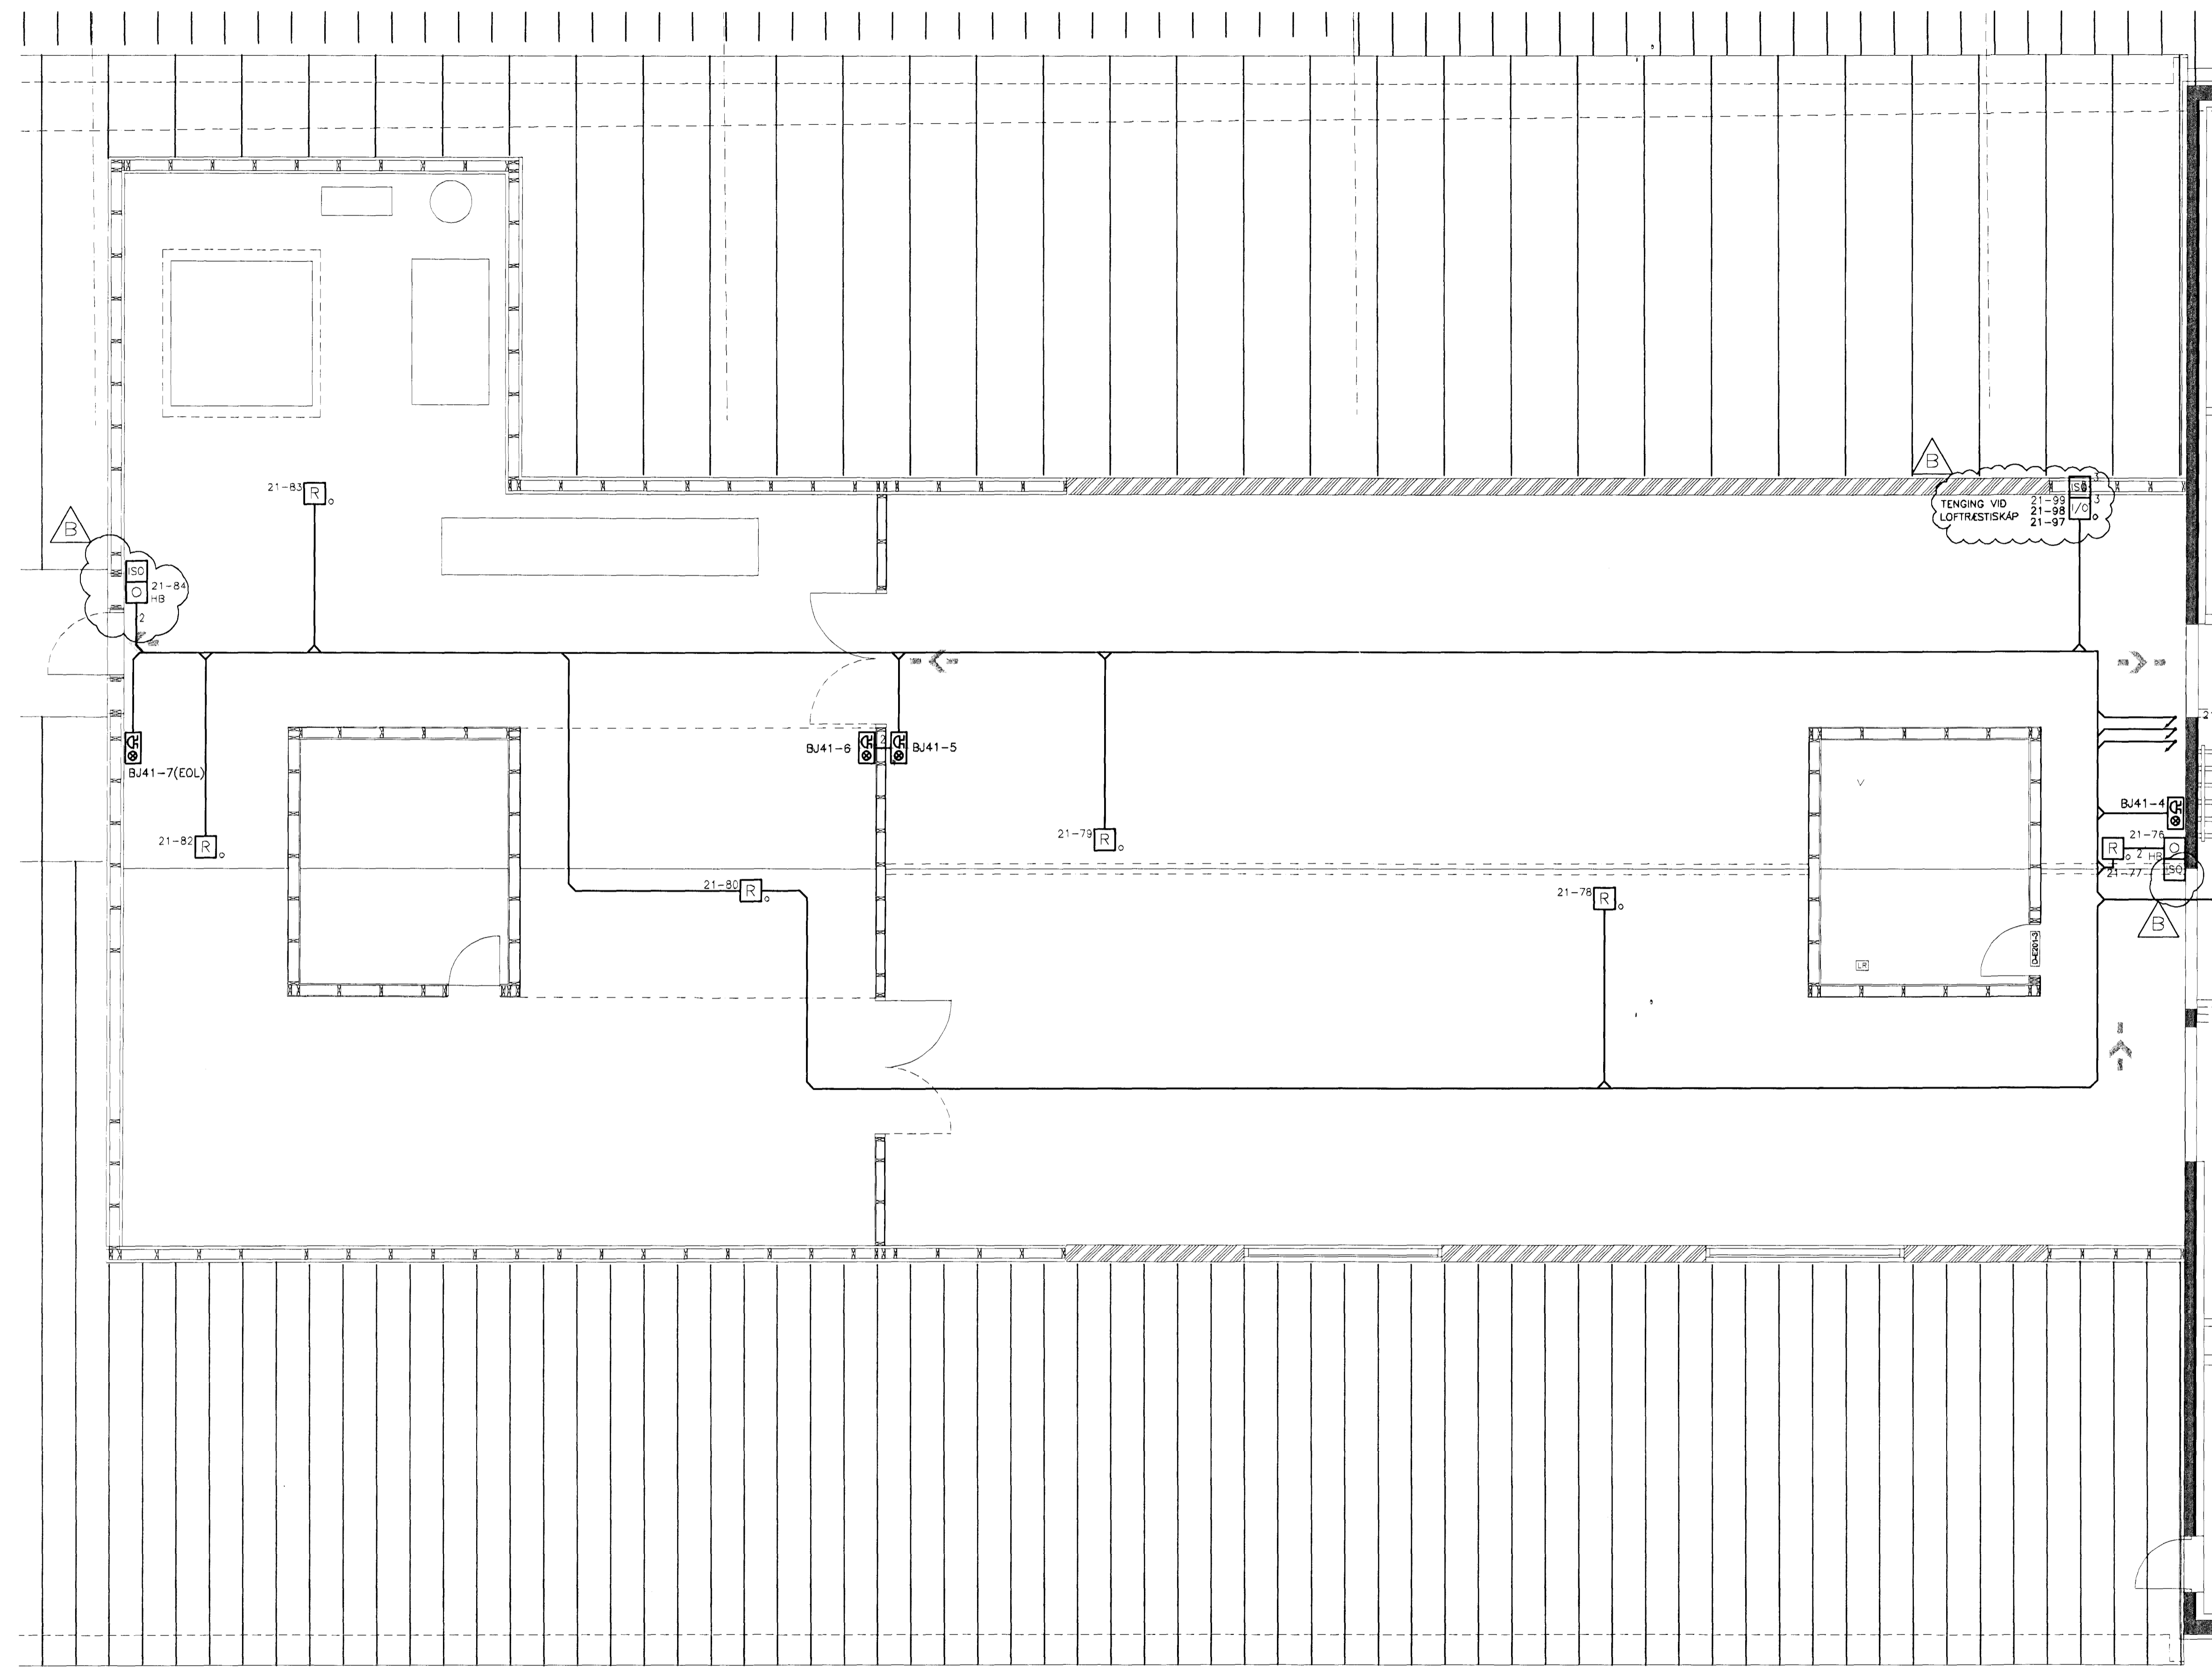


Motteld 11.01.11 *J*

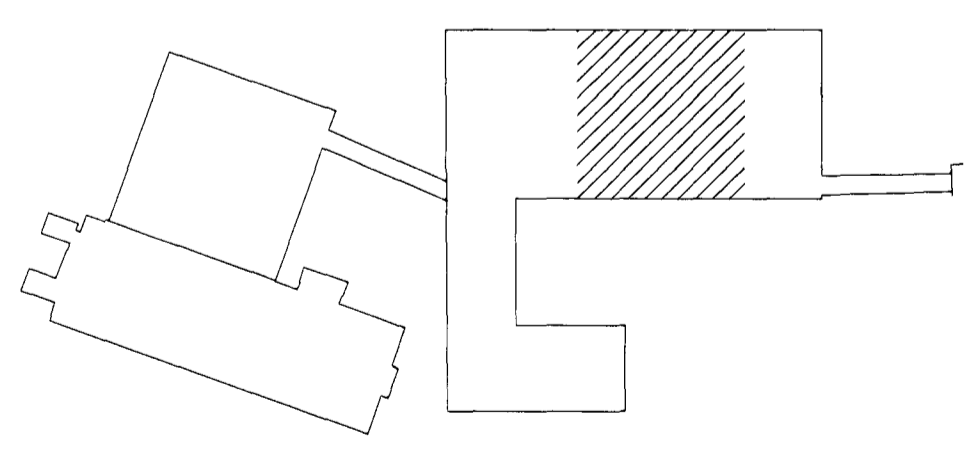

TENING VID
LOFTRÆSTISKAP
21-98
21-99
21-97

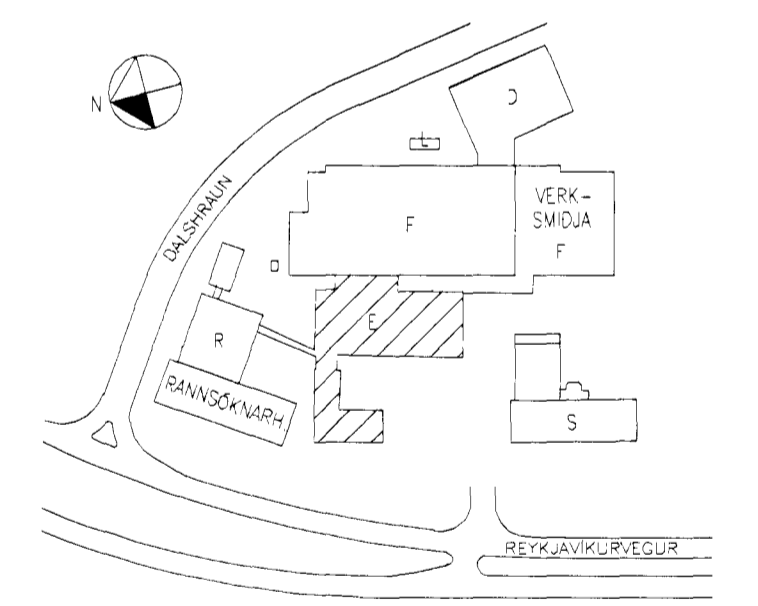

0 2 3 4 5 m



SAMÞYKKT
B 2010-12-20 SKAMMHLAUPSEIN LMO BIS TH EKP
A 2010-09-29 NÚMERING KERFIS RÖJ BIS TH EKP
2010-06-18 VERKTEIKNING RÖJ BIS ÞGH EKP

REYKJAVÍKURVEGUR 78, HFJ.
2. HÆÐ, E-HÚS
BRUNAVÍÐVÖRUNARKERFI
GRUNNTEIKNING
=64
FLOKKUN BLAD

REFERENCE IS1E-E64-02.02B www.verkis.is - sími: +354 422 8000 UTG DAGS SKÝRINGAR TEIK HANN RÝNT SAMP VERKFRANG 97001 TEIKNING 64.5.E202 B

© Öll útfær og öflun teikningar, að hluta eða í heild er höfð skriflega leyfi höfundar