


SKÝRINGAR:

- HANDVIRK LOFTAFTÖPPUN KEMUR Á ALLA HÁPUNKTA.
- VATNSAFTÖPPUN KEMUR Á ALLA LÁGPUNKTA.

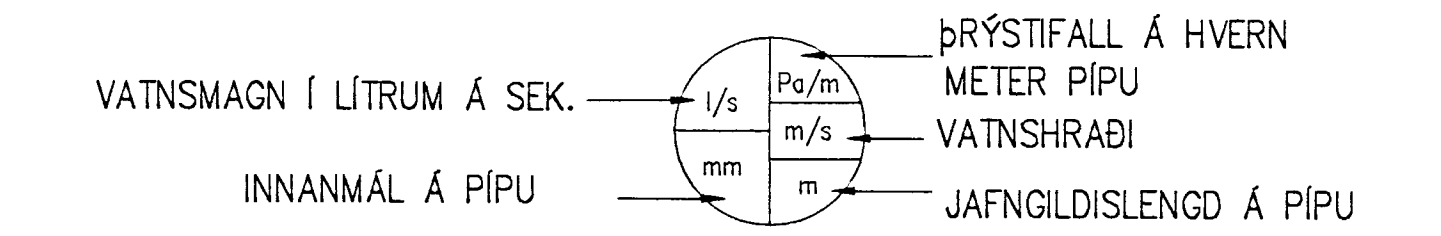

- SÉRMYNDIR AF PÍPULÖGN Í INNTAKSKLEFA, SJÁ NÁNAR Á TEIKNINGU NR. G0258A/M14/1/089

D-15	TEIKNING TÝFARINN A STADNAM OG LEIÐRETT	02/11/98
C-15	TEIKNING TENGINGU AD HILTA OG SETT INN NERNI FORSJA EHF BRUNAVATNI BETT VIB BANTAK KALDAVATNS.	23/02/98
TENDER ISSUE		
C	PROCESS COOLING WATER RETURN FLOW PIPED TO SOAKAWAY PIT ISSUED FOR TENDER MP41.3.	13/11/97
B	GEOHERMAL HOT WATER FLOW RATES REVISED. TITLE CHANGED TO DIAGRAMMATIC. PROCESS COOLING WATER RETURN ADDED.	17/10/97
A	FIRST ISSUE FOR INFORMATION	02/07/97
Rev	Description	Date

ENGINEER / ARCHITECT	PROJECT DESIGN / DRAUGHTSMAN	DESIGN COORDINATOR	PROJECT MANAGER
Drawing Created by LB on 25/06/97		CAD by KH/SB Plotted	

TANVEC
 Tanshire House, Shottelwood Road, Epsom, Surrey GU8 6LB UK
 Telephone: +44 (0)1252 703683 Fax: +44 (0)1252 703684

Client	DELTA HF ASKILIB, ELDFRÍ ICELAND TEIKNING OG IÐ
Project	NY LYFJAVERKSHEIÐIA Bygginguáttíni Háttarurbarðir
Drawing Title	INNTAKSKLEFI: SKEMATISK TENGMYND

FORSJÁ
 VERKFRÆBISTOFA FRV
 SÍÐLAUGARÖSTI 1, REYKJAVÍK
 SM: 552 4099 06: 552 4710, FAX: 552 4310
 NETING: forsja@centrum.is

CAD File	M038D-is	Scale	N.T.S.
Drawing No.	G0258A/M14/6/038D-is		

THIS IS A COMPUTER PRODUCED DRAWING DO NOT AMEND BY HAND