




7

8

9

10

11

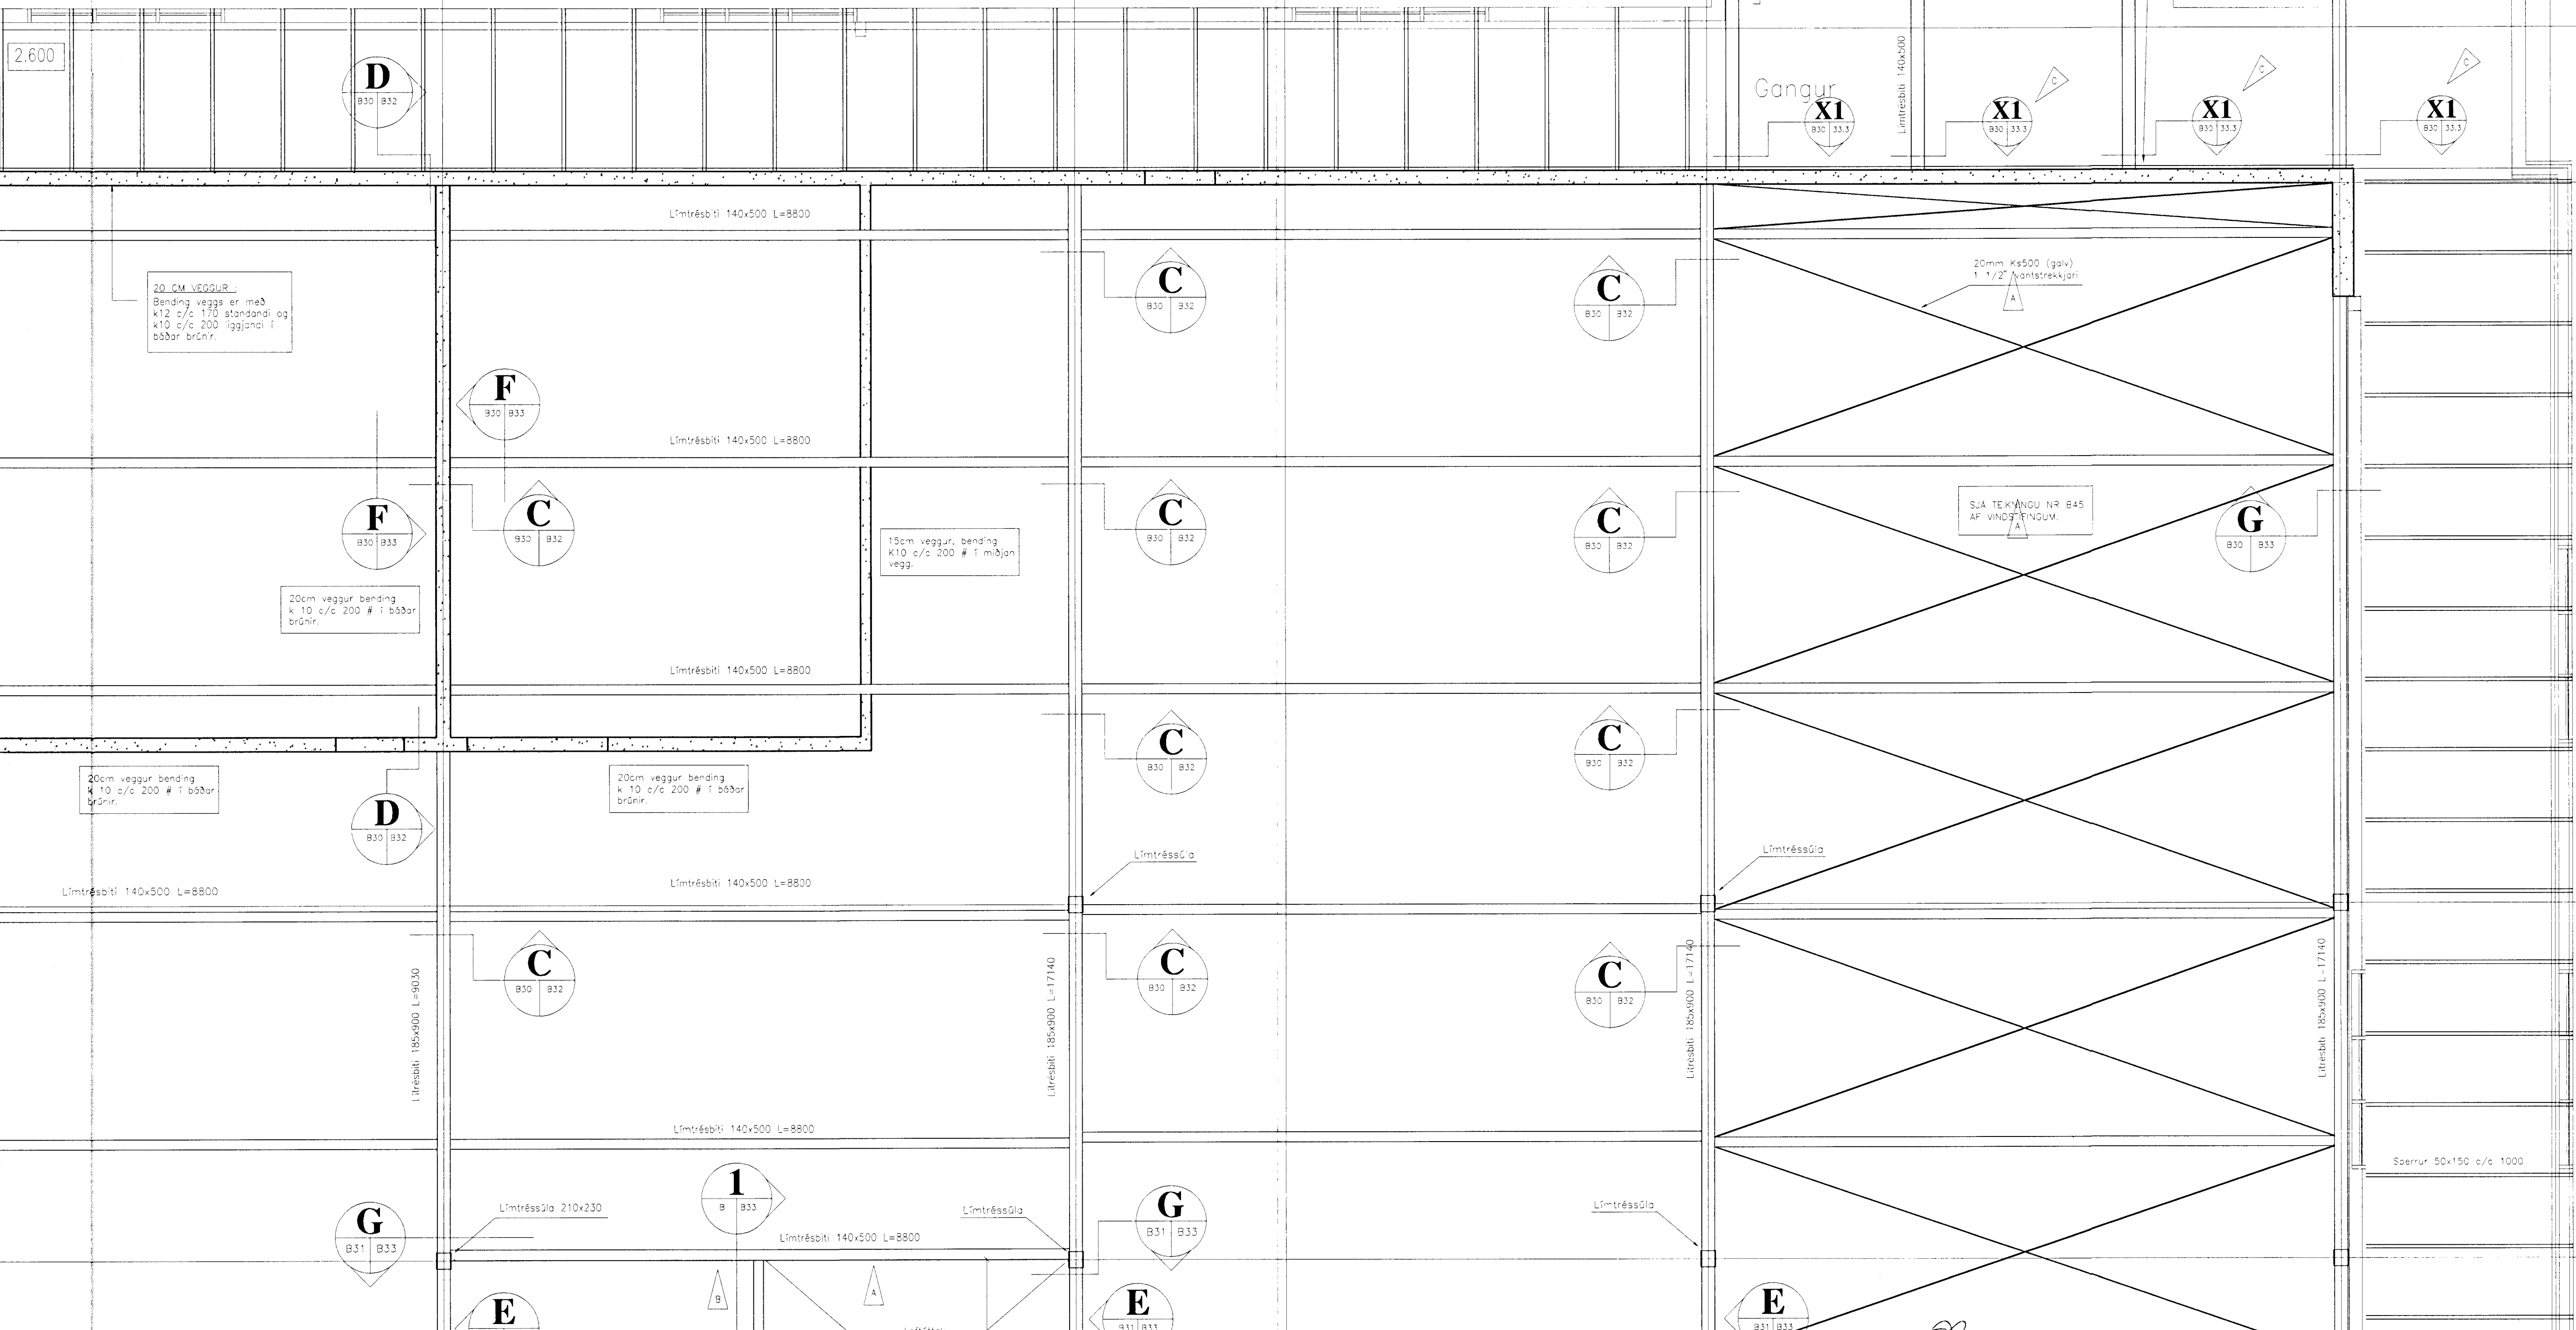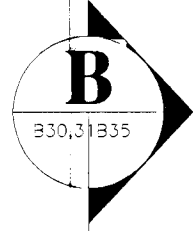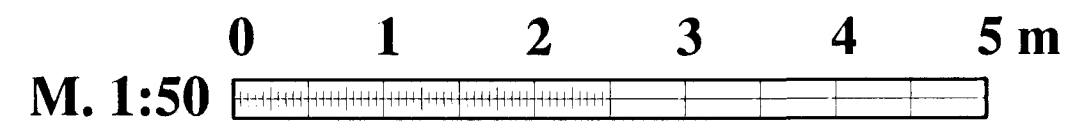

A

B

C

D

ÁSKILID, ELDRI
TEIKNING OGILD
Bygginguáhrifni Hafnarfjarðar
Alþjóttúni
13. APRIL 1998
Sigrúnar Erlendur Þórunnsson

VERB
Verkfræðistofa Erlenda Björgssonar
Laugaveg 168-105 Reykjavík
Sími/Fax 561-6461, 853-5991
Netfang web@breknet.is

Límtréssúla 140x500 L=8800
A Breytt 22/8/97
B Breytt 22/8/97
C Breytt 19/12/97

Sambýkt.

Delta hf. Reykjavíkurvegi 78 H
Planmynd þakvirki

H.E.B.
T.H.G.
M. 1:50
D. Mars 97

B30

839 THAKPLAN