


SNID D-D

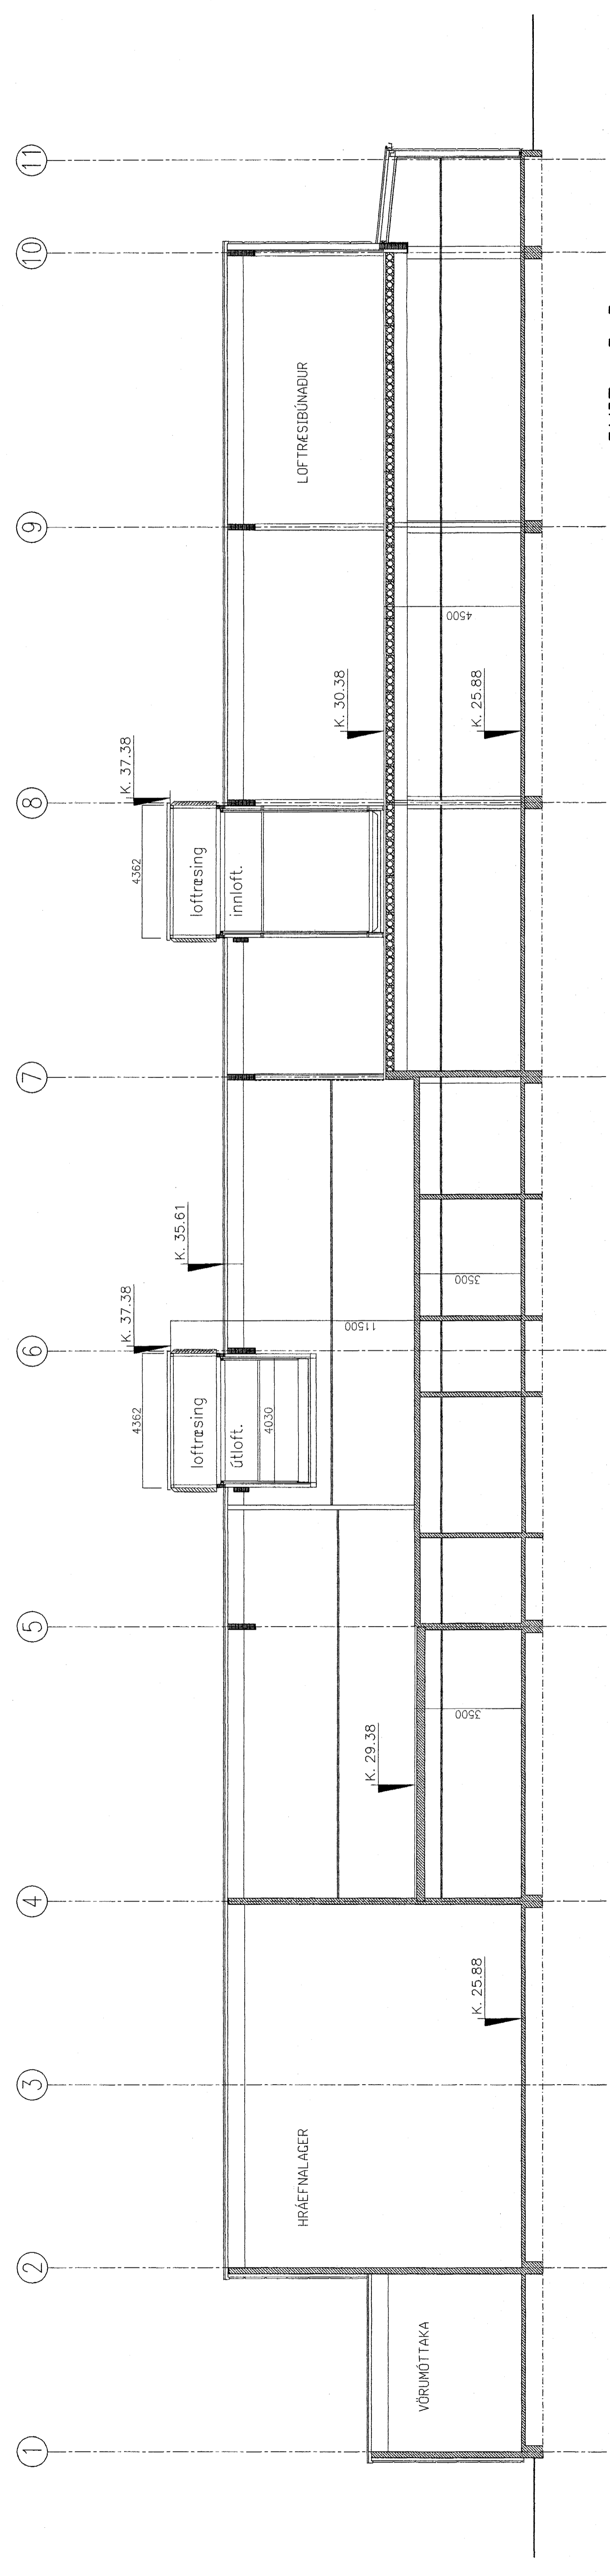

SNID C-C

Endesk. 26.10.99. Aftönn yfirferð í verklok

Verk: Dala hl. Reykjavíkureyri 78 hl
Heiti: **SNIBYNDUR**

H.N.G./G.S.Ó
M. 1.000
T. G.S.Ó/H.L.G.
D. 14.03.97
Nr.: A.005

NG
Njörug. Gerðis. Arkitekt Fél.
Göngu- og Hagkerfi
Gunnar. S. Guðmundsson
Símar: 551-7888 og 551-7895
Fax: 551-7889

Horsteinn Guðvaldsson