


VESTURHLID

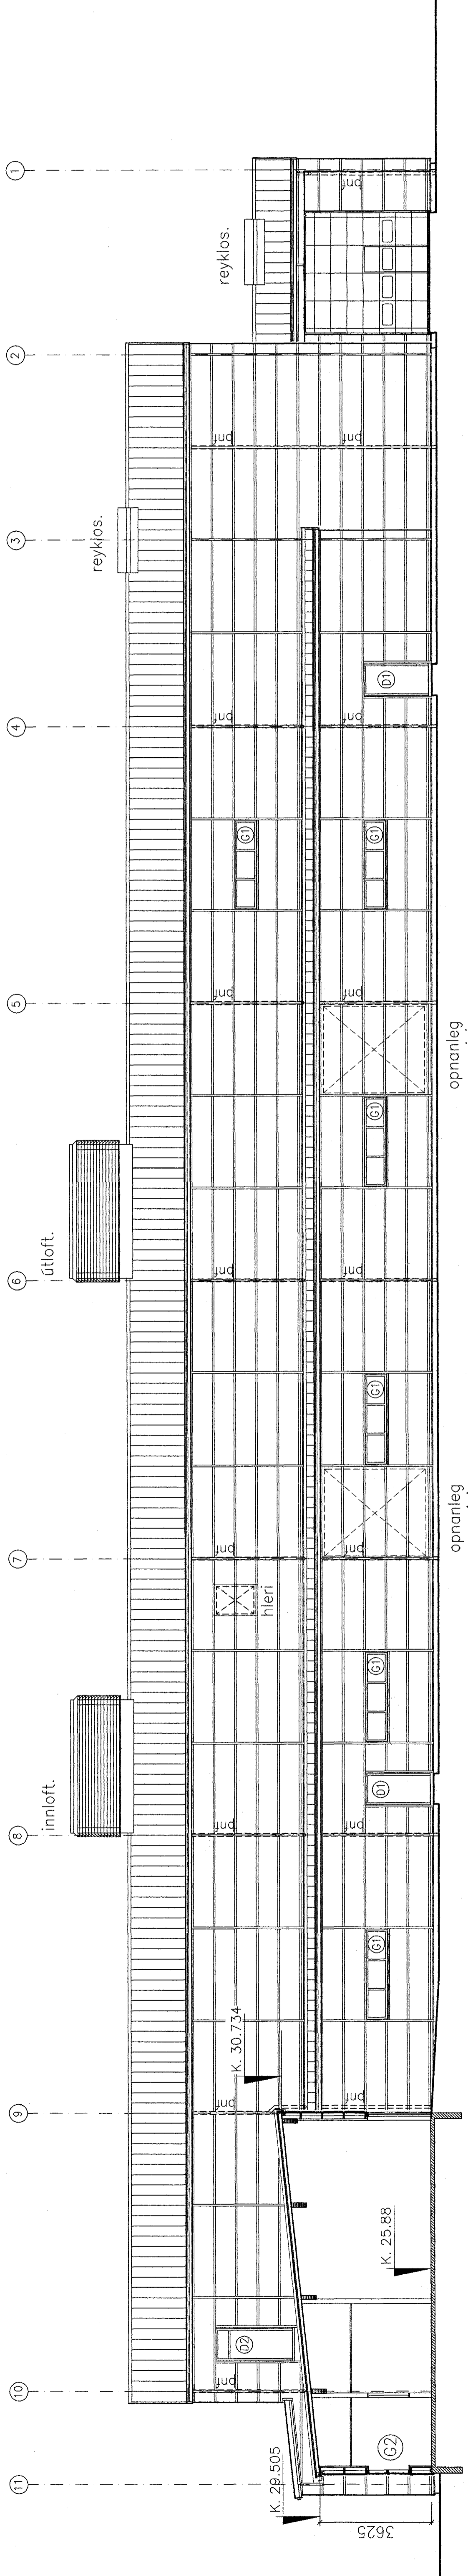

AUSTURHLID

Endurséð 26.10.98 Almenn yfirlit og í verklok

Verk: Deila hf. Reyjavíkurveg 78 H
Heiti: ÚTUSMYNDIR
AUSTUR VESTUR

H. N.G./G.S. T. G.S.Ó/H.G.
M 1:100 D. 14.03.97 Nr.: A006

NG
Nýbúur Gerdal Architects FAI
Gunnar S. Óskarsson Architects FAI
Stjórn 15, 105 Reykjavík
Símar: 551-7880 og 551-7885
Fax: 551-7889

Guðrun Guðmundsdóttir