



GRUNNMYND  
1:100

SHS  
01. feb. 2023  
BRUNAHÖNNUN  
20

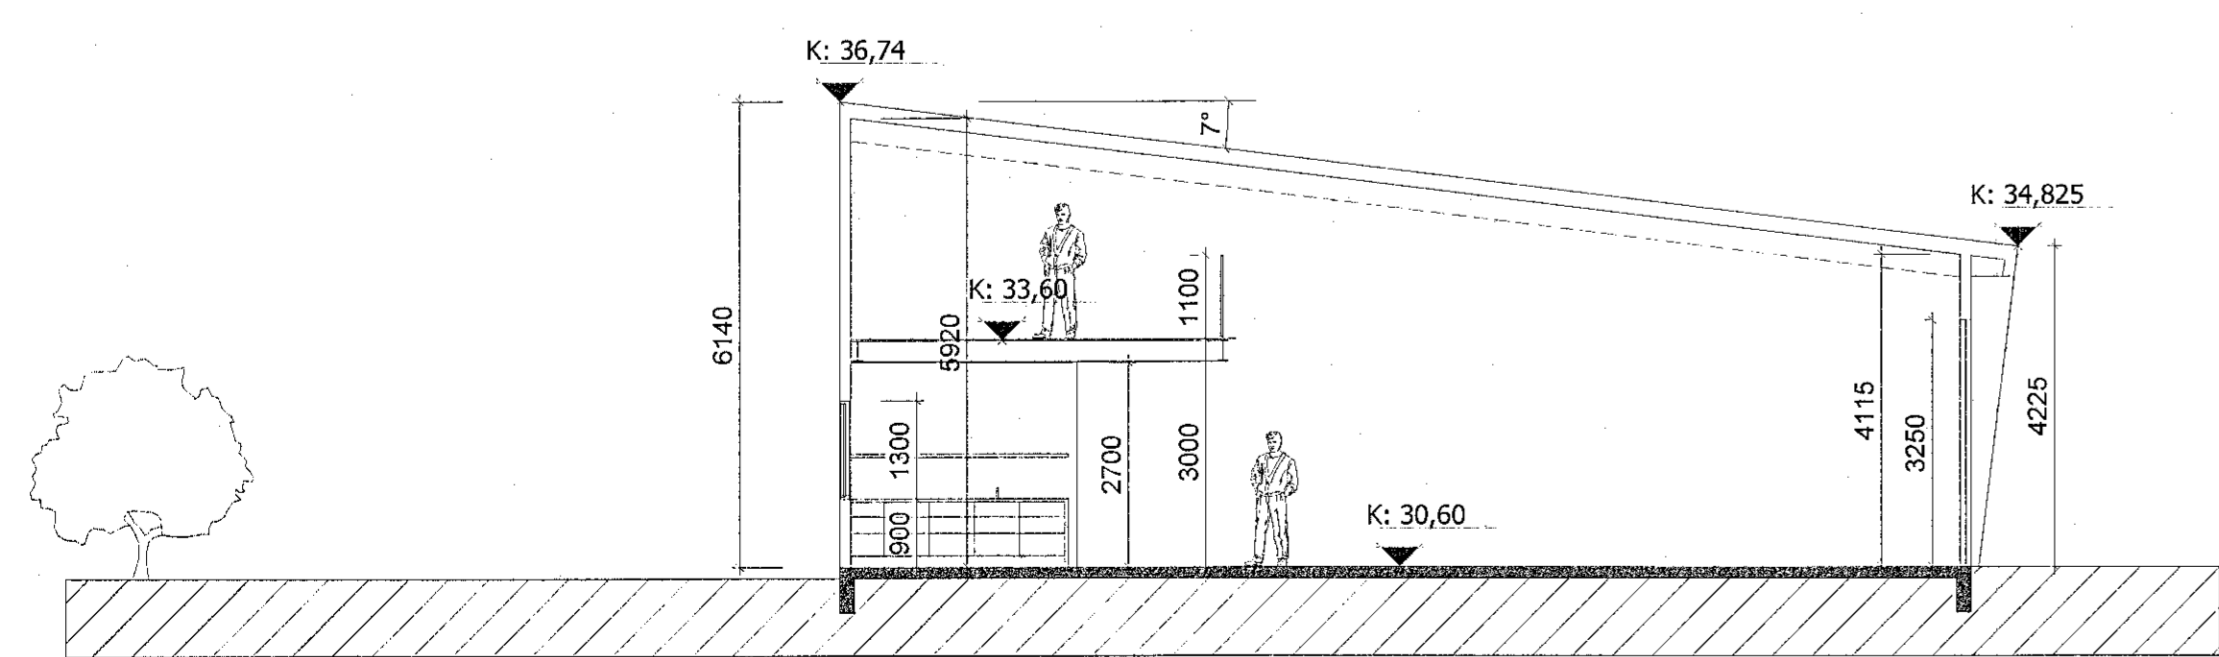

SNEIÐING X-X  
1:100

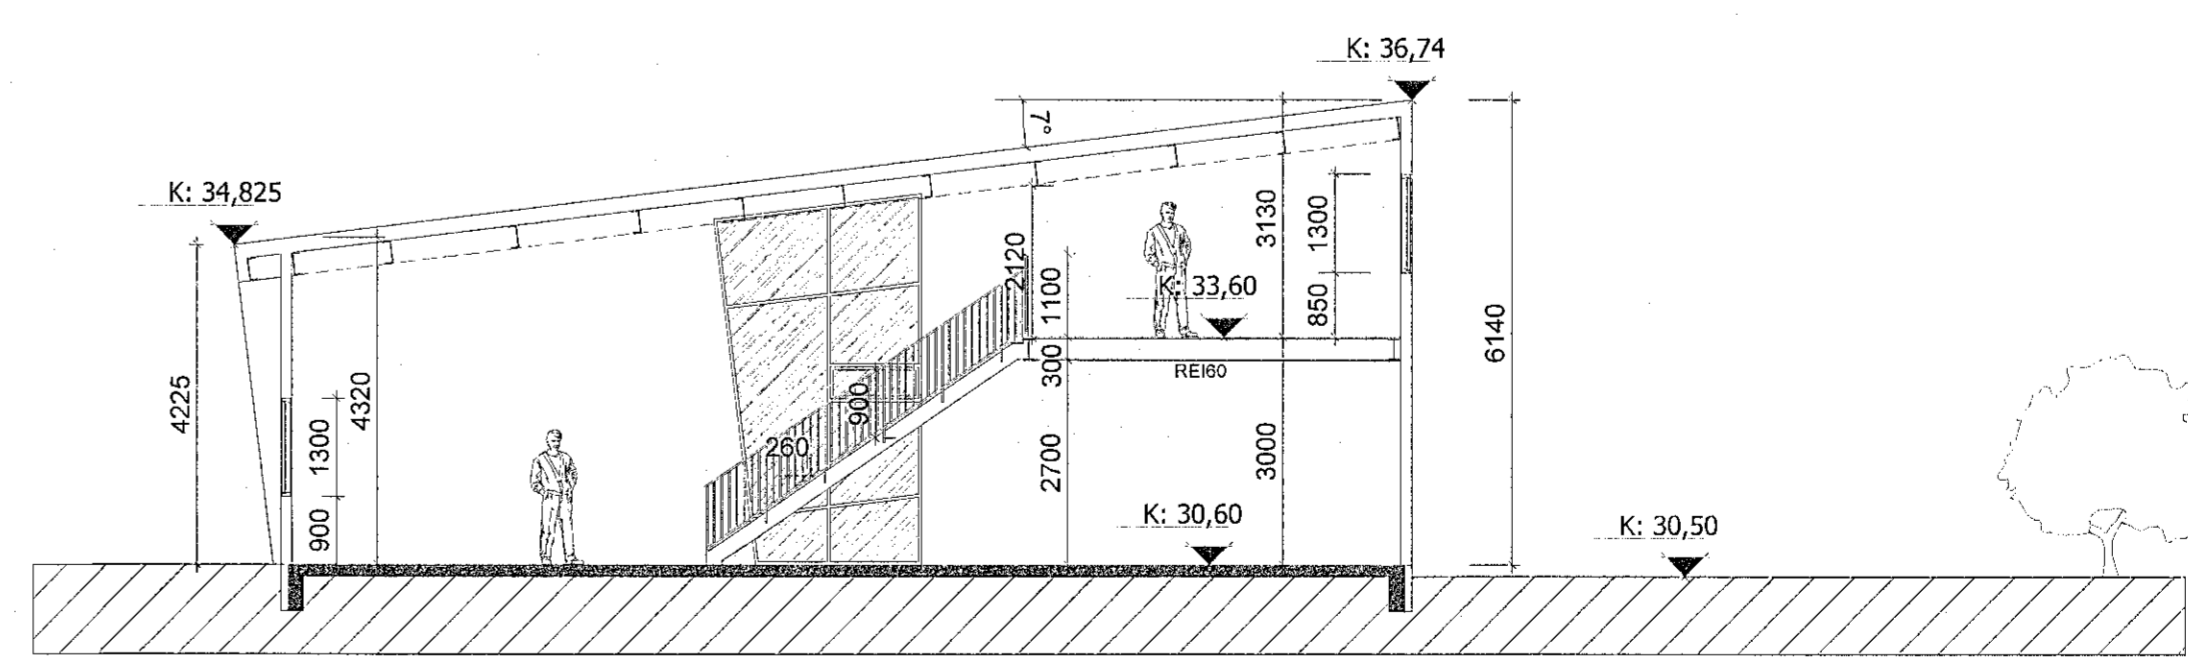

SNEIÐING Y-Y  
1:100

NR.	DAGS.	BREYTING	SH
01	07.01.2023	bætt við geymslu loftum	
02	07.01.2023	brunamerkingar teknar af sörggæmslu	
03	07.01.2023	númerakerfi teikninga breytilt	

K.J. ARK. slf 650319-0360  
TEL: 899-3234  
E-MAIL: hjartan@honnun.is  
E-MAIL: jon@honnun.is

HÖNNUN - SKIPULAG - RÁÐGJÖF  
KJARTAN RAFFINSSON FRIÐSA 270365-3539  
JÓN M. HALLDÓRSSON BYGGINGAÐR. 091162-3509

VERK  
BORGARHELLA 7 - MHL 02  
HAFNARFJÖRÐUR

TEIKNING  
GRUNNMYND GEYMSLULOFT  
OG SNEIÐINGAR

KVARDI  
1:100 A1

DAGS. 07.01.2023  
TEIKNAD AF KR, JMH  
TEIKNING NR. 10-07