
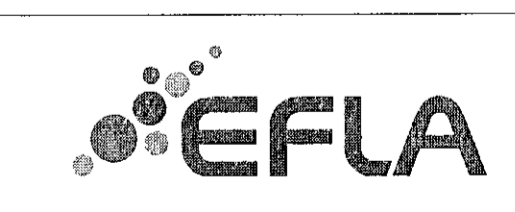
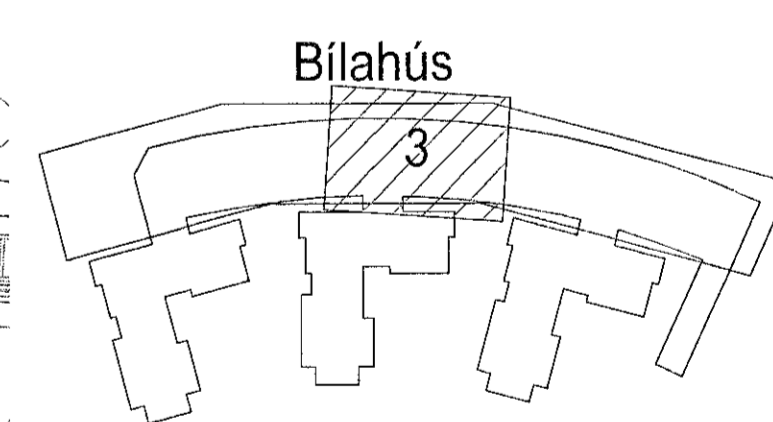


Vísab. 3.2.2023 11:43:20 Úprunin: 02.12.2022

Úg.	Dags.	Skýring	Br.af:	Yfirf.
A	02.12.2022	Verktækning	GES	Art
B	03.02.2023	Tekning upplærd	GES	Art

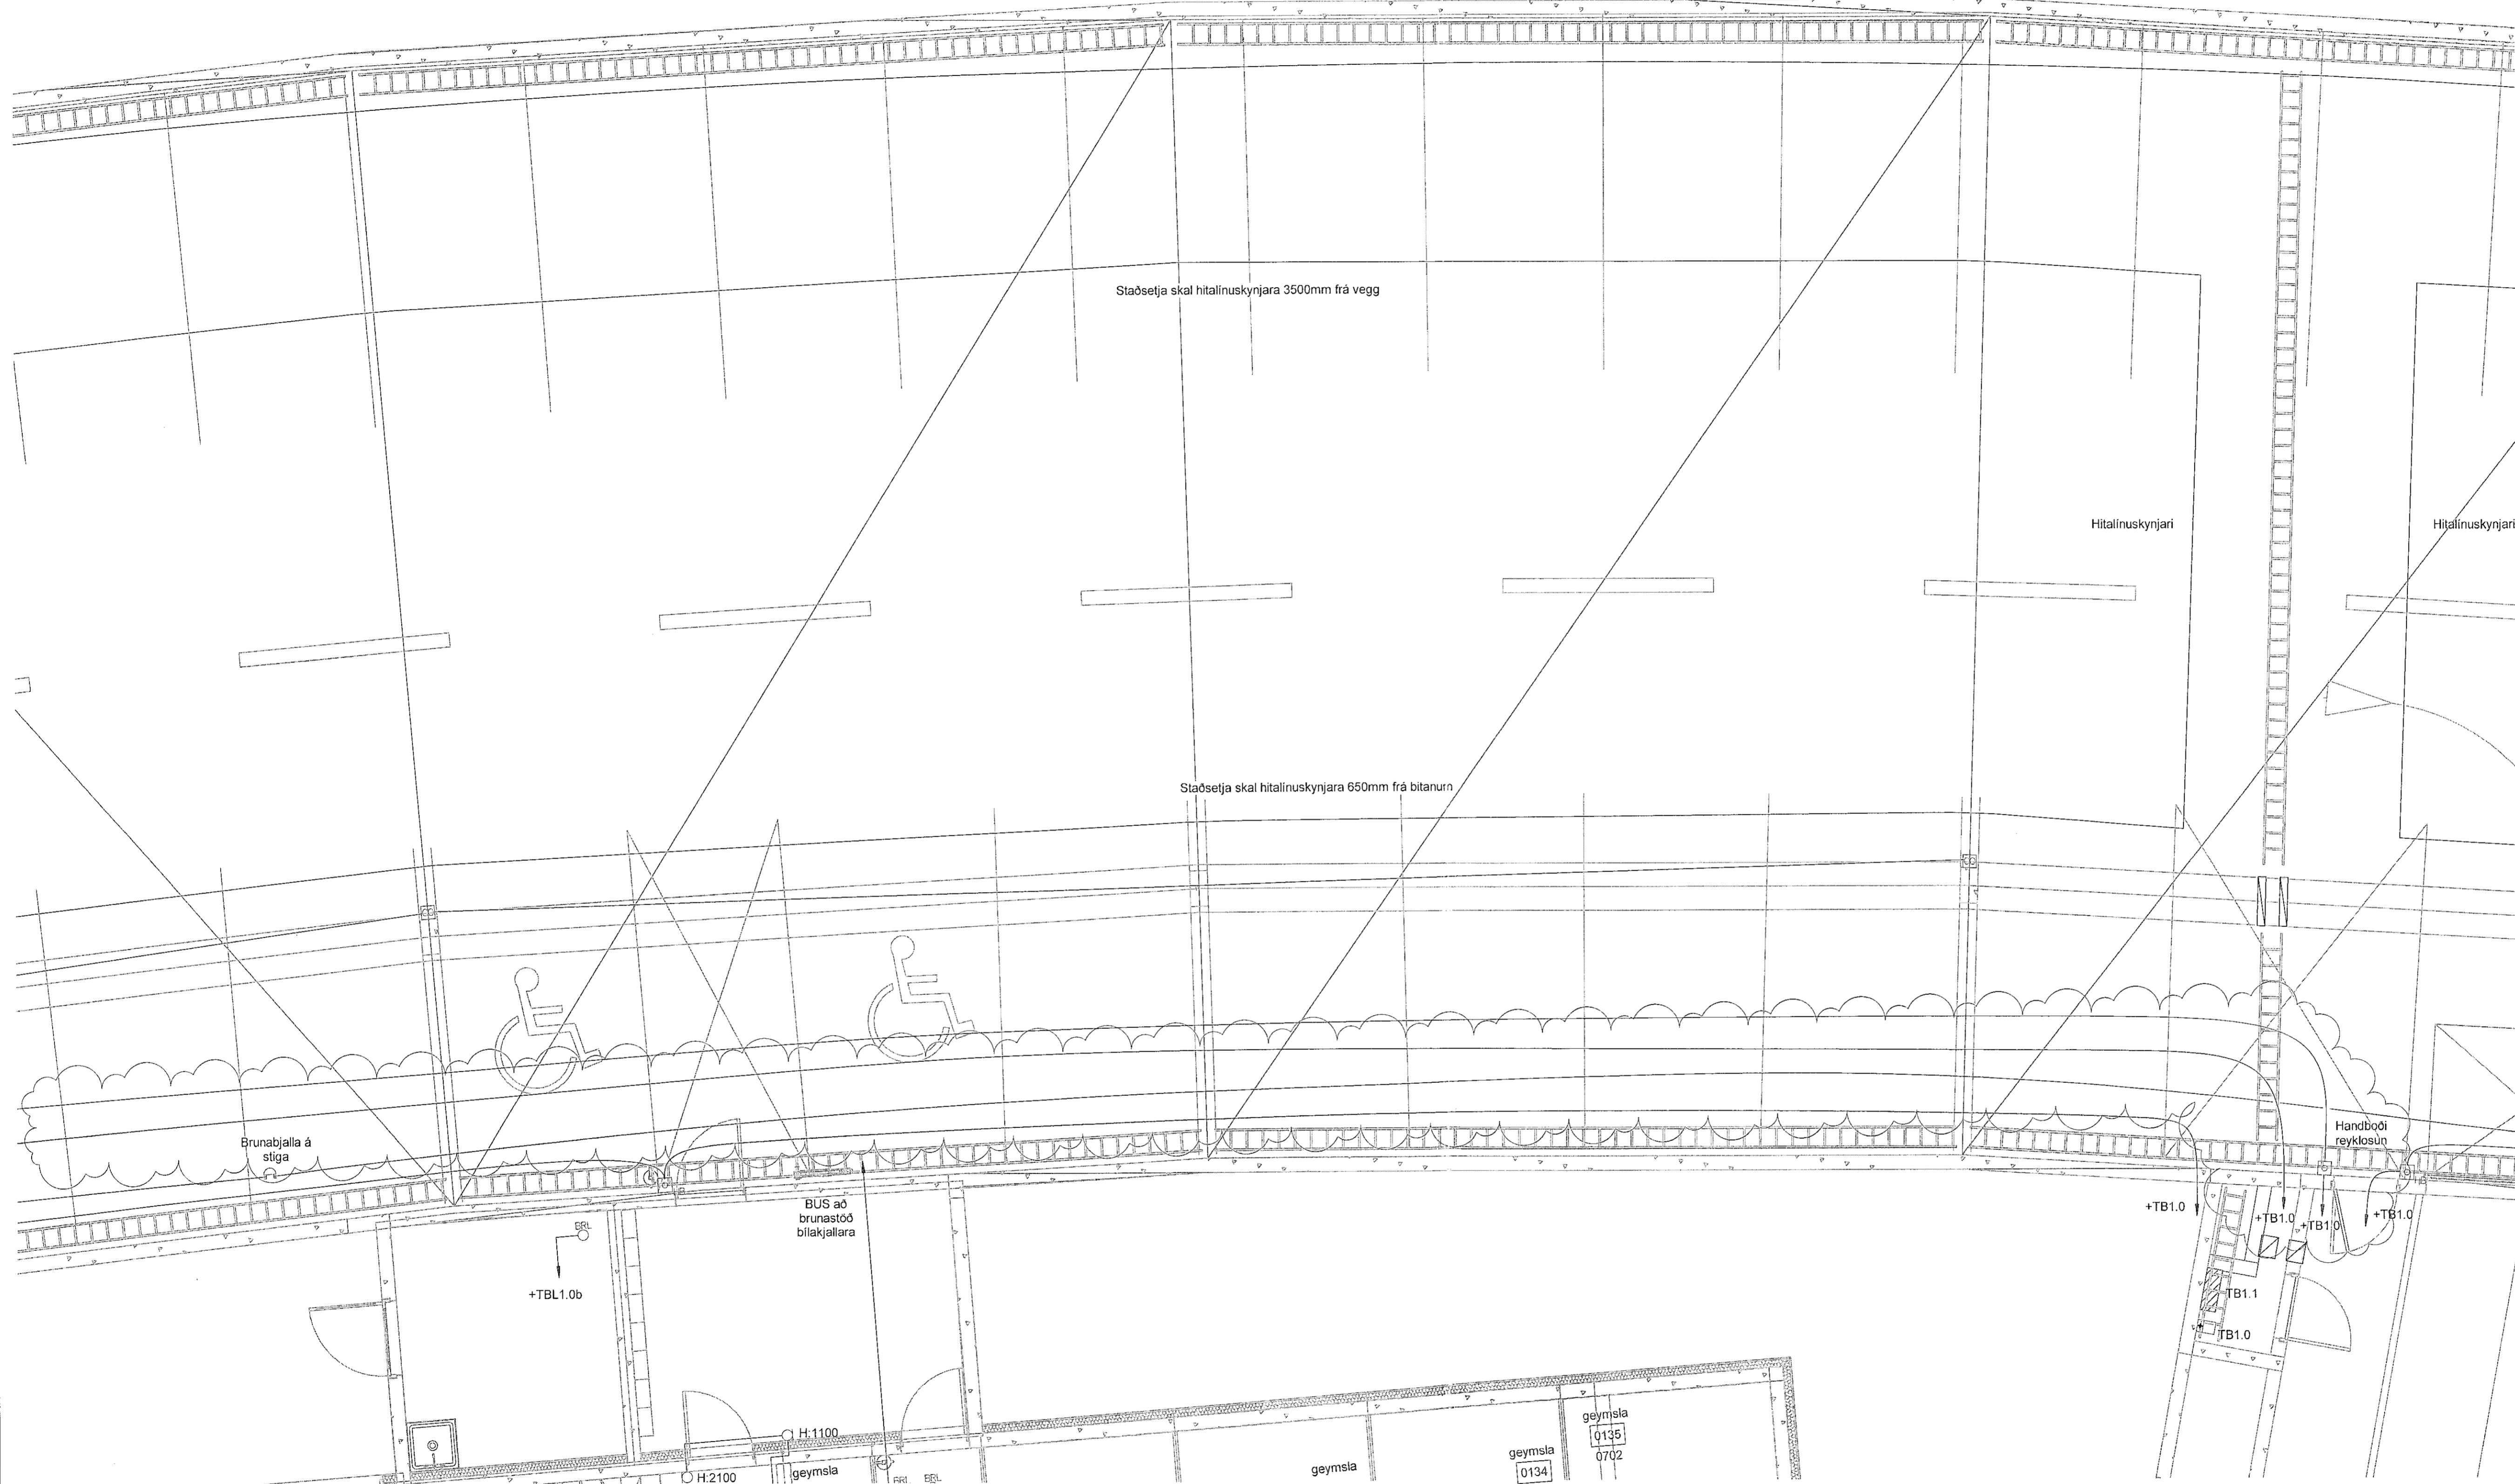

Hringhamar Bilahús
221 Hafnarfjörður

Rafkerfi
Smáspenna
0.hæð, hluti 3

TEKNIÐMÉR	BLAÐSTÆÐ	HANNAÐ	GES/ÞWM
9354-001	A1	TEIKNAD	LRR
00_3_30_93		YFIRFARND	Art
DAGS	MÁLKVAFDI	ÚTGAFA	
02.12.2022	1 : 50	B	