



Vísat: 17.10.2022 08:26:11 Úpgeftur: 01.09.2022

Útg.	Daga.	Skýring	Br. af: Yfirf.
A	01.09.2022	Verkþekning	GES / Ari
B	07.10.2022	Teikning upplærd	GES / Ari
C	17.10.2022	Teikning upplærd	GES / Ari

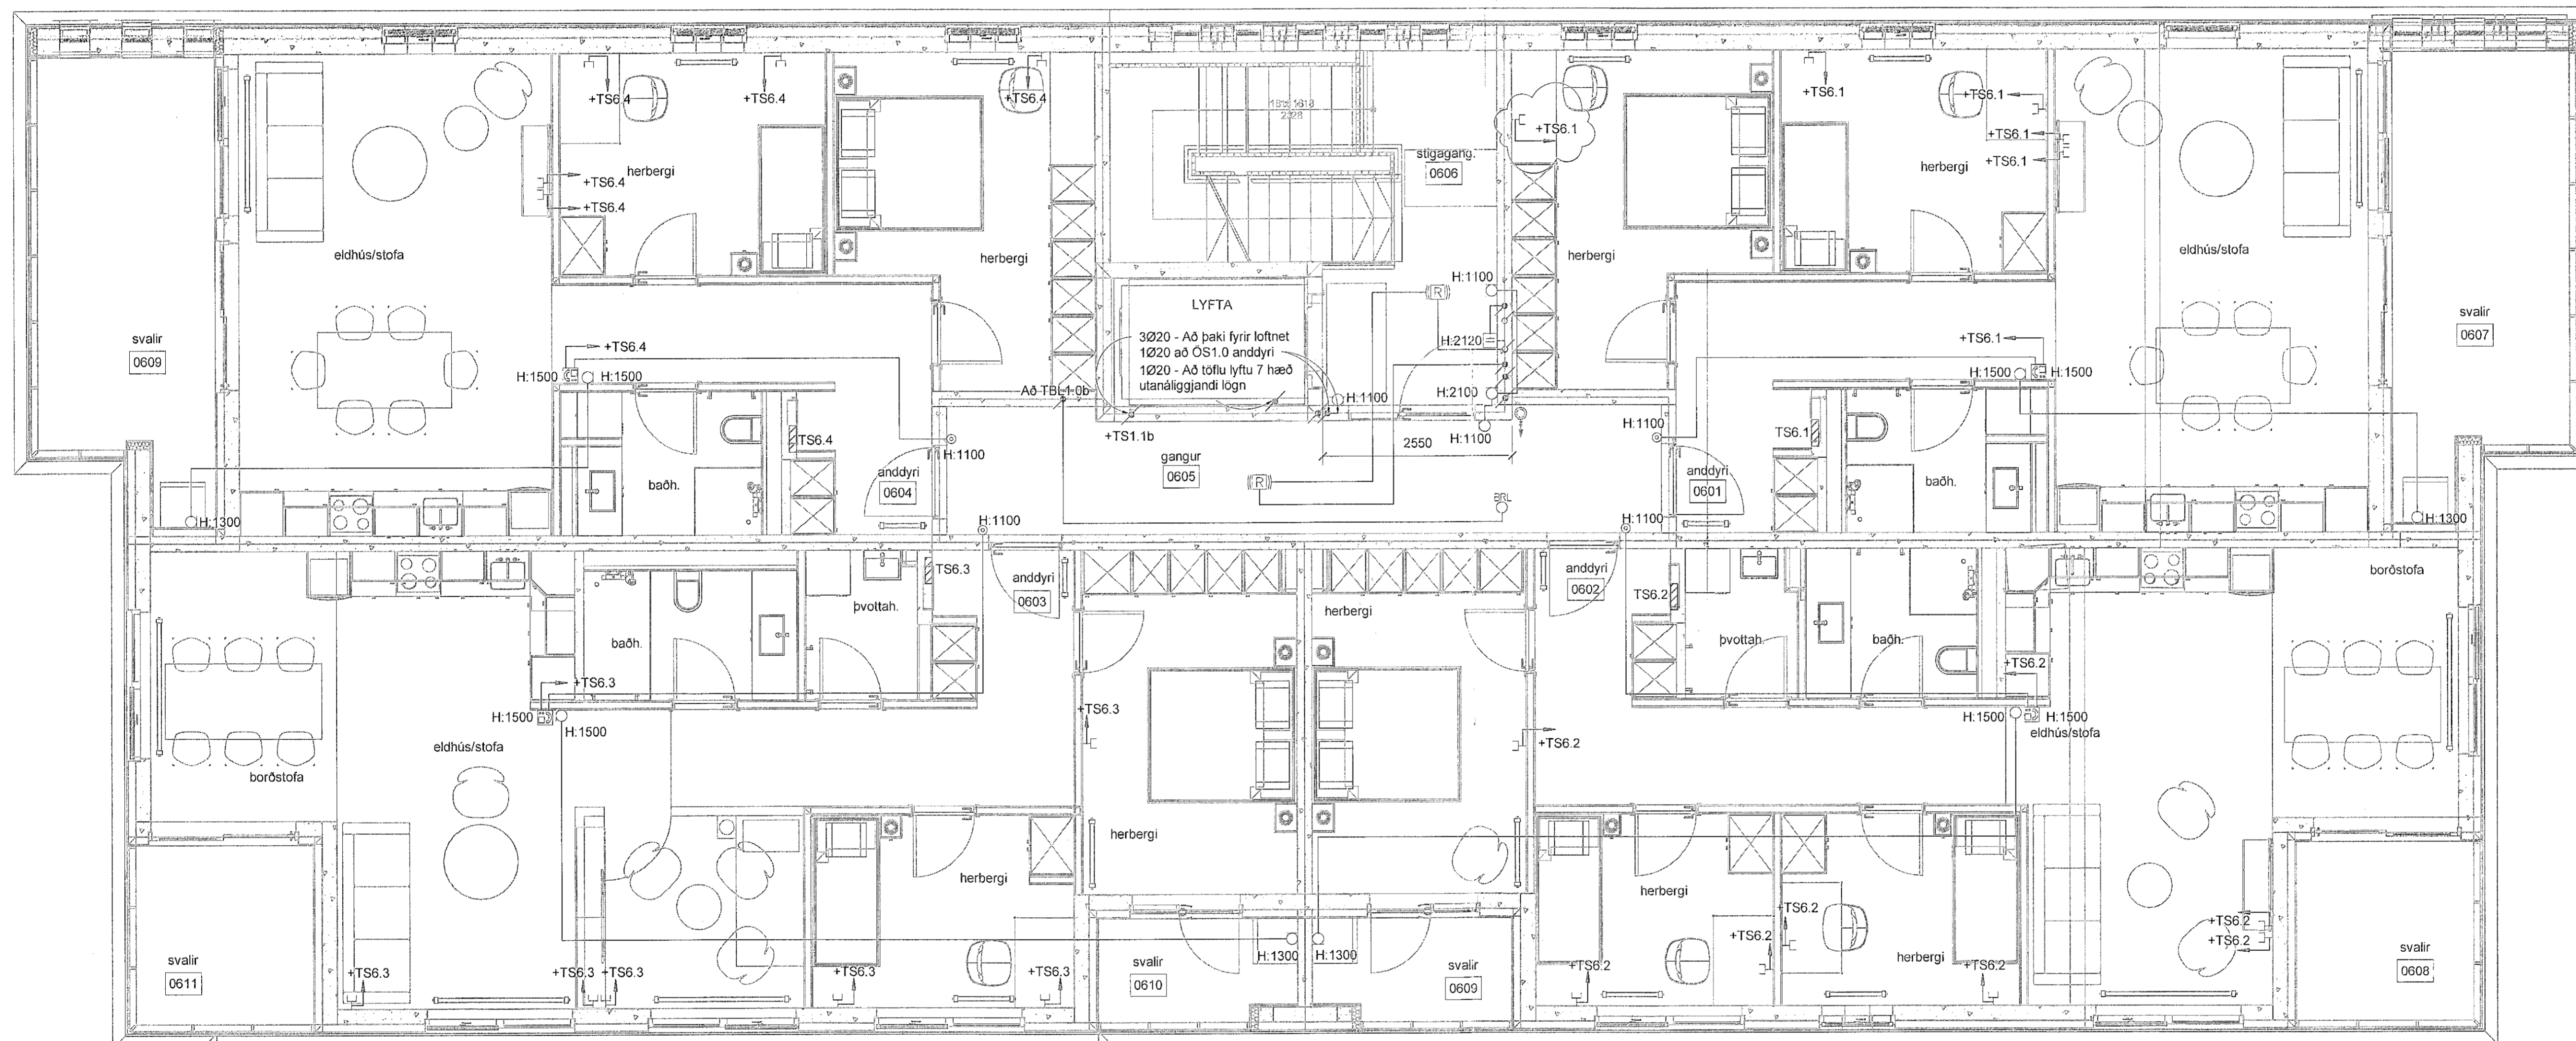

- 31_Fjarskiptakerfi**
- ⊥ Tölvutengill einfaldur
 - ⊥ Tölvutengill tvöfaldr
 - Tengidós, vegg eða stiga
 - Tengidós loft
 - ↻ Lögn fer niður
 - ↻ Lögn fer upp
 - ↻ Lögn fer upp og niður
 - OS: Oruggt Svæði

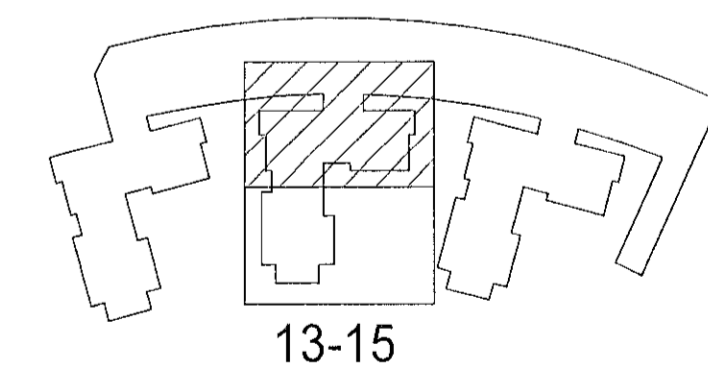

Hringhamar 13-15
221 Hafnarfjörður

Rafkerfi
Smáspenna
6.hæð, hluti 1

TEKNIÐMÉR	BLAÐSTJÓRN	HANNAÐ	GES/ÞW/M
9354-001	A1	TEKNAÐ: LRR	
06_3_30_11		YFRIFAR: Ari	
DAGS	MELKVÆÐI	ÚTGAFA	
01.09.2022	1 : 50	C	

Útgáfunúmer og dagsetning aðalútgáfu: Frumútgáfa 12.04.2022
Höfundur: Gunnar Egill Sveinsson kt. 220481-5589
Hönnunarsjóni: Haraldur Ingvarsson kt. 030996-3389

