



Samþykkt þann
 15. mars 2022
 f.h. byggingarfulltrúans í Hafnarfirði
 Hjalmar A. Jónsson
 T-R-3

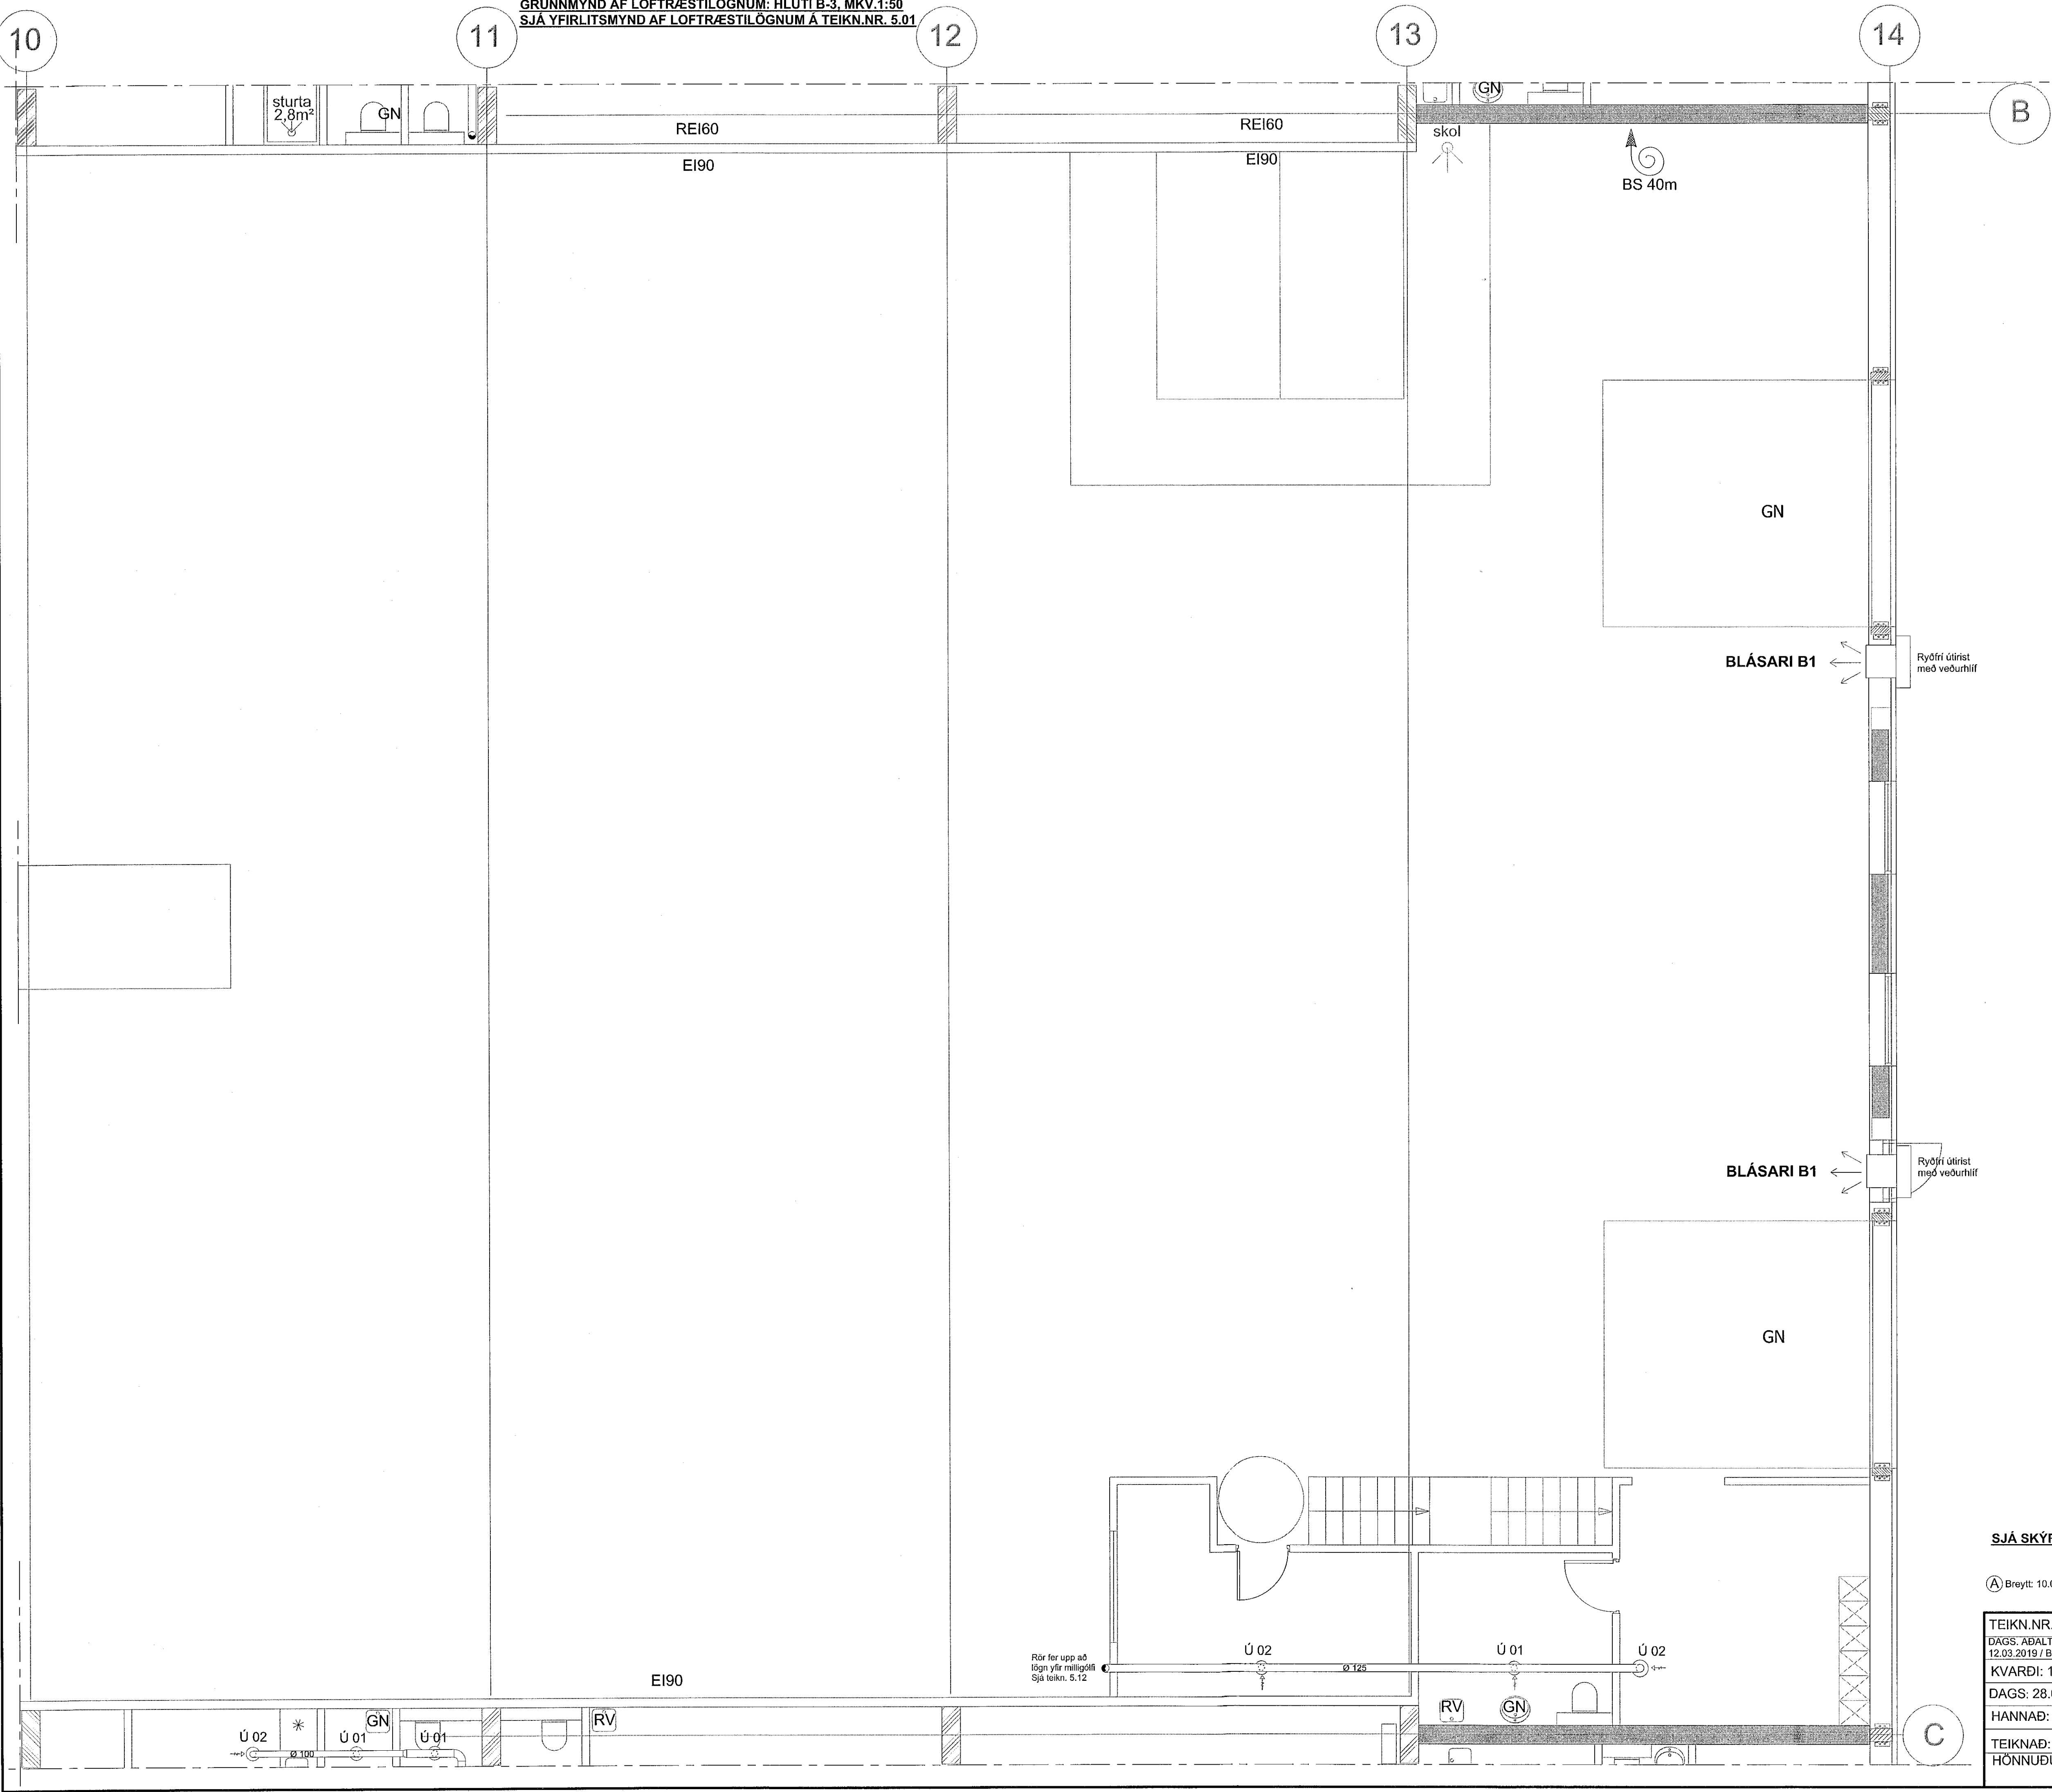

LYKILMYND 1:1000

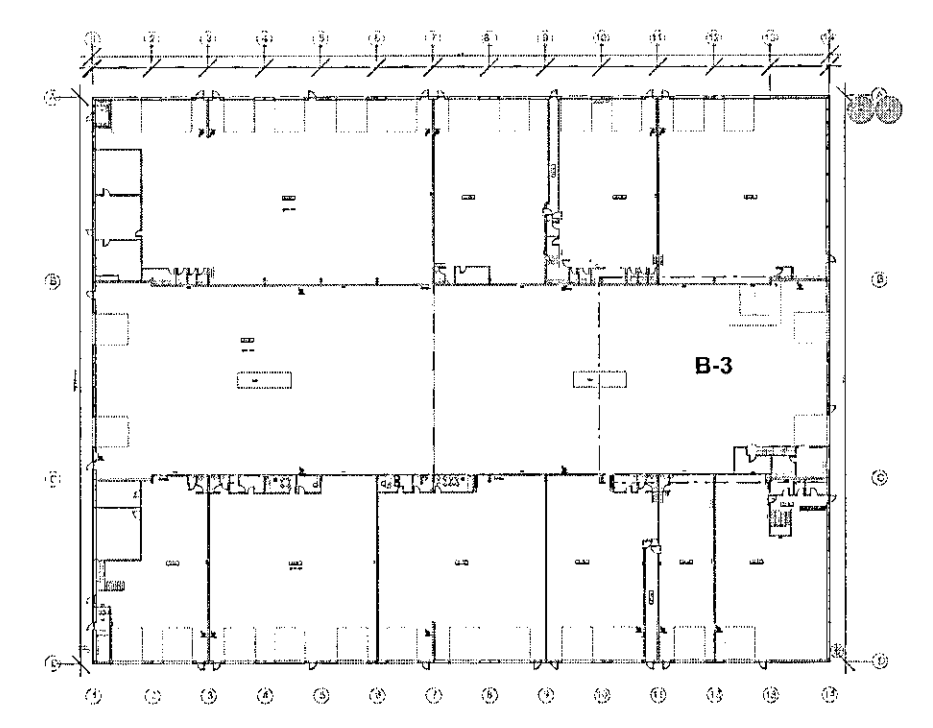

SJÁ SKÝRINGAR Á TEIKNINGU NR. 5.00

(A) Breytt: 10.03.2022. *[Signature]* (Breyttar Aðalteikningar og reyndarteikning framkvæmdar)

TEIKN.NR. 5.07	 Tæknivangur ehf. KT 450595-1889 Kirkjustétt 26, 113 Reykjavík Sími: 564 22 44, Netf. tv@vortex.is
DAGS. AÐALTEIKNINGA: 12.03.2019 / Br. 16.02.2022	
KVARDI: 1:50	
DAGS: 28.06.2019	
HANNAÐ: MG	VERKEFNI: ÍSHELLA 1 Í HAFNARFIRÐI
TEIKNAD: MG	LOFTRÆSTING: GRUNNMYND AF LOFTRÆSTILOGNUM, HLUTI B-3
HÖNNUÐUR: <i>[Signature]</i> Mag/MS Gylfason 410251-4139	Undirskrift Hönnunarstjóra: <i>[Signature]</i> 11.09.162-3599