



Samþykkt þann  
 15. mars 2022  
 F.h. byggingarfulltrúna í Hafnarfirði  
 Hjálmar A. Jónsson  
 1-22-3

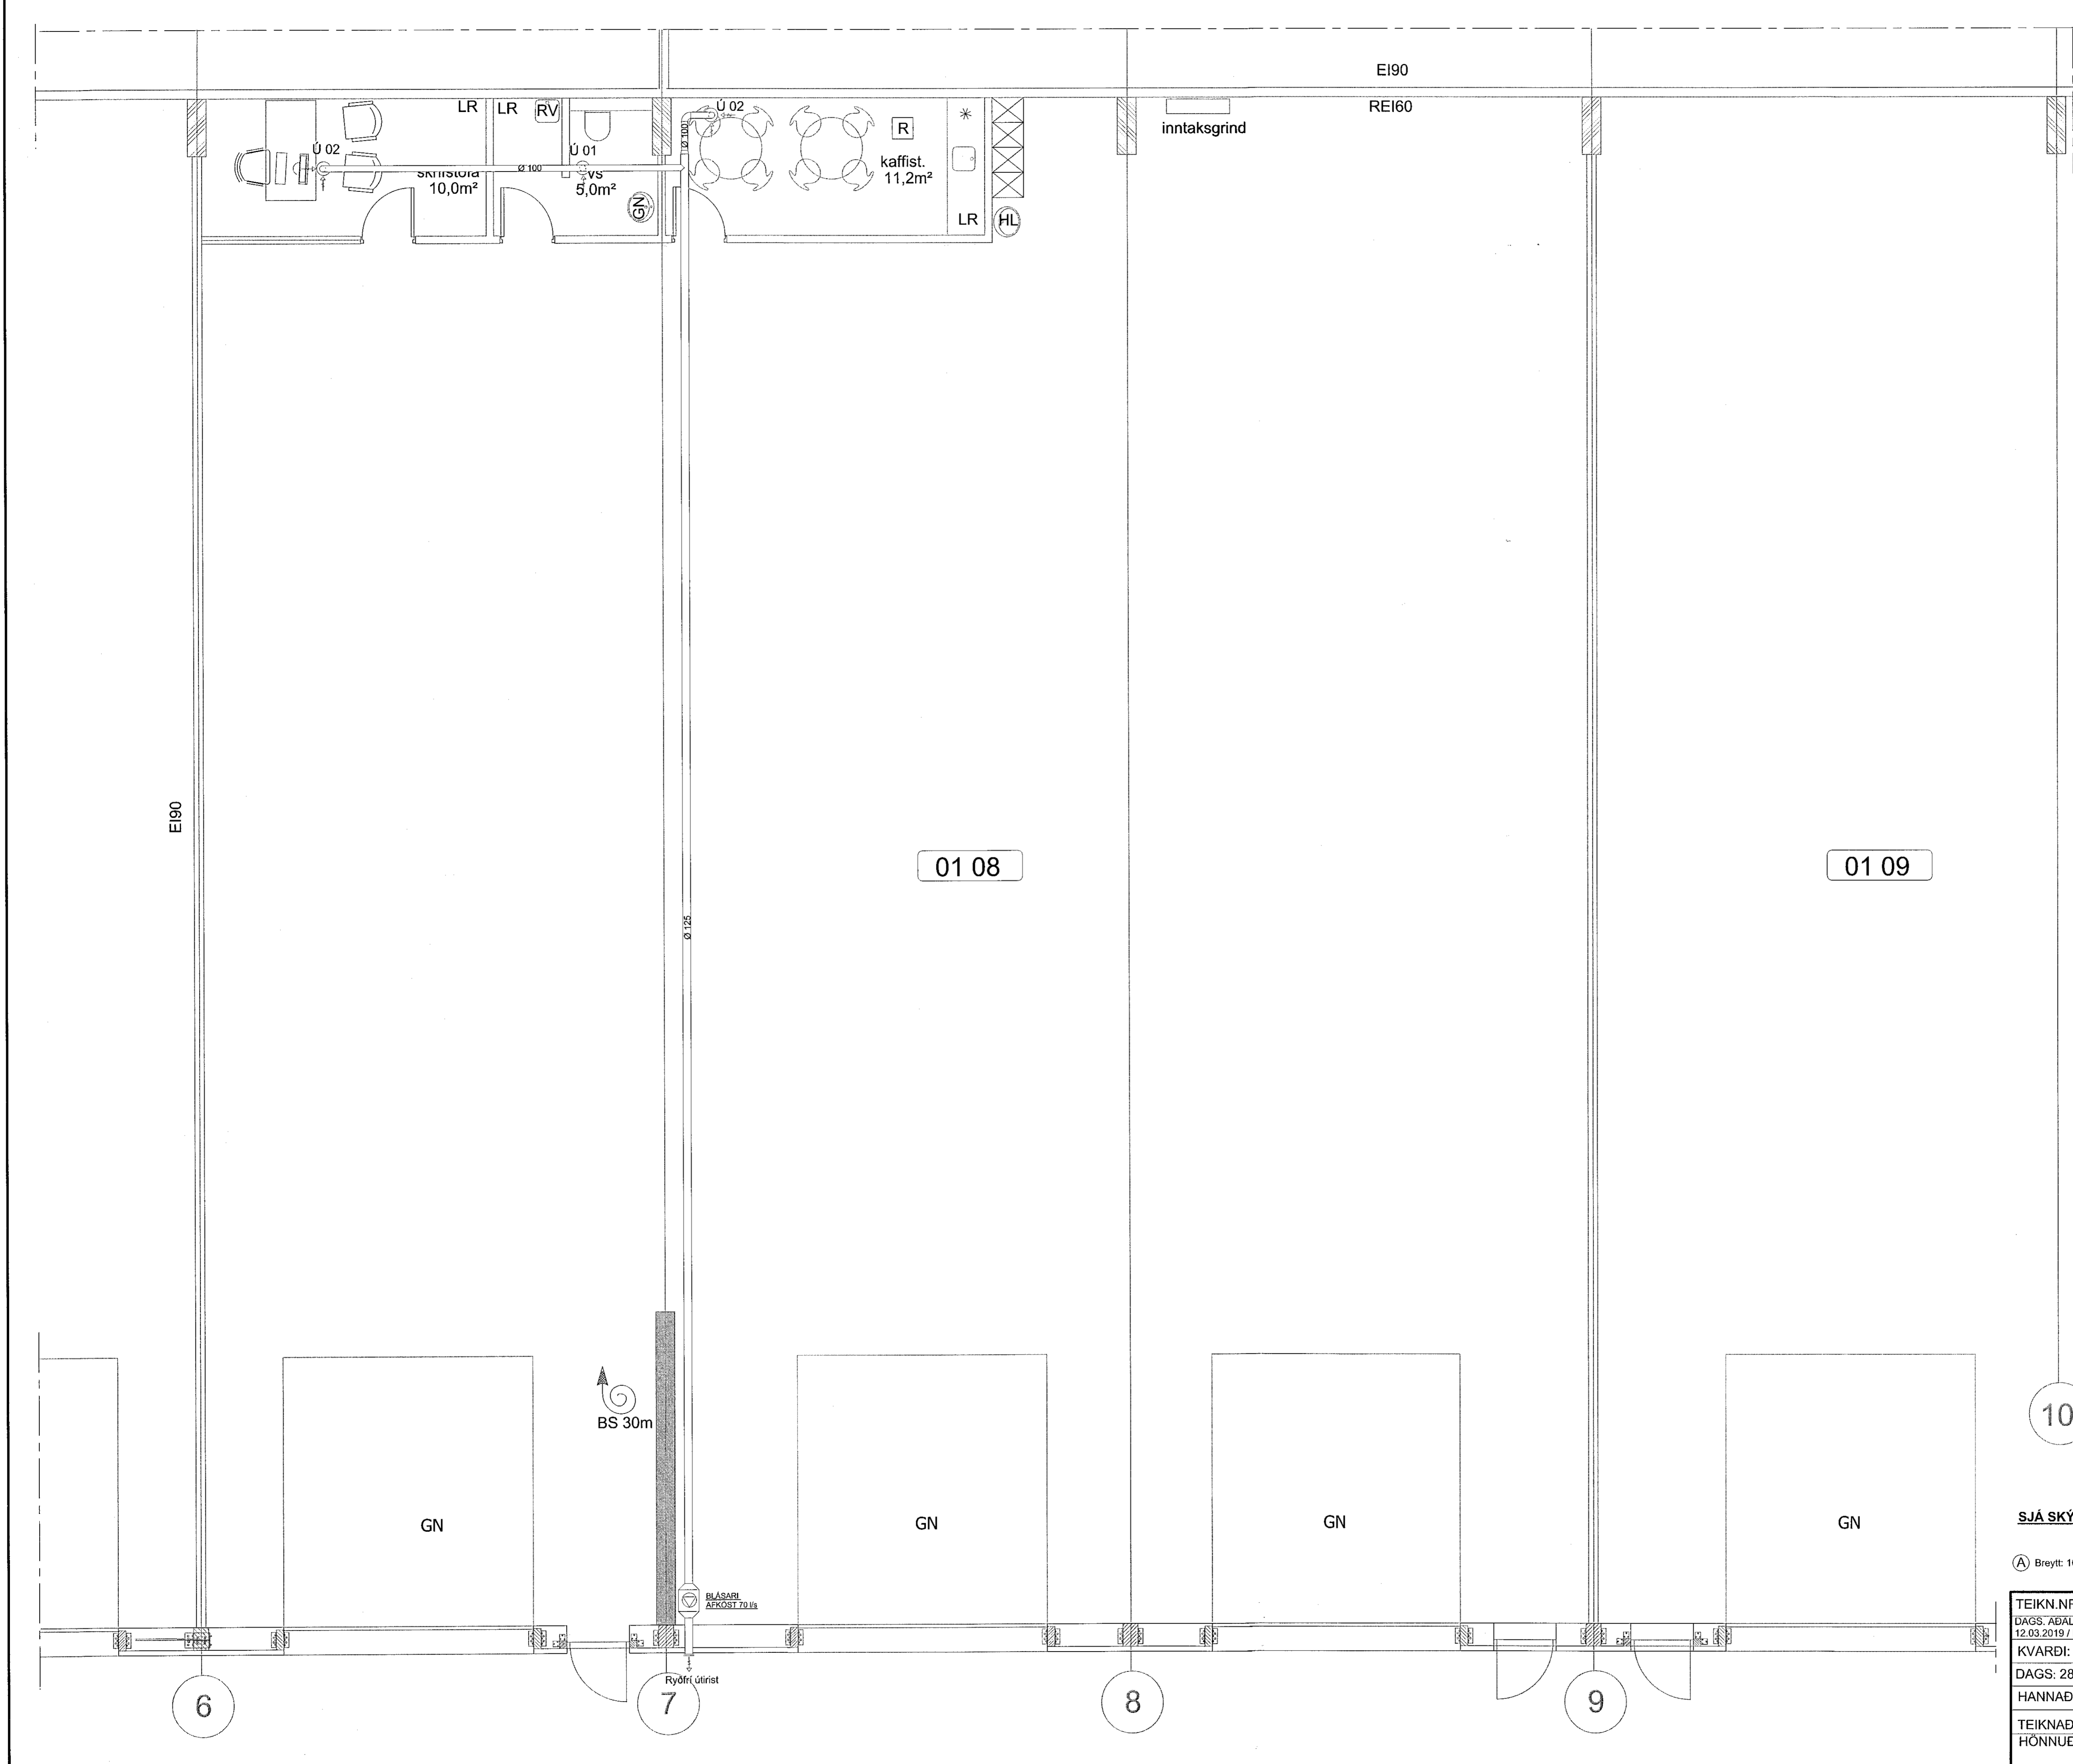

LYKILMYND 1:1000

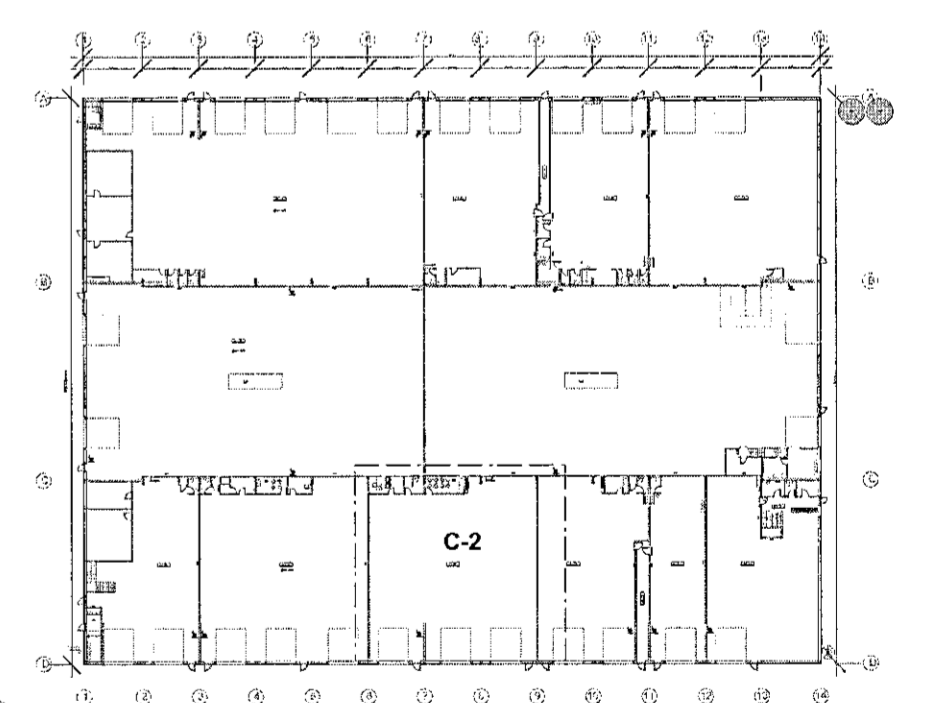

10

SJÁ SKÝRINGAR Á TEIKNINGU NR. 5.00

(A) Breytt: 10.03.2022 (Breyttar Aðalleikningar og reyndarteikning framkvæmdar)

TEIKN.NR. 5.09	 Tæknivæðing ehf. Kt. 450686-1889 Kirkjústétt 26, 113 Reykjavík Sími: 594 22 44, Netf. tv@vortex.is
DAGS. AÐALTÆIKNINGA: 12.03.2019 / Br. 16.02.2022	
KVARDI: 1:50	
DAGS: 28.06.2019	
HANNAD: MG	VERKEFNI: ÍSHELLA 1 Í HAFNARFIRÐI
TEIKNAD: MG	LOFTRÆSTING: GRUNNMYND AF LOFTRÆSTILÖGNUM, HLUTI C-2
HÖNNUÐUR:  Magnús Gylfason 4.201231-3159	 Hönnuð Hönnunarstjóra 4.01182-3559